


AS CONSTRUCTED
CERTIFIED *Jamb*
DATE *6/9/97*

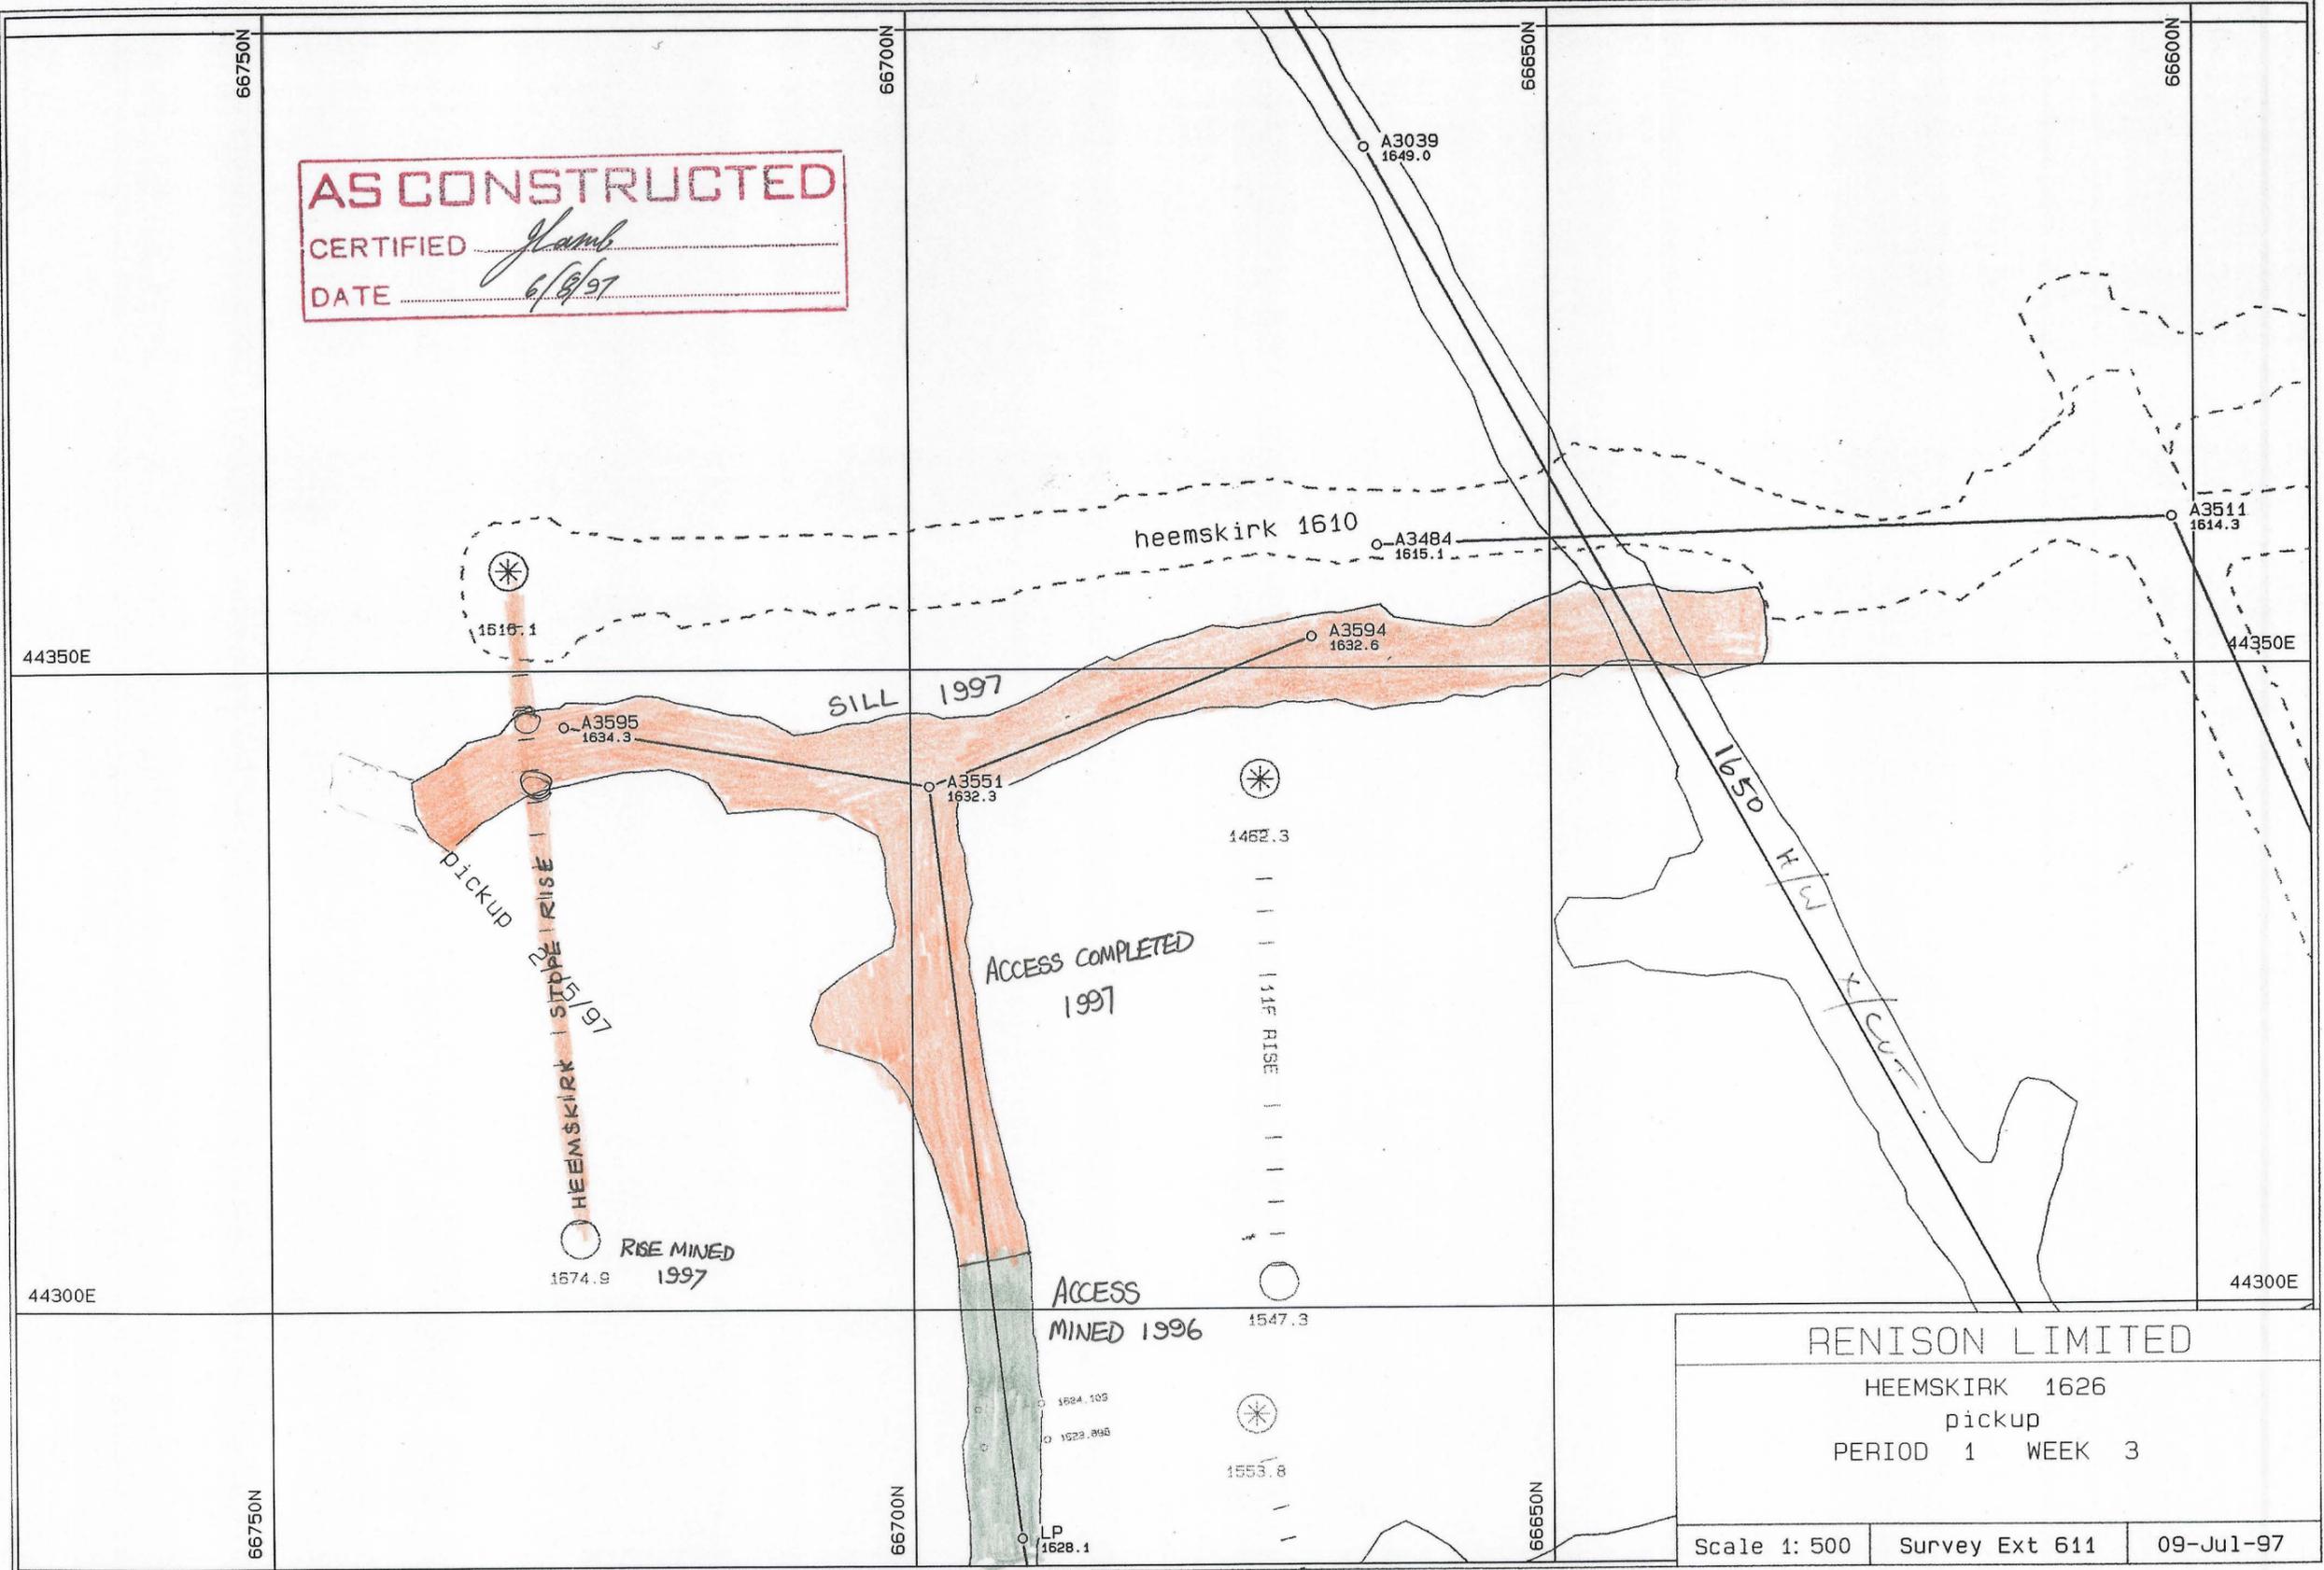

RENISON LIMITED		
HEEMSKIRK 1626 pick up		
PERIOD 1 WEEK 3		
Scale 1: 500	Survey Ext 611	09-Jul-97

heemskir.ic.pf

