

0376\_731

0376\_731

D. V. Mason  
PAS 4996

66350  
E 44400 SALVAGE/DEV/MASTER

N 66300

N 66200

N 66200

E 44400


E 44350

E 44350

**AS CONSTRUCTED**  
CERTIFIED *J. Lamb*  
DATE *23/7/97*

*Back of road*

STRIPPING 1996

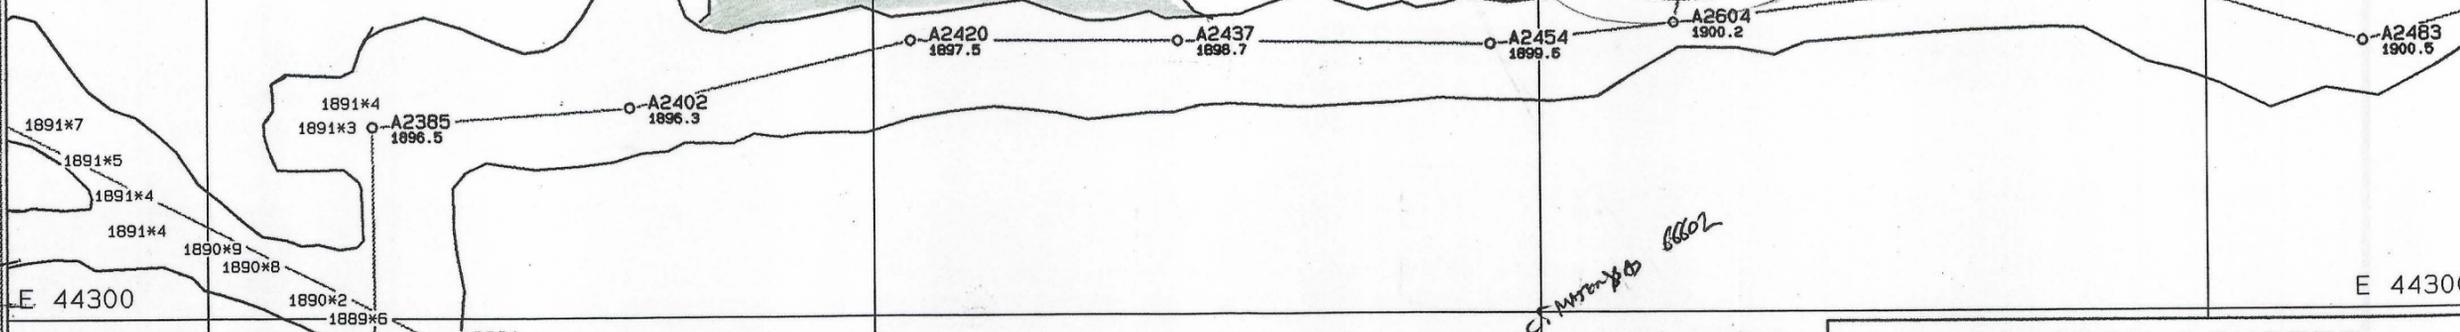

E 44300


E 44300

FLINDA.PF

N 66350

N 66300

N 66250

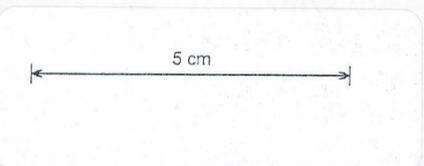

RENISON LIMITED		
Flinders 1890 as at 19-6-96		
WEST COAST SURVEYS PTY LTD		
Scale 1: 500	Survey Ext 611	20-JUN-96