


0376_732

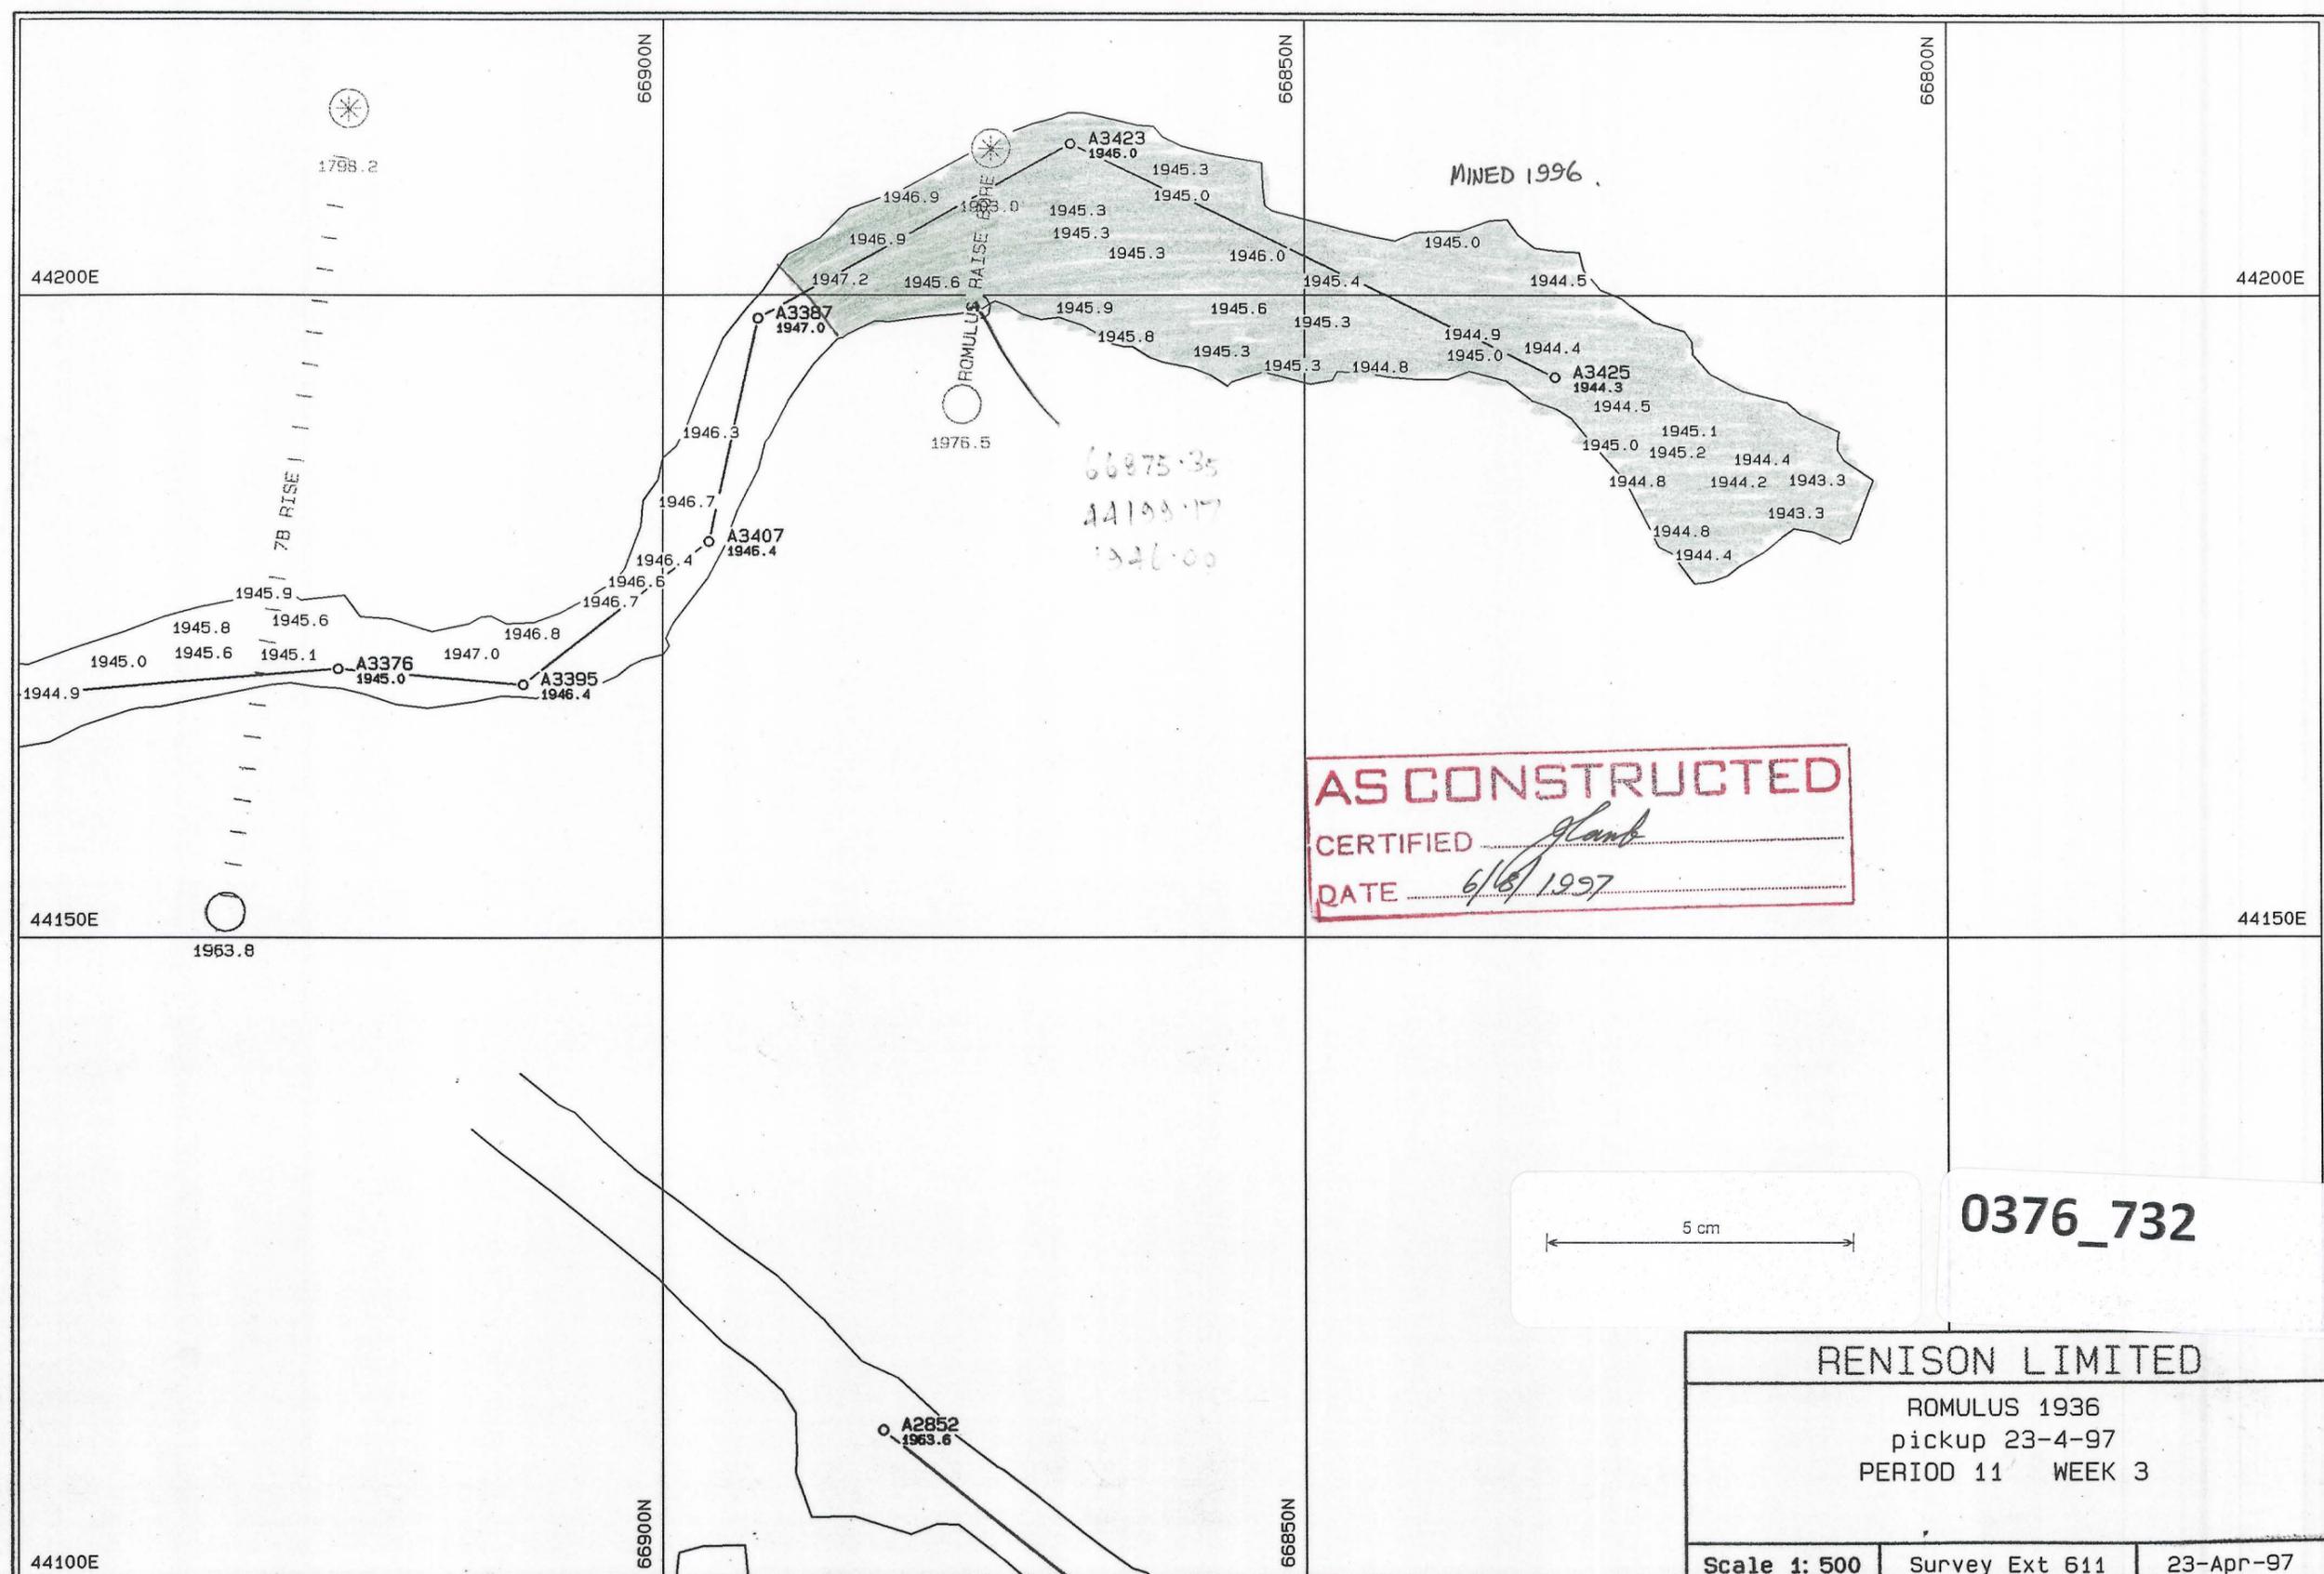

0376_732

RENISON LIMITED		
ROMULUS 1936 pickup 23-4-97 PERIOD 11 WEEK 3		
Scale 1: 500	Survey Ext 611	23-Apr-97

romulush.pf