


0376_733

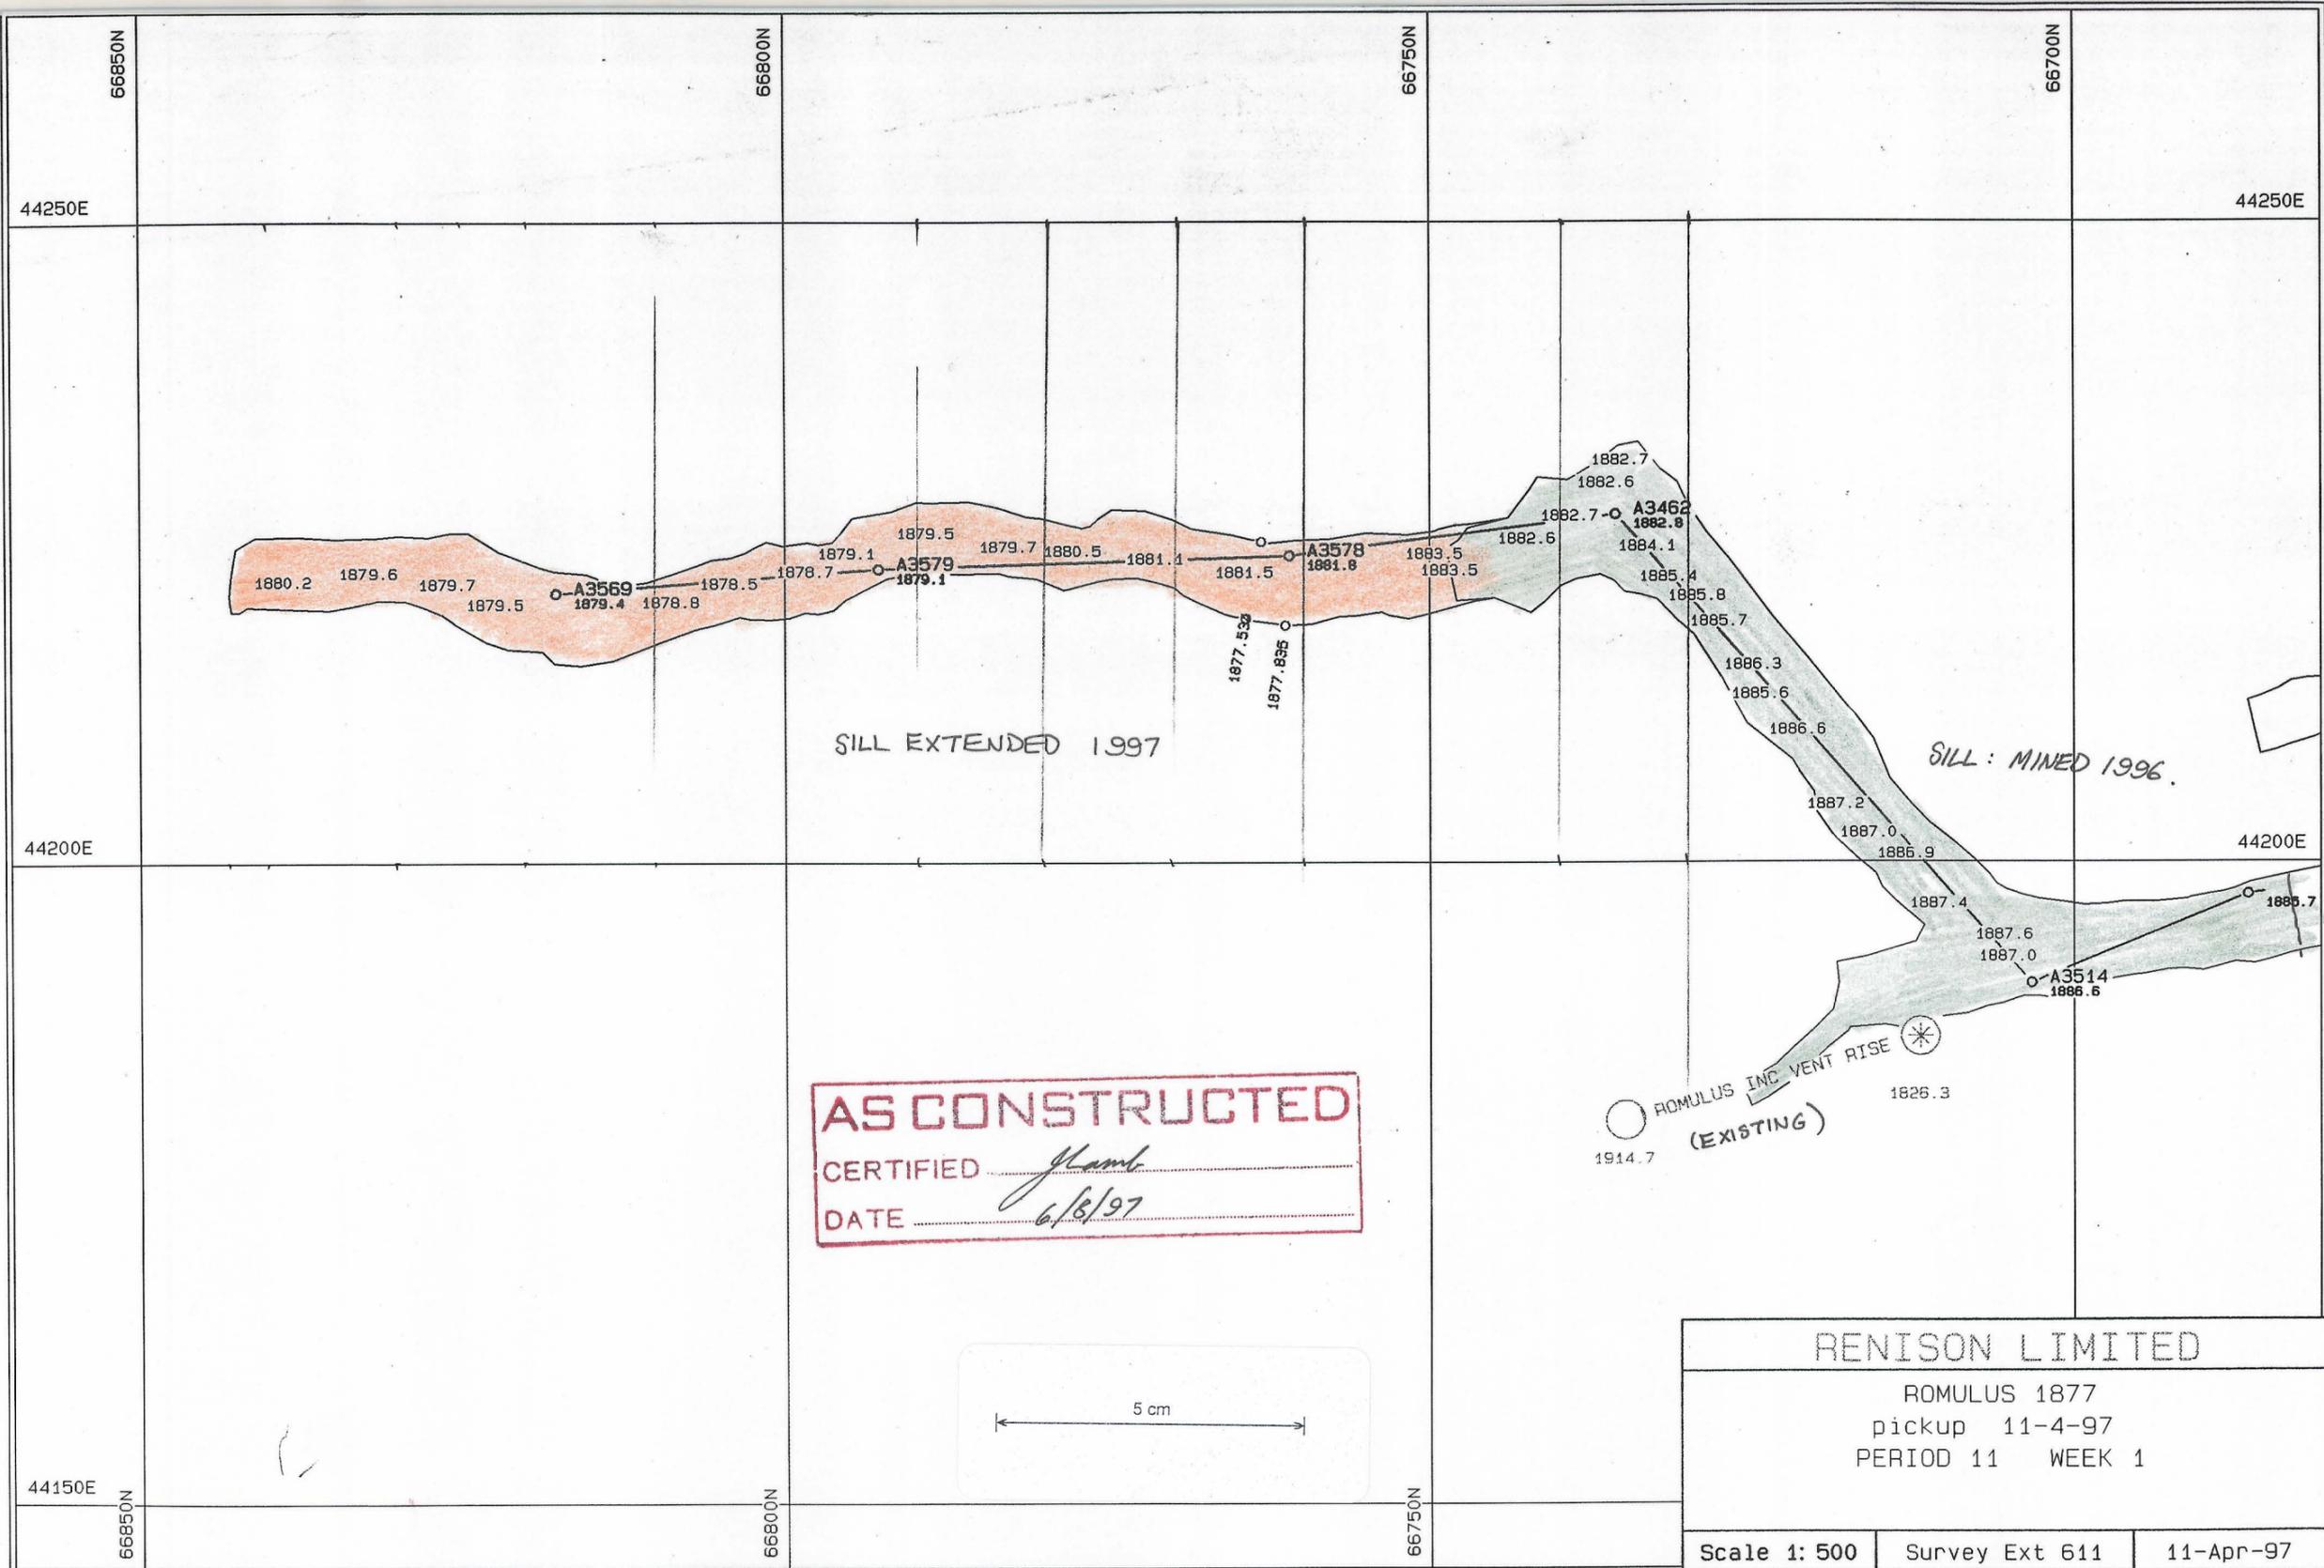

AS CONSTRUCTED
 CERTIFIED *J Lamb*
 DATE *6/8/97*

RENISON LIMITED
 ROMULUS 1877
 pickup 11-4-97
 PERIOD 11 WEEK 1

Scale 1: 500	Survey Ext 611	11-Apr-97
--------------	----------------	-----------

romulusd.pf

0376_733