


0376_734

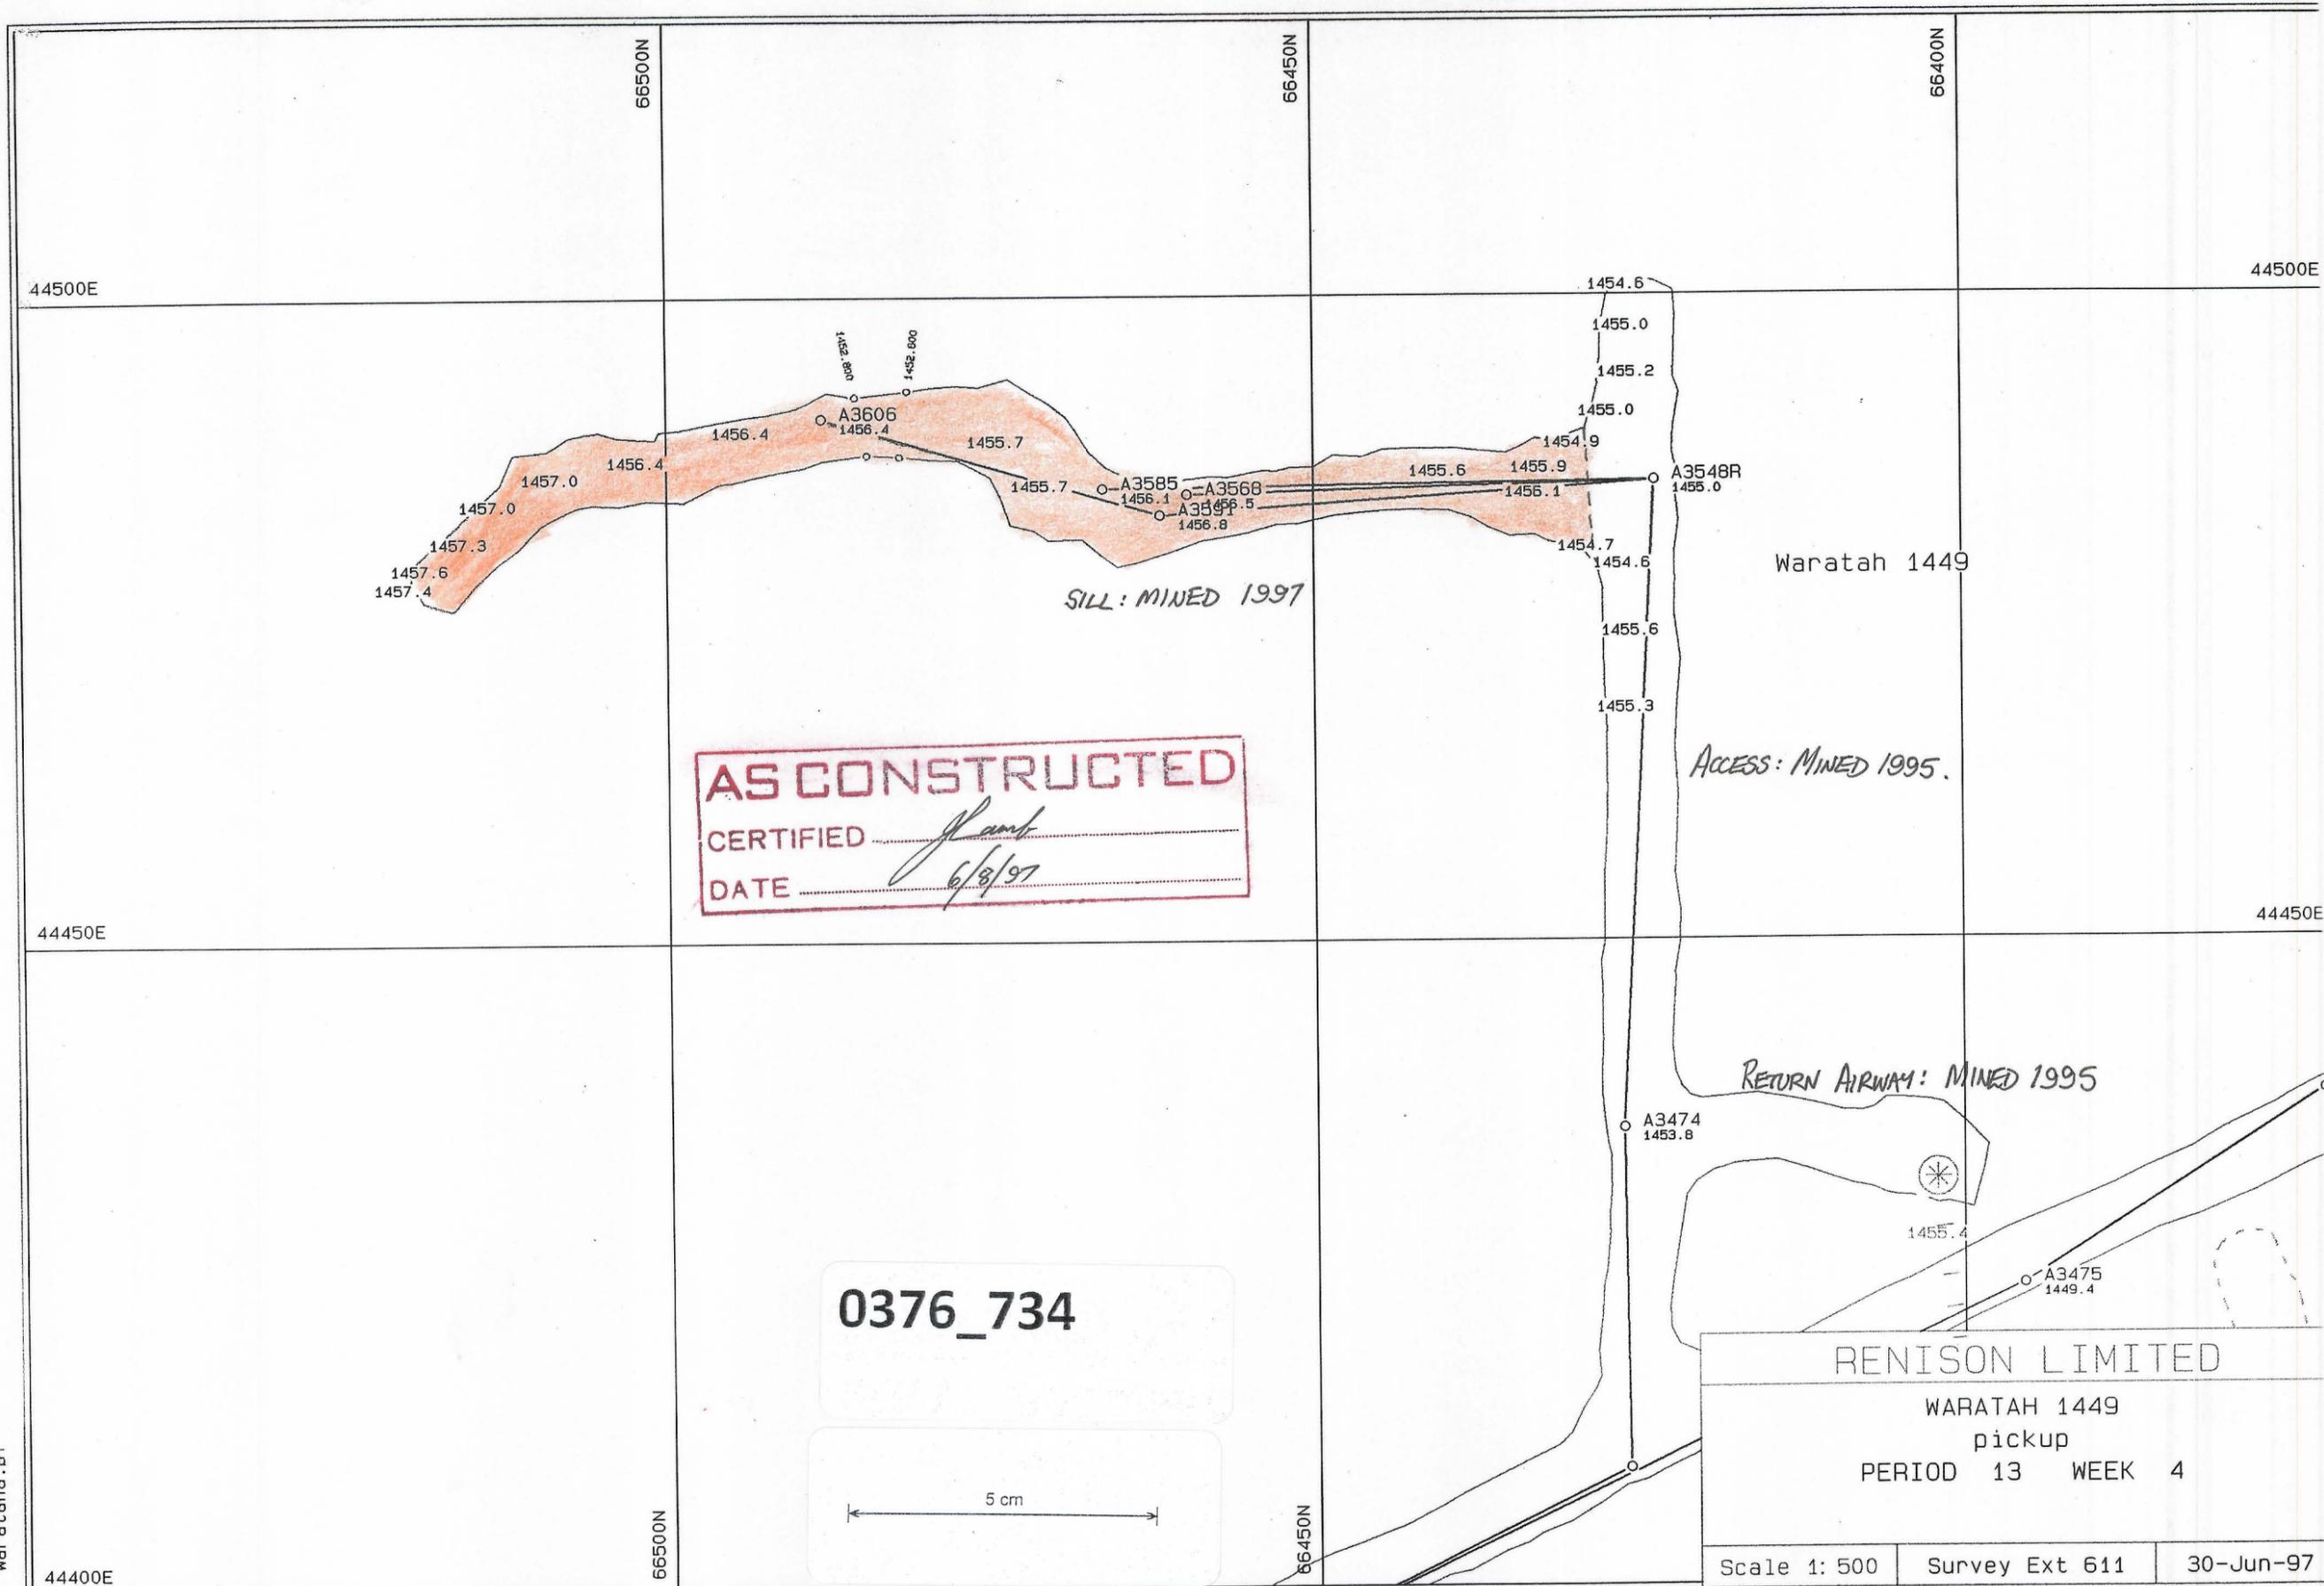

AS CONSTRUCTED
 CERTIFIED *J. Amb*
 DATE *6/3/97*

0376_734

5 cm

RENISON LIMITED
 WARATAH 1449
 pickup
 PERIOD 13 WEEK 4

Scale 1: 500	Survey Ext 611	30-Jun-97
--------------	----------------	-----------

waratana.pf