


0376\_735

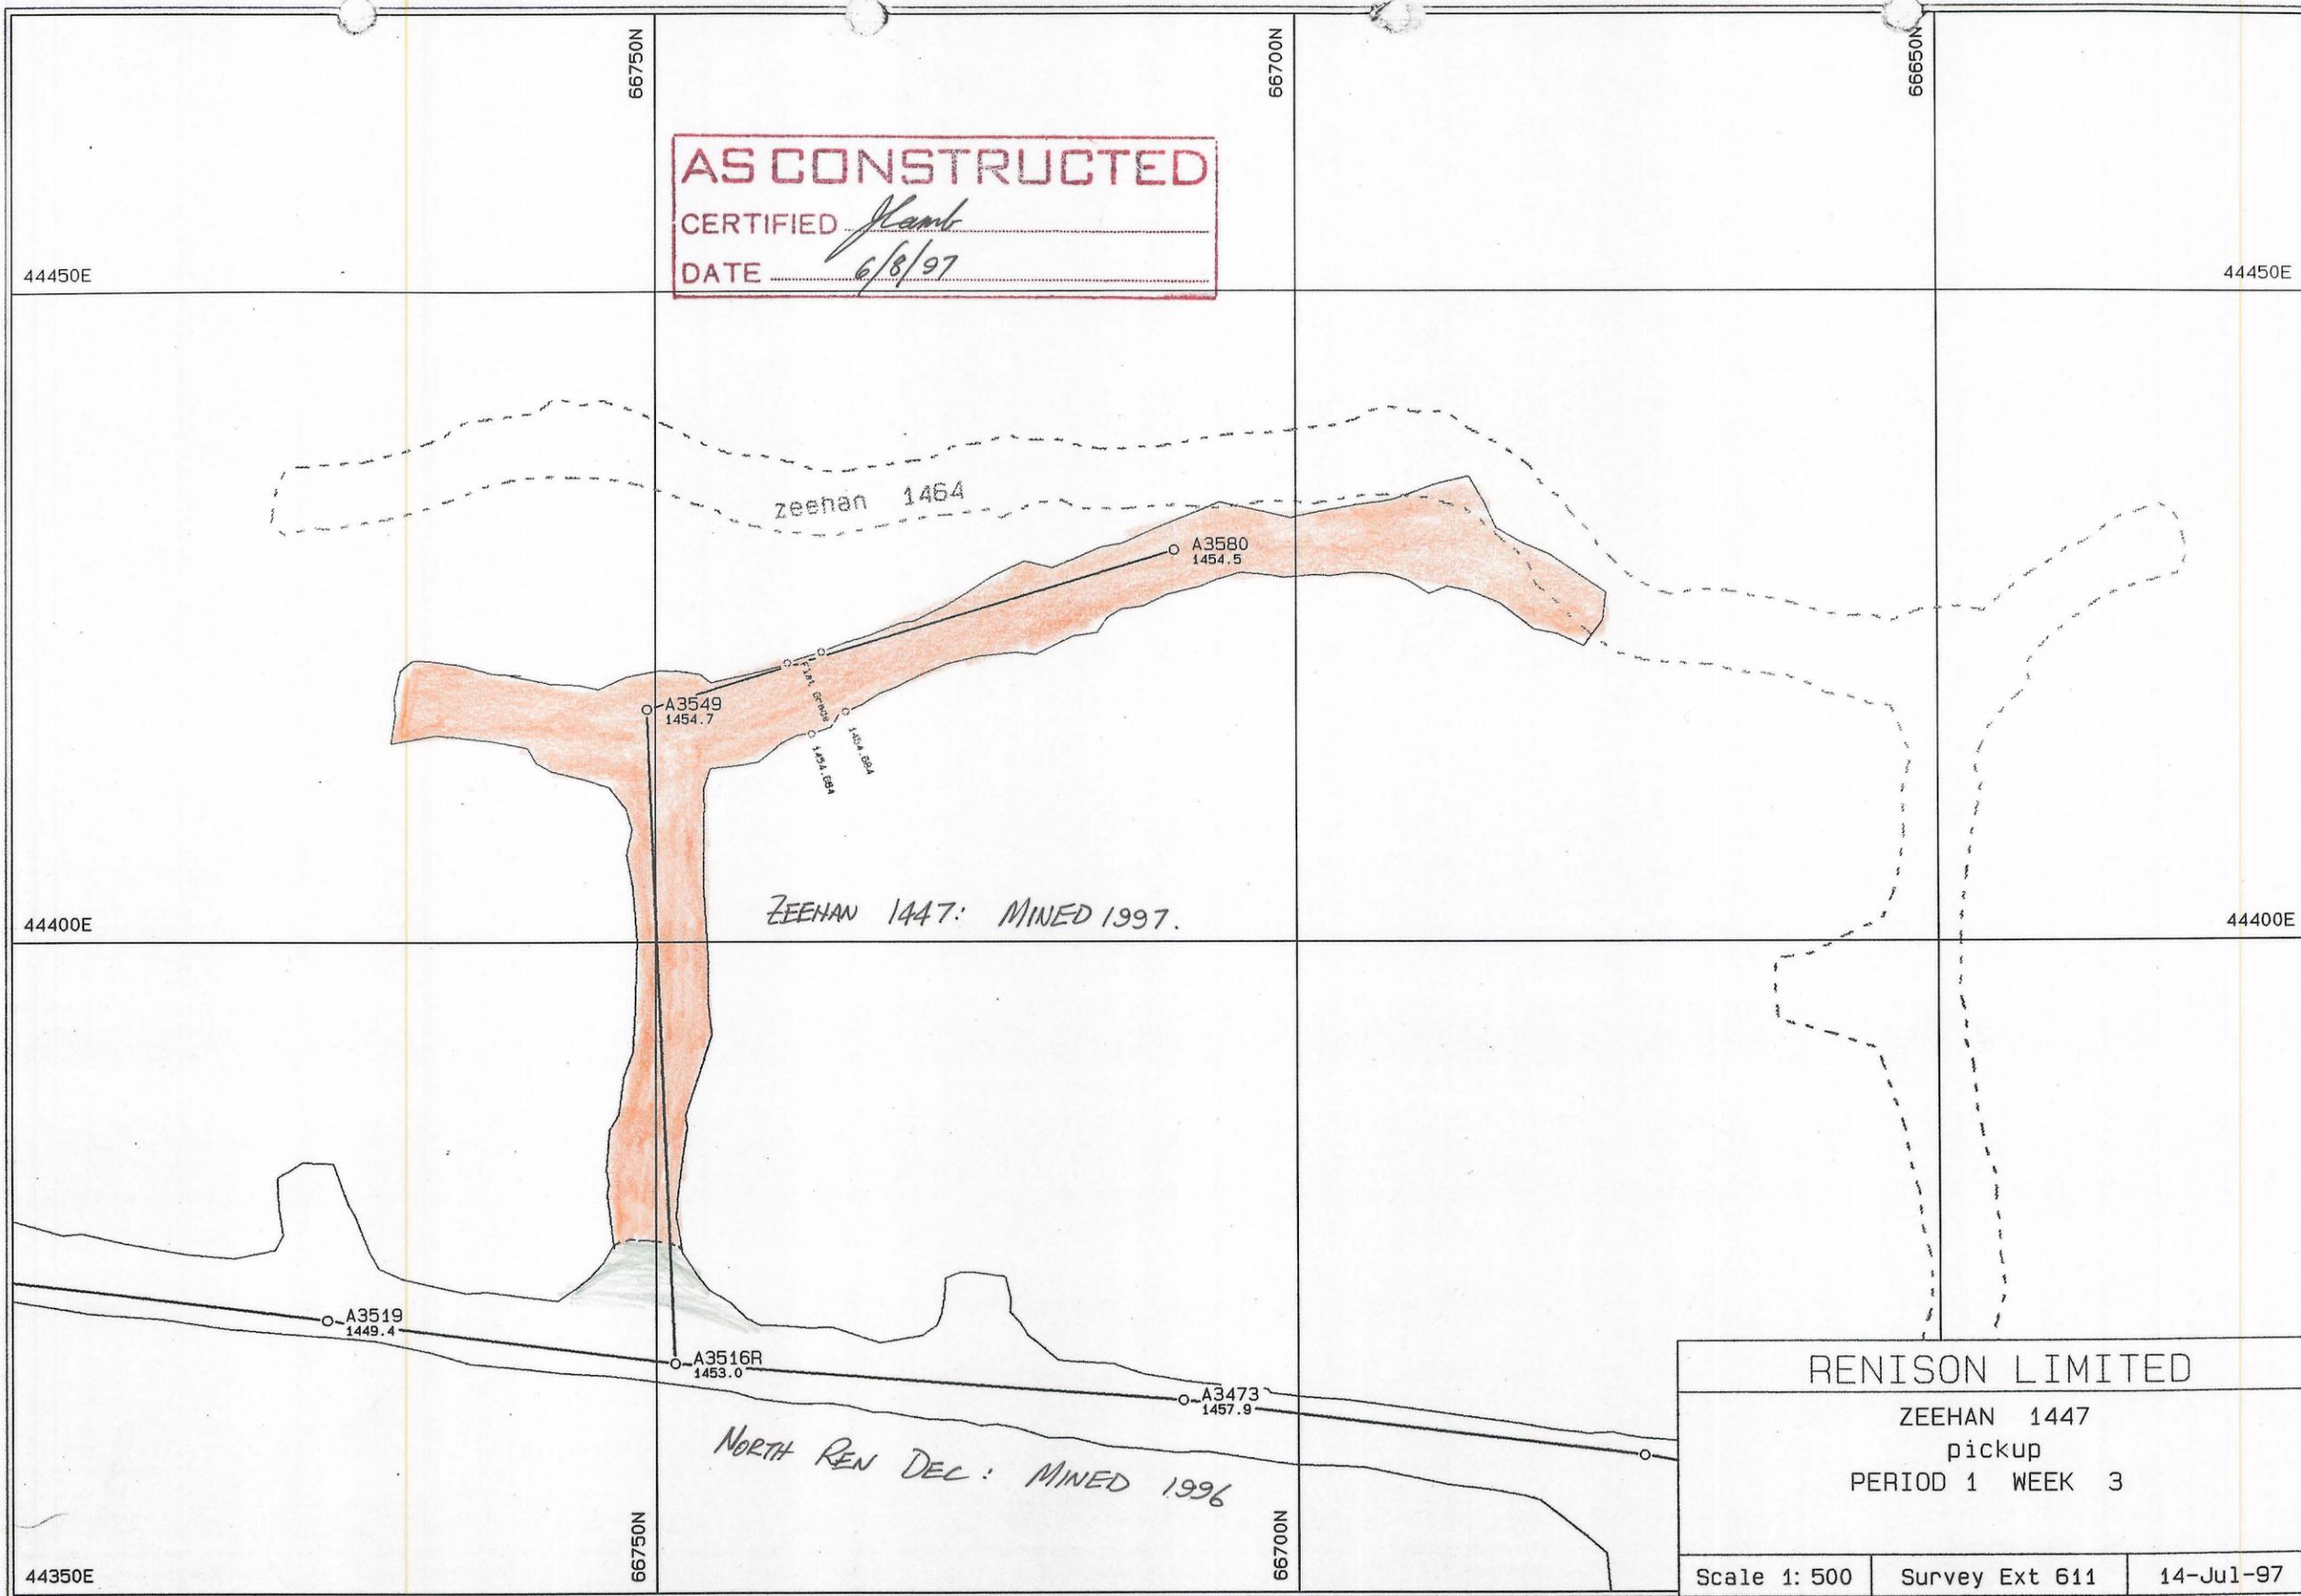

**AS CONSTRUCTED**  
 CERTIFIED *Grant*  
 DATE *6/8/97*

|  |                |           |
|--|----------------|-----------|
| RENISON LIMITED                          |                |           |
| ZEEHAN 1447<br>pickup<br>PERIOD 1 WEEK 3 |                |           |
| Scale 1: 500                             | Survey Ext 611 | 14-Jul-97 |

0376\_735

