


0376\_736

0376\_736

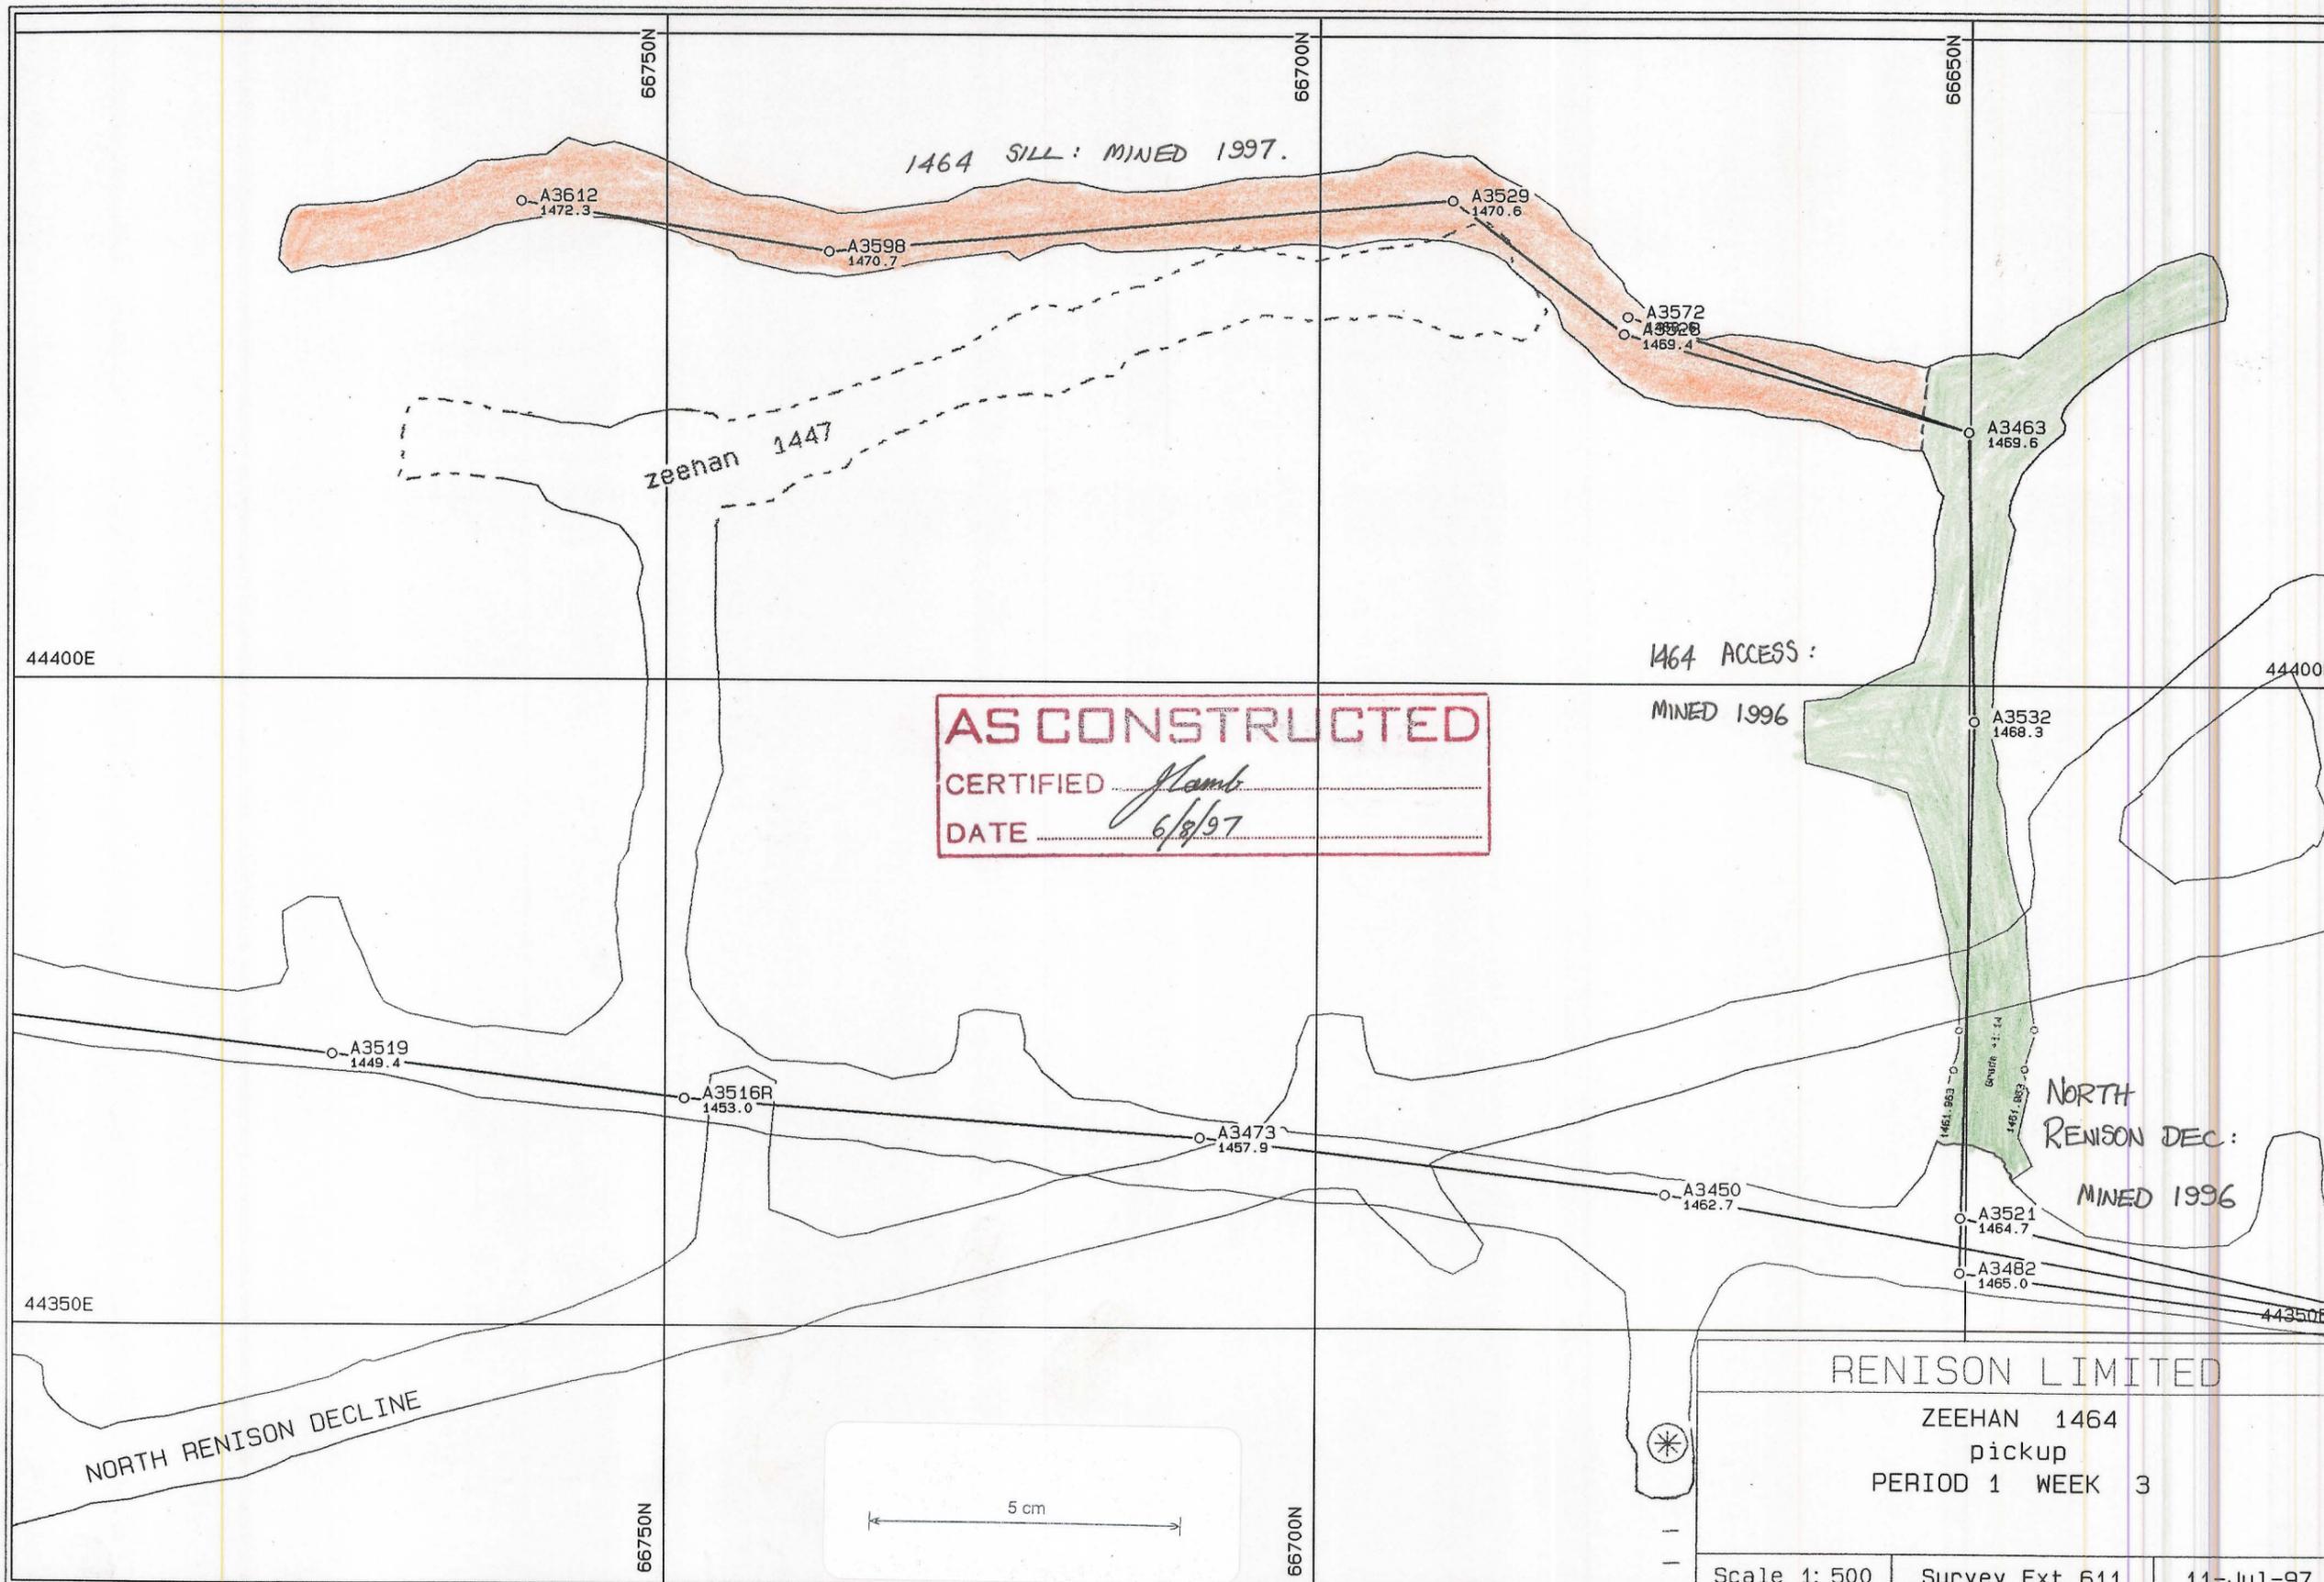

**AS CONSTRUCTED**  
 CERTIFIED *[Signature]*  
 DATE 6/8/97

RENISON LIMITED

ZEEHAN 1464  
pickup  
PERIOD 1 WEEK 3

Scale 1: 500 | Survey Ext 611 | 11-Jul-97

zeehan10.pf