

0376-737

RENISON LIMITED

FEDRAL 1750 SILL MASTER PLAN


SCALE	1: 500
DATE	14-May-97
LEVEL	FER

225: 000/01

RENISON LIMITED

Federal 1750 sill was mined off the Federal 1770 return airway. This plan replaces the original (lost/not drawn)

5 cm
0376-737

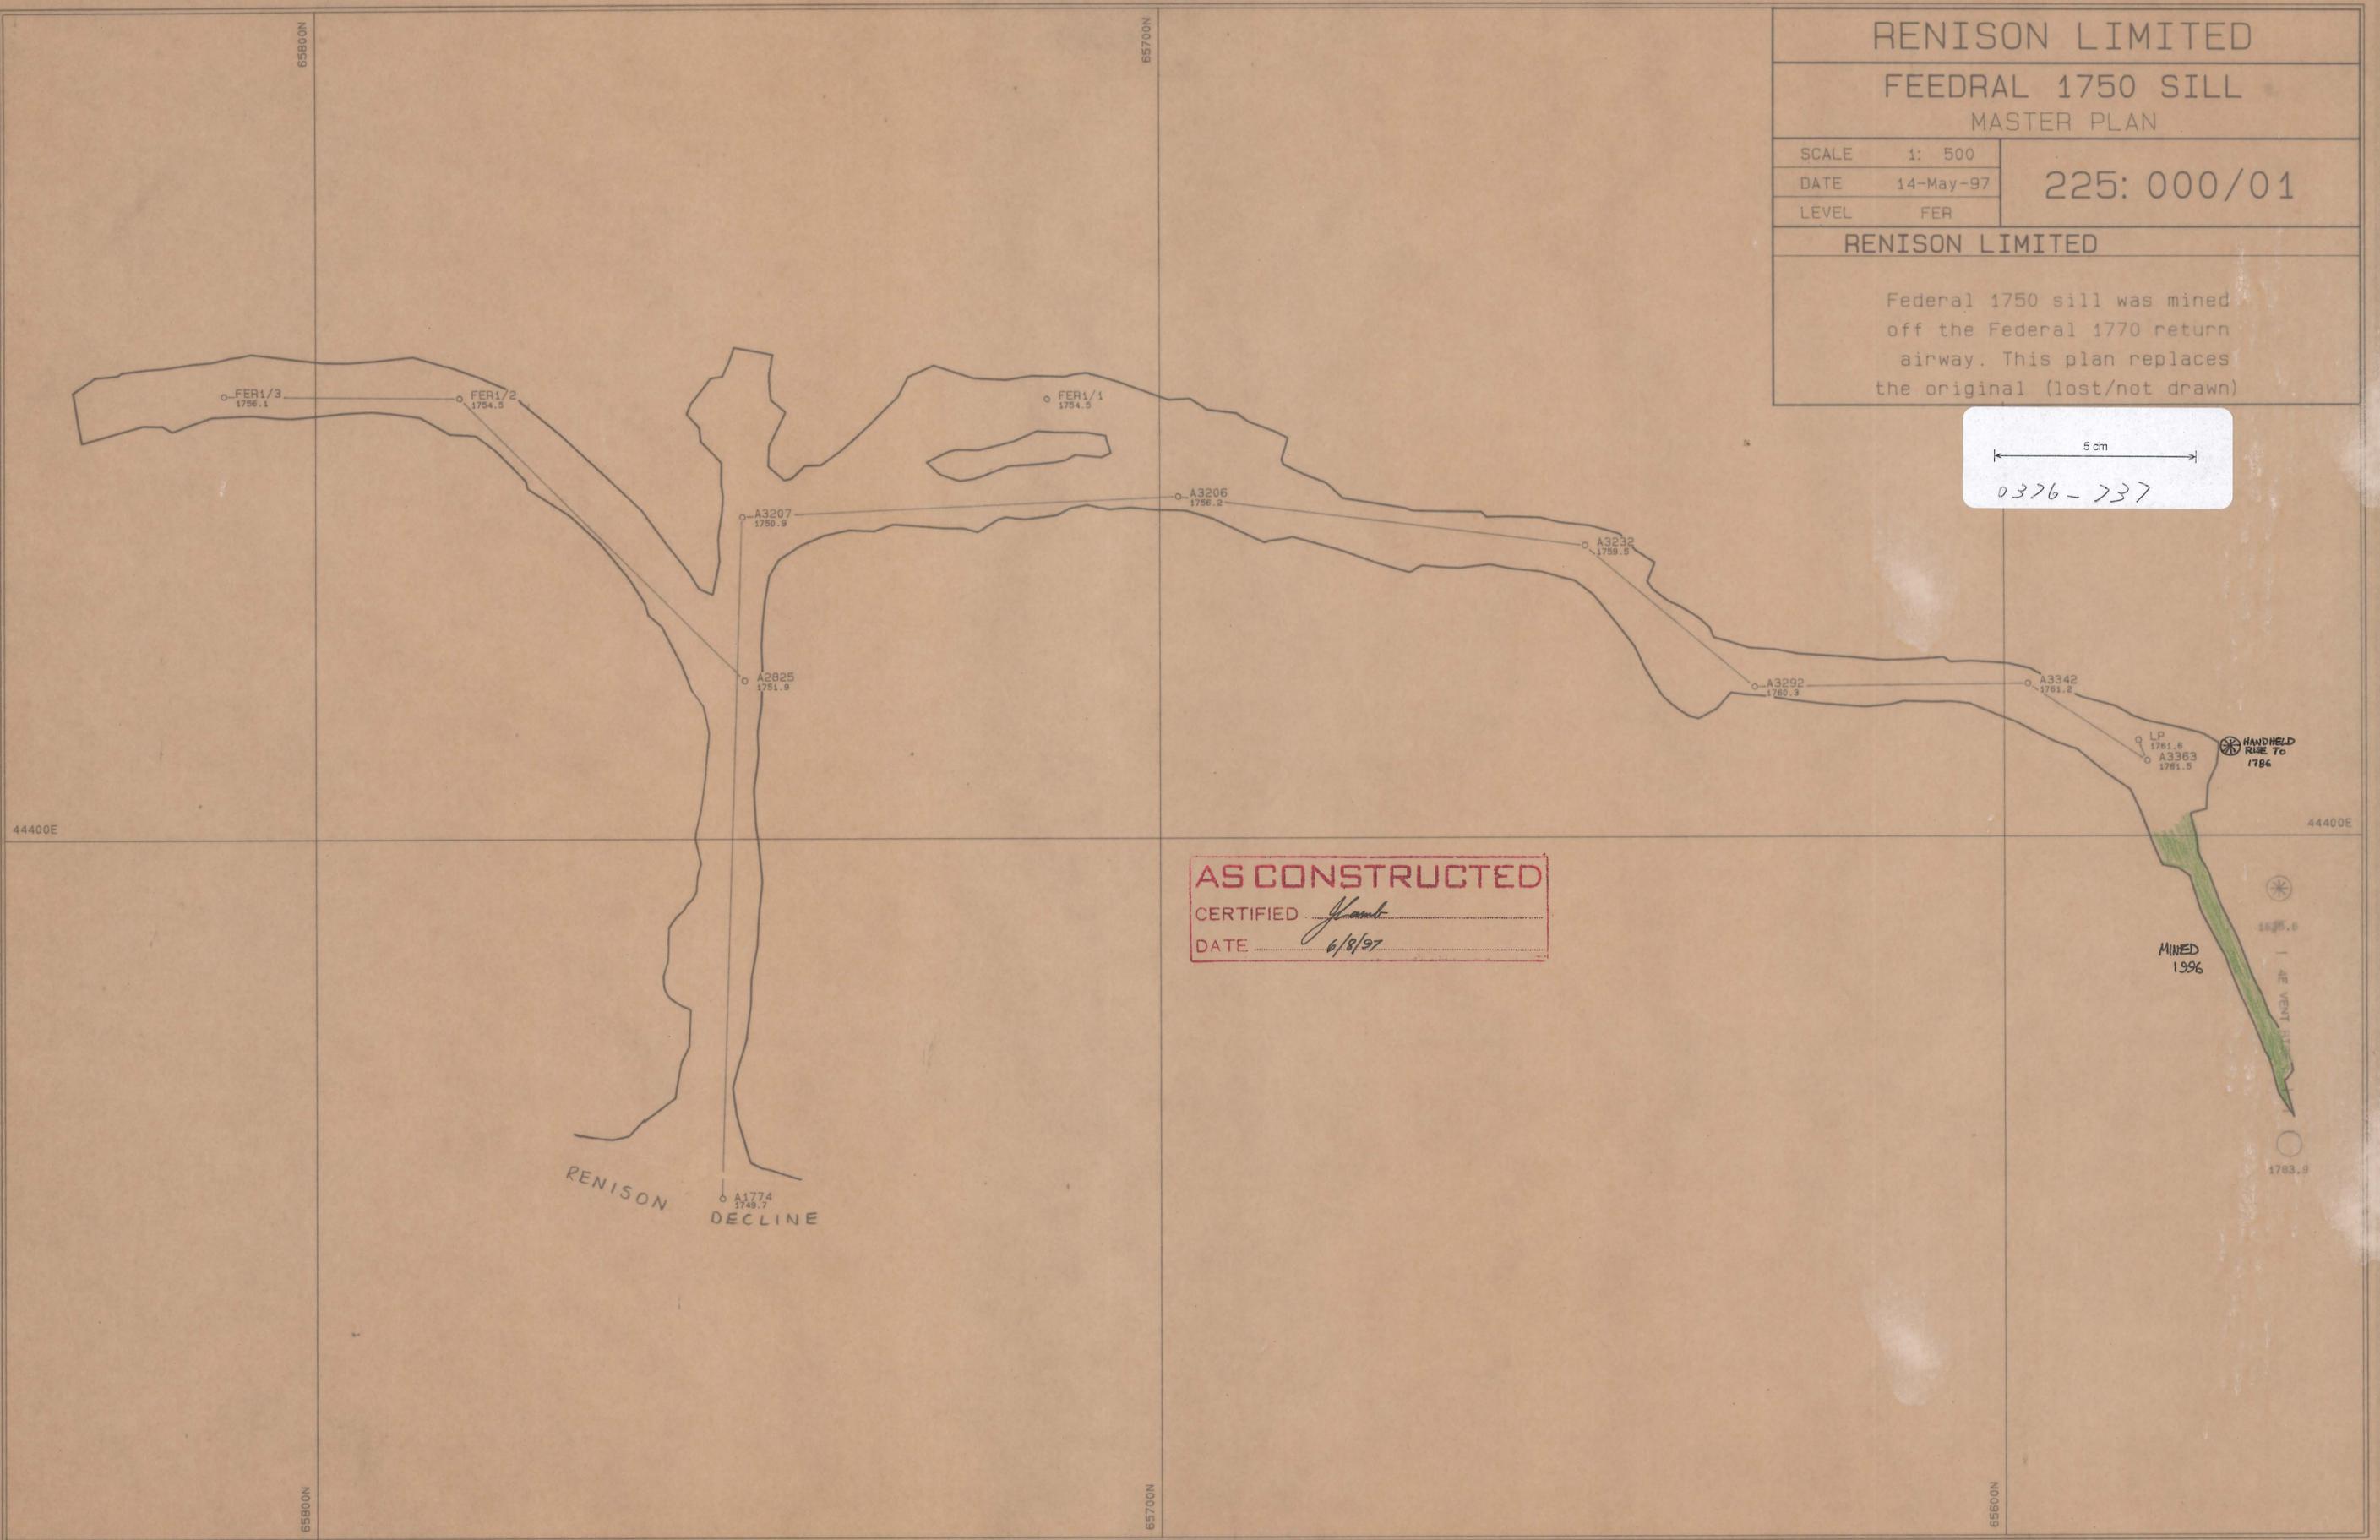

AS CONSTRUCTED
 CERTIFIED *J. Hunt*
 DATE *6/8/97*

federala.pf