

0376-739

RENISON LIMITED

Eldon 2 Lift 5 MASTER PLAN


SCALE 1: 500
DATE 5-JAN-96
LEVEL

211: 005/01

WEST COAST SURVEYS PTY LTD

Flatbacking Stope with uppers
fired at end of stope. Heights
in this area are estimates only.

5m
0376-739

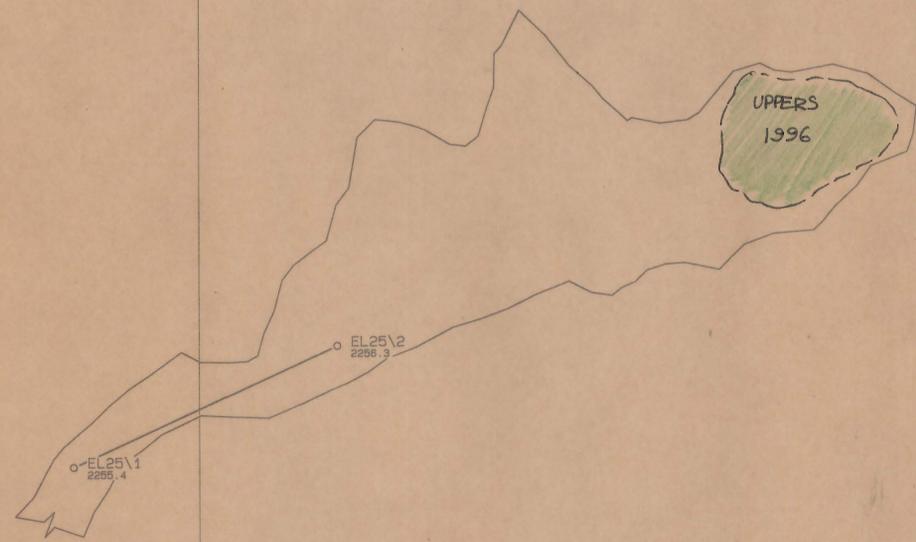

AS CONSTRUCTED
 CERTIFIED *[Signature]*
 DATE *6/8/97*

MASTEA .PF