


0376-740

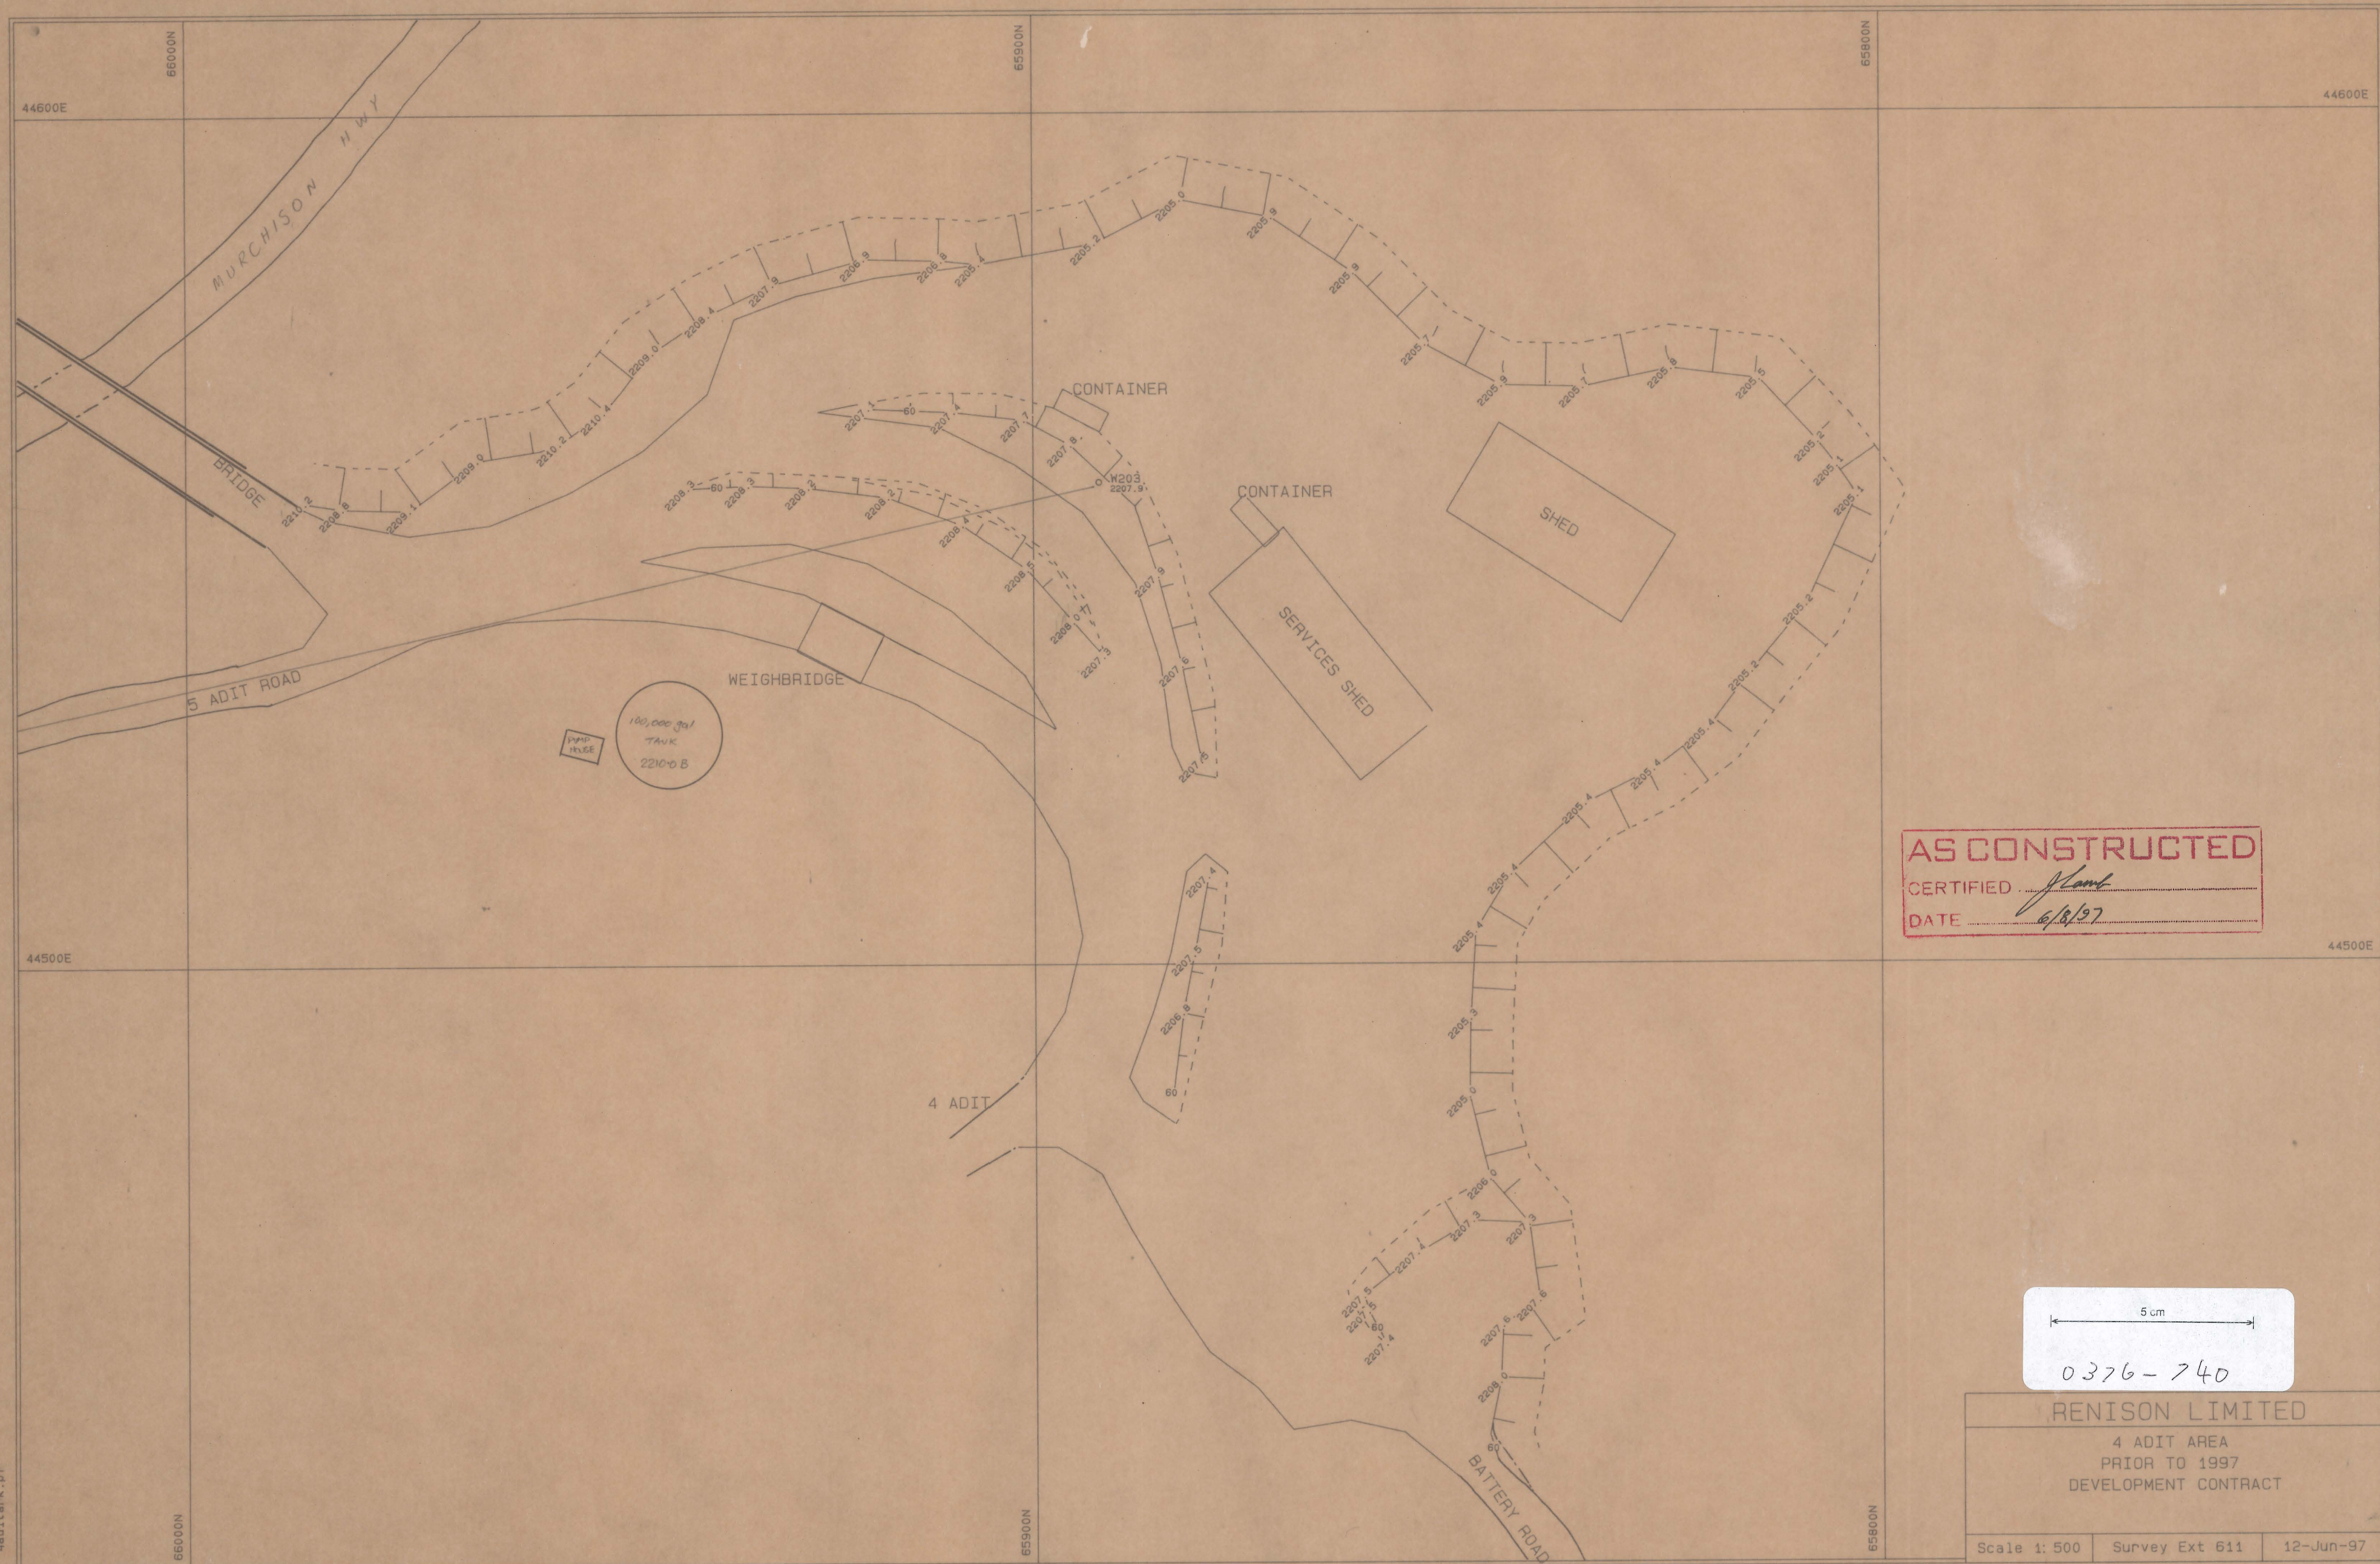

AS CONSTRUCTED
CERTIFIED *Plant*
DATE *6/8/97*

5 cm
0376-740

RENISON LIMITED
4 ADIT AREA
PRIOR TO 1997
DEVELOPMENT CONTRACT
Scale 1: 500 Survey Ext 611 12-Jun-97

4aditank.pf