

0376-741

RENISON LIMITED

Ring 11 Lift 1
MASTER PLAN

SCALE 1: 500
DATE 21-JAN-96
LEVEL


216: 001/01

WEST COAST SURVEYS PTY LTD

Standard flatbacking lift.
Uppers fired on RHS.

5 cm

0376-741

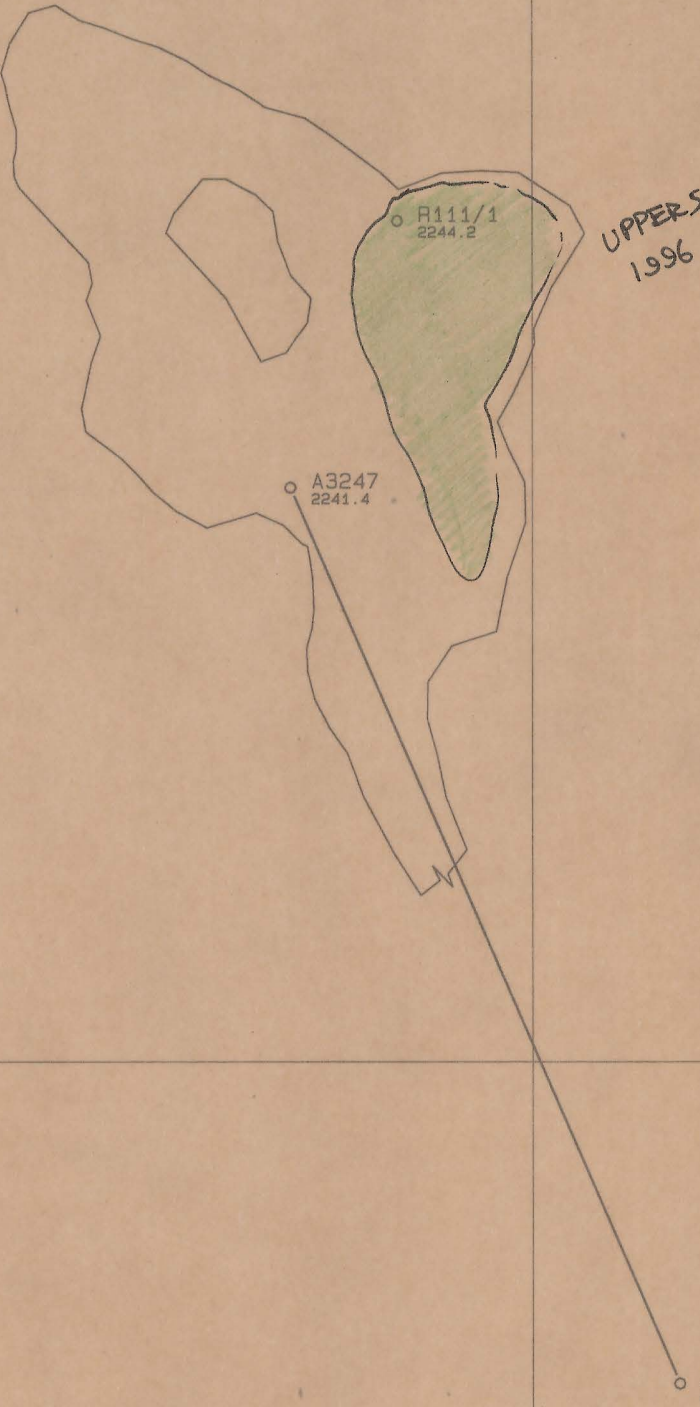

AS CONSTRUCTED
CERTIFIED *flamb*
DATE *6/8/97*