


PLAN VIEW

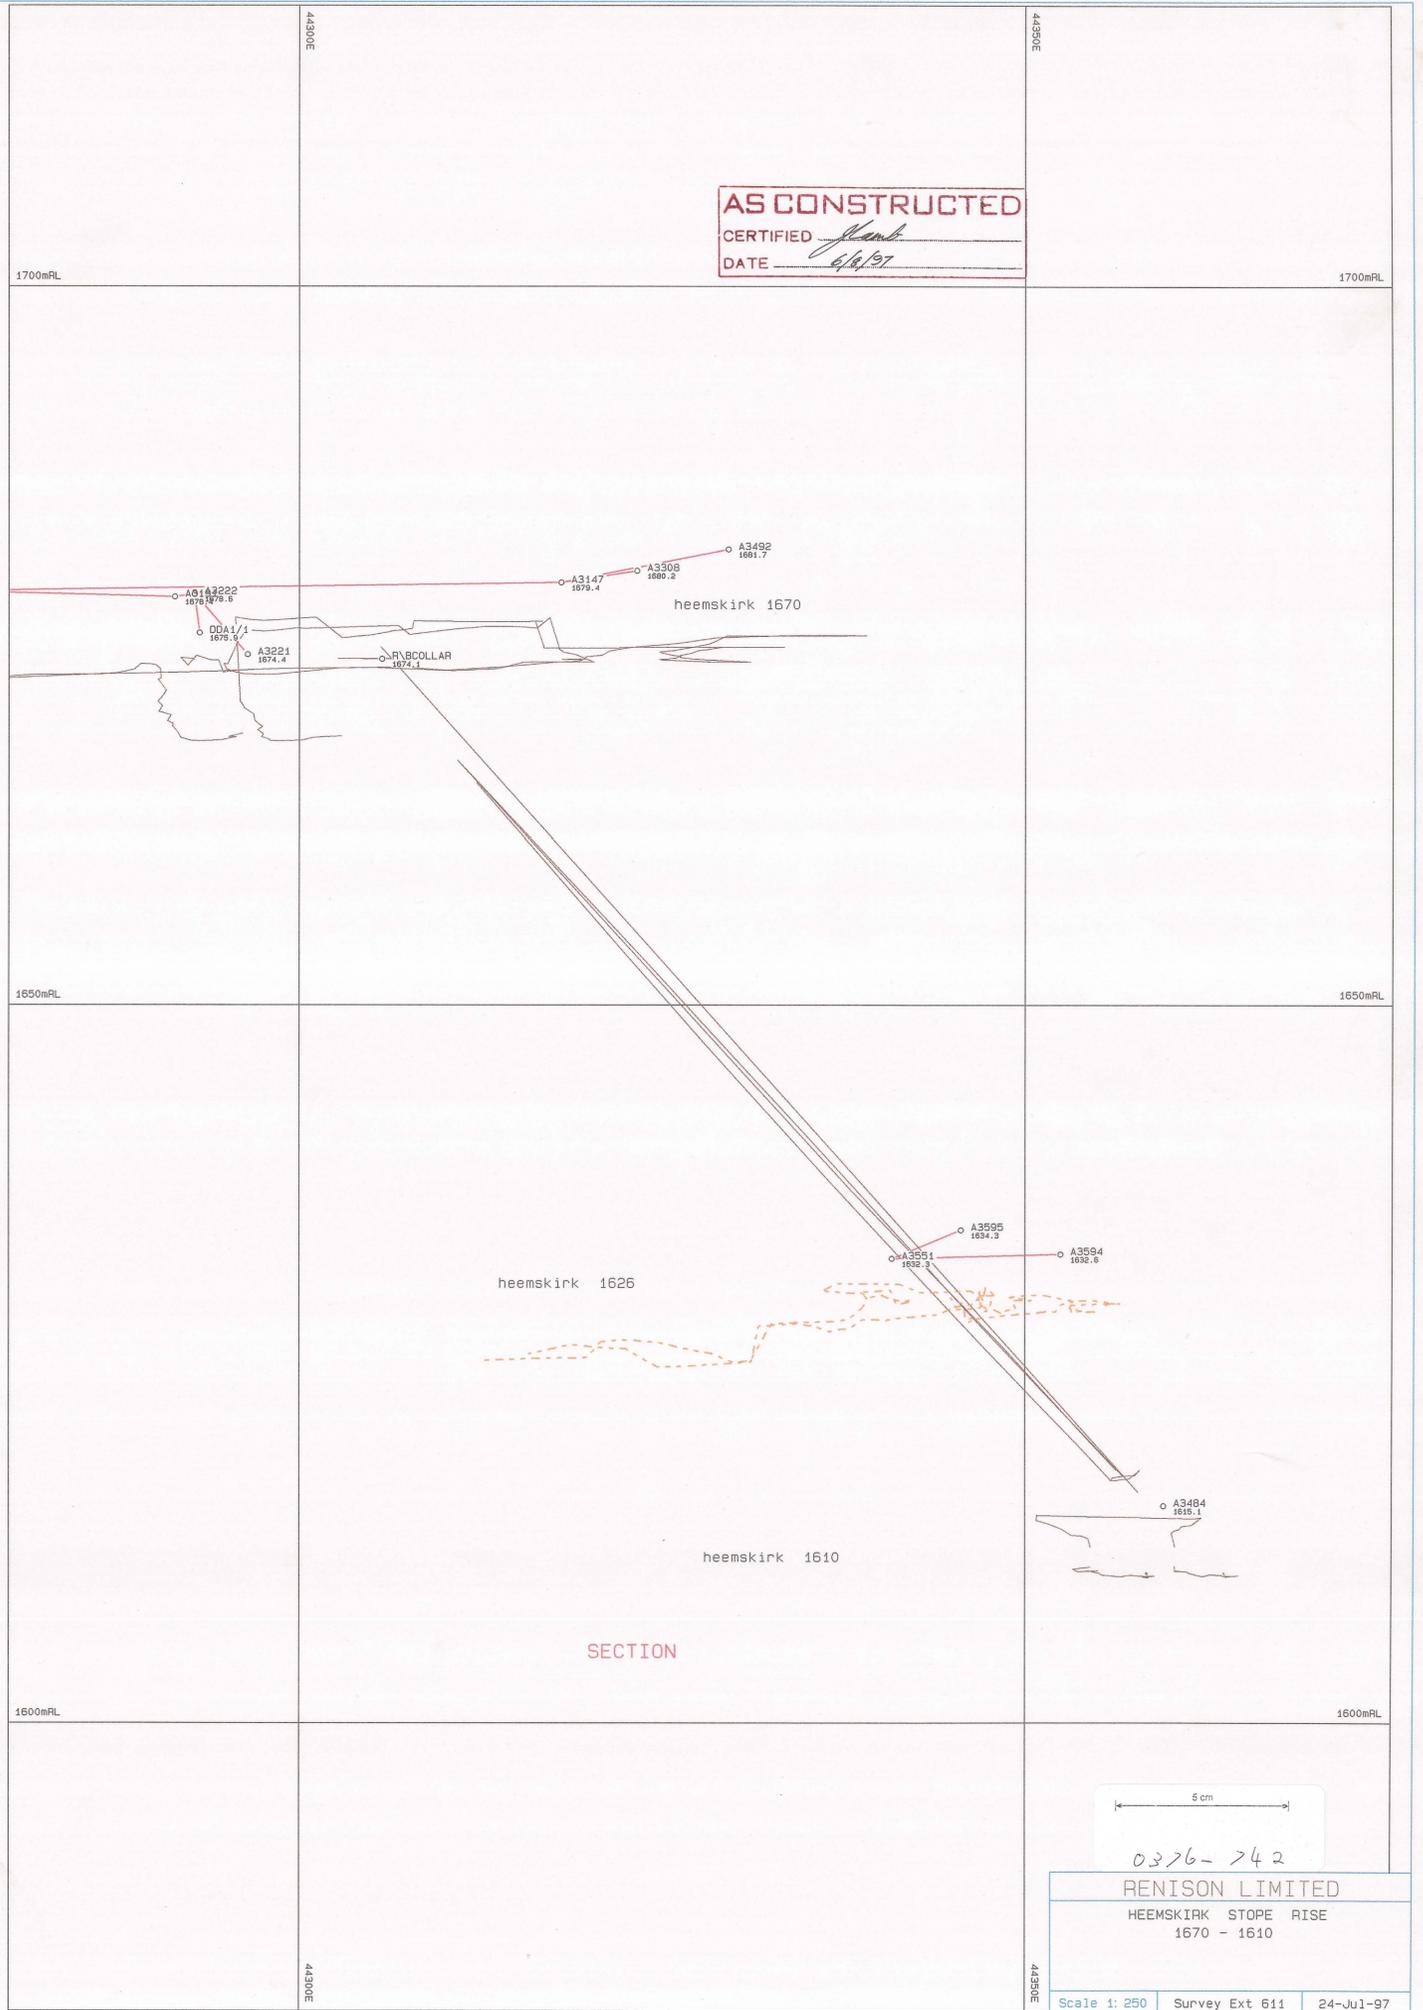

SECTION

**AS CONSTRUCTED**  
 CERTIFIED *[Signature]*  
 DATE *6/16/97*

5 cm

0376-742

**RENISON LIMITED**  
 HEEMSKIRK STOPE RISE  
 1670 - 1610

Scale 1: 250    Survey Ext 611    24-Jul-97

0376-742