

RENISON LIMITED

SLIGO 3 LIFT 5

MASTER, BACK, FILL PLAN

SCALE	1: 500
DATE	28-Apr-97
LEVEL	SL3

209: 005/01, 2

RENISON LIMITED

Mining completed October '96?

Original plan lost or not drawn

5 cm
0376-747

AS CONSTRUCTED
CERTIFIED *Hand*
DATE *6/6/97*

LIFT 5
1996.


BACK HEIGHTS

FLOOR/FILL HEIGHTS.

SLIGO 3 RAW

SLIGO 3 RAW

SLIGO 3 RAW

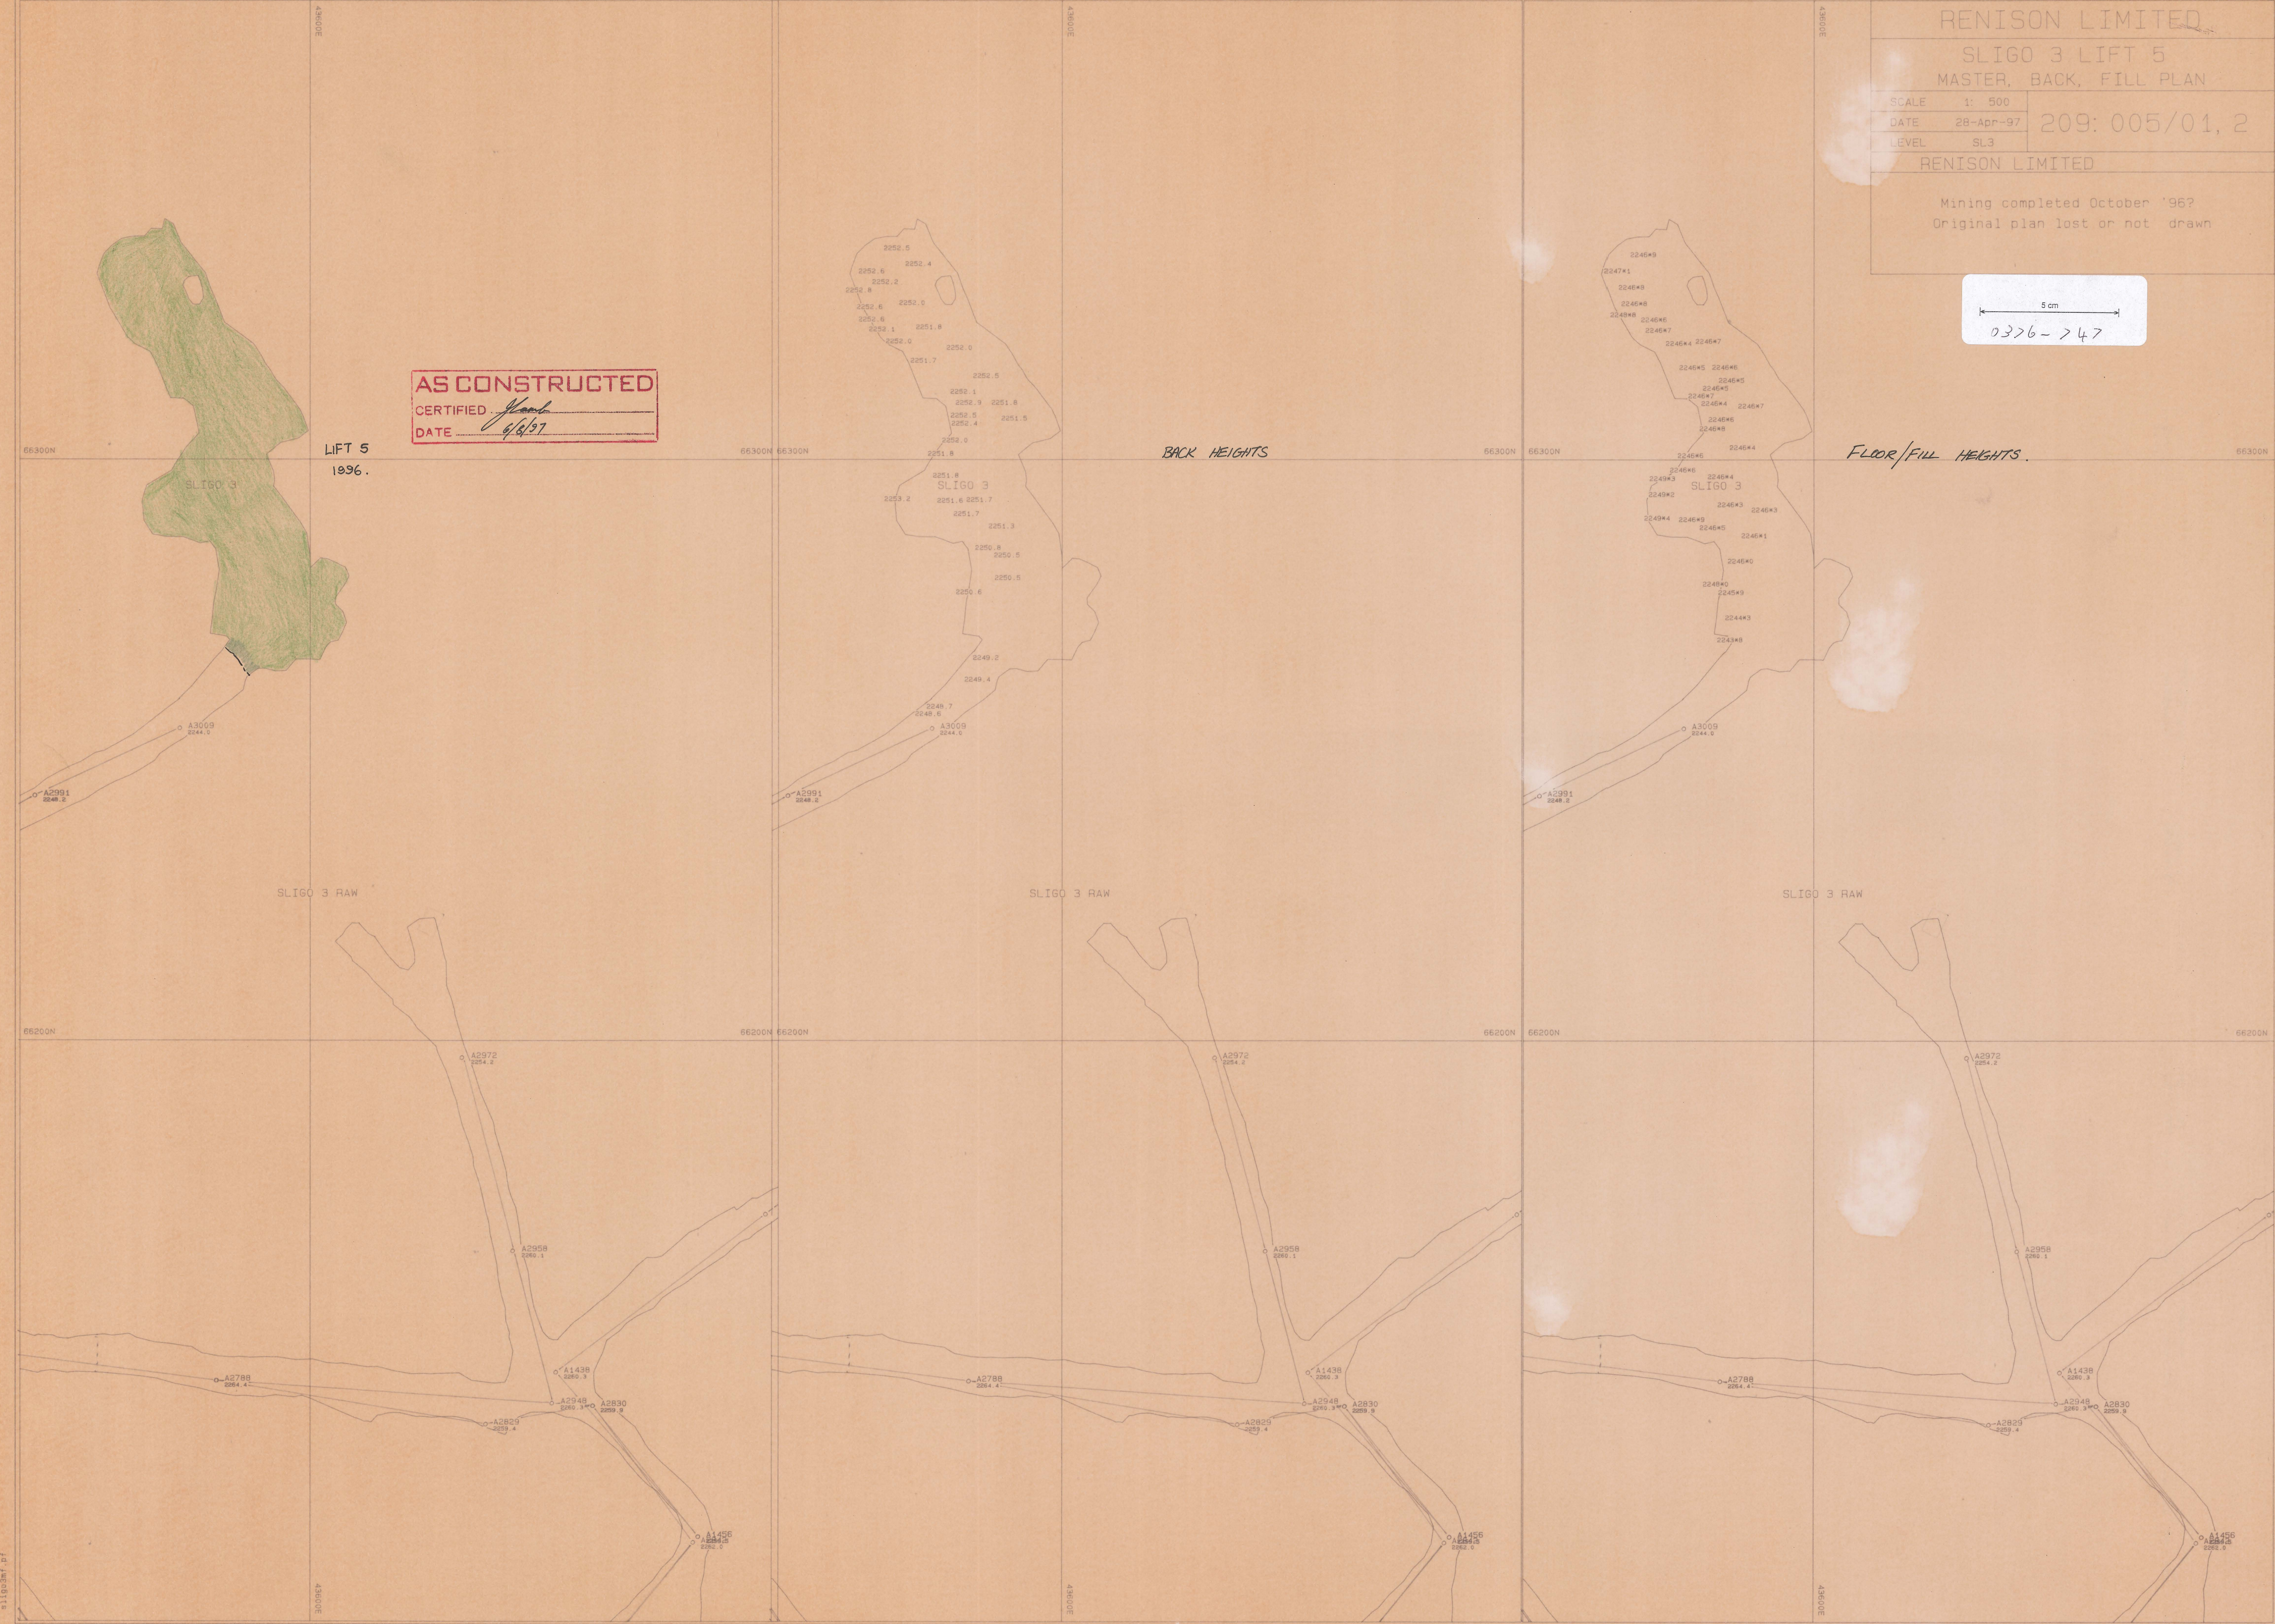

0376-747