

RENISON LIMITED

ELDON 6 LIFTS 1-3
COMPLETED LIFT PLANS

SCALE 1: 500
DATE 16-Jul-97
LEVEL EL6

APPROVED:

REG. MINE SURVEYOR: *[Signature]*
REG. MINE MANAGER:

5 cm
0376-749

LIFT 1

LIFT 2

LIFT 3

13A RISE PILLAR




A3384
2284.7

A3343
2284.4

A3384
2284.7

A3343
2284.4

A3382
2281.7

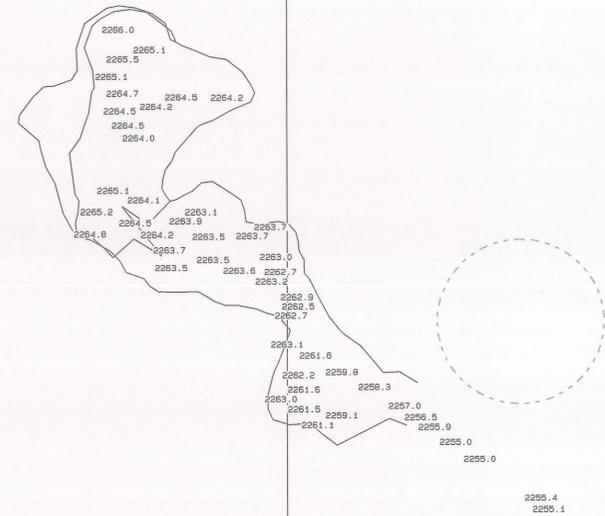

0376-749