

RENISON LIMITED

BLACKWOOD DECLINE
BELOW 1745 RL

SCALE 1: 500
DATE 25-Jul-97
LEVEL


BLK66603

Replaces previous files and
plans numbered 66603 and 66604

AS CONSTRUCTED

CERTIFIED *Plant*
DATE *9/97*

5 cm
0376-7SS

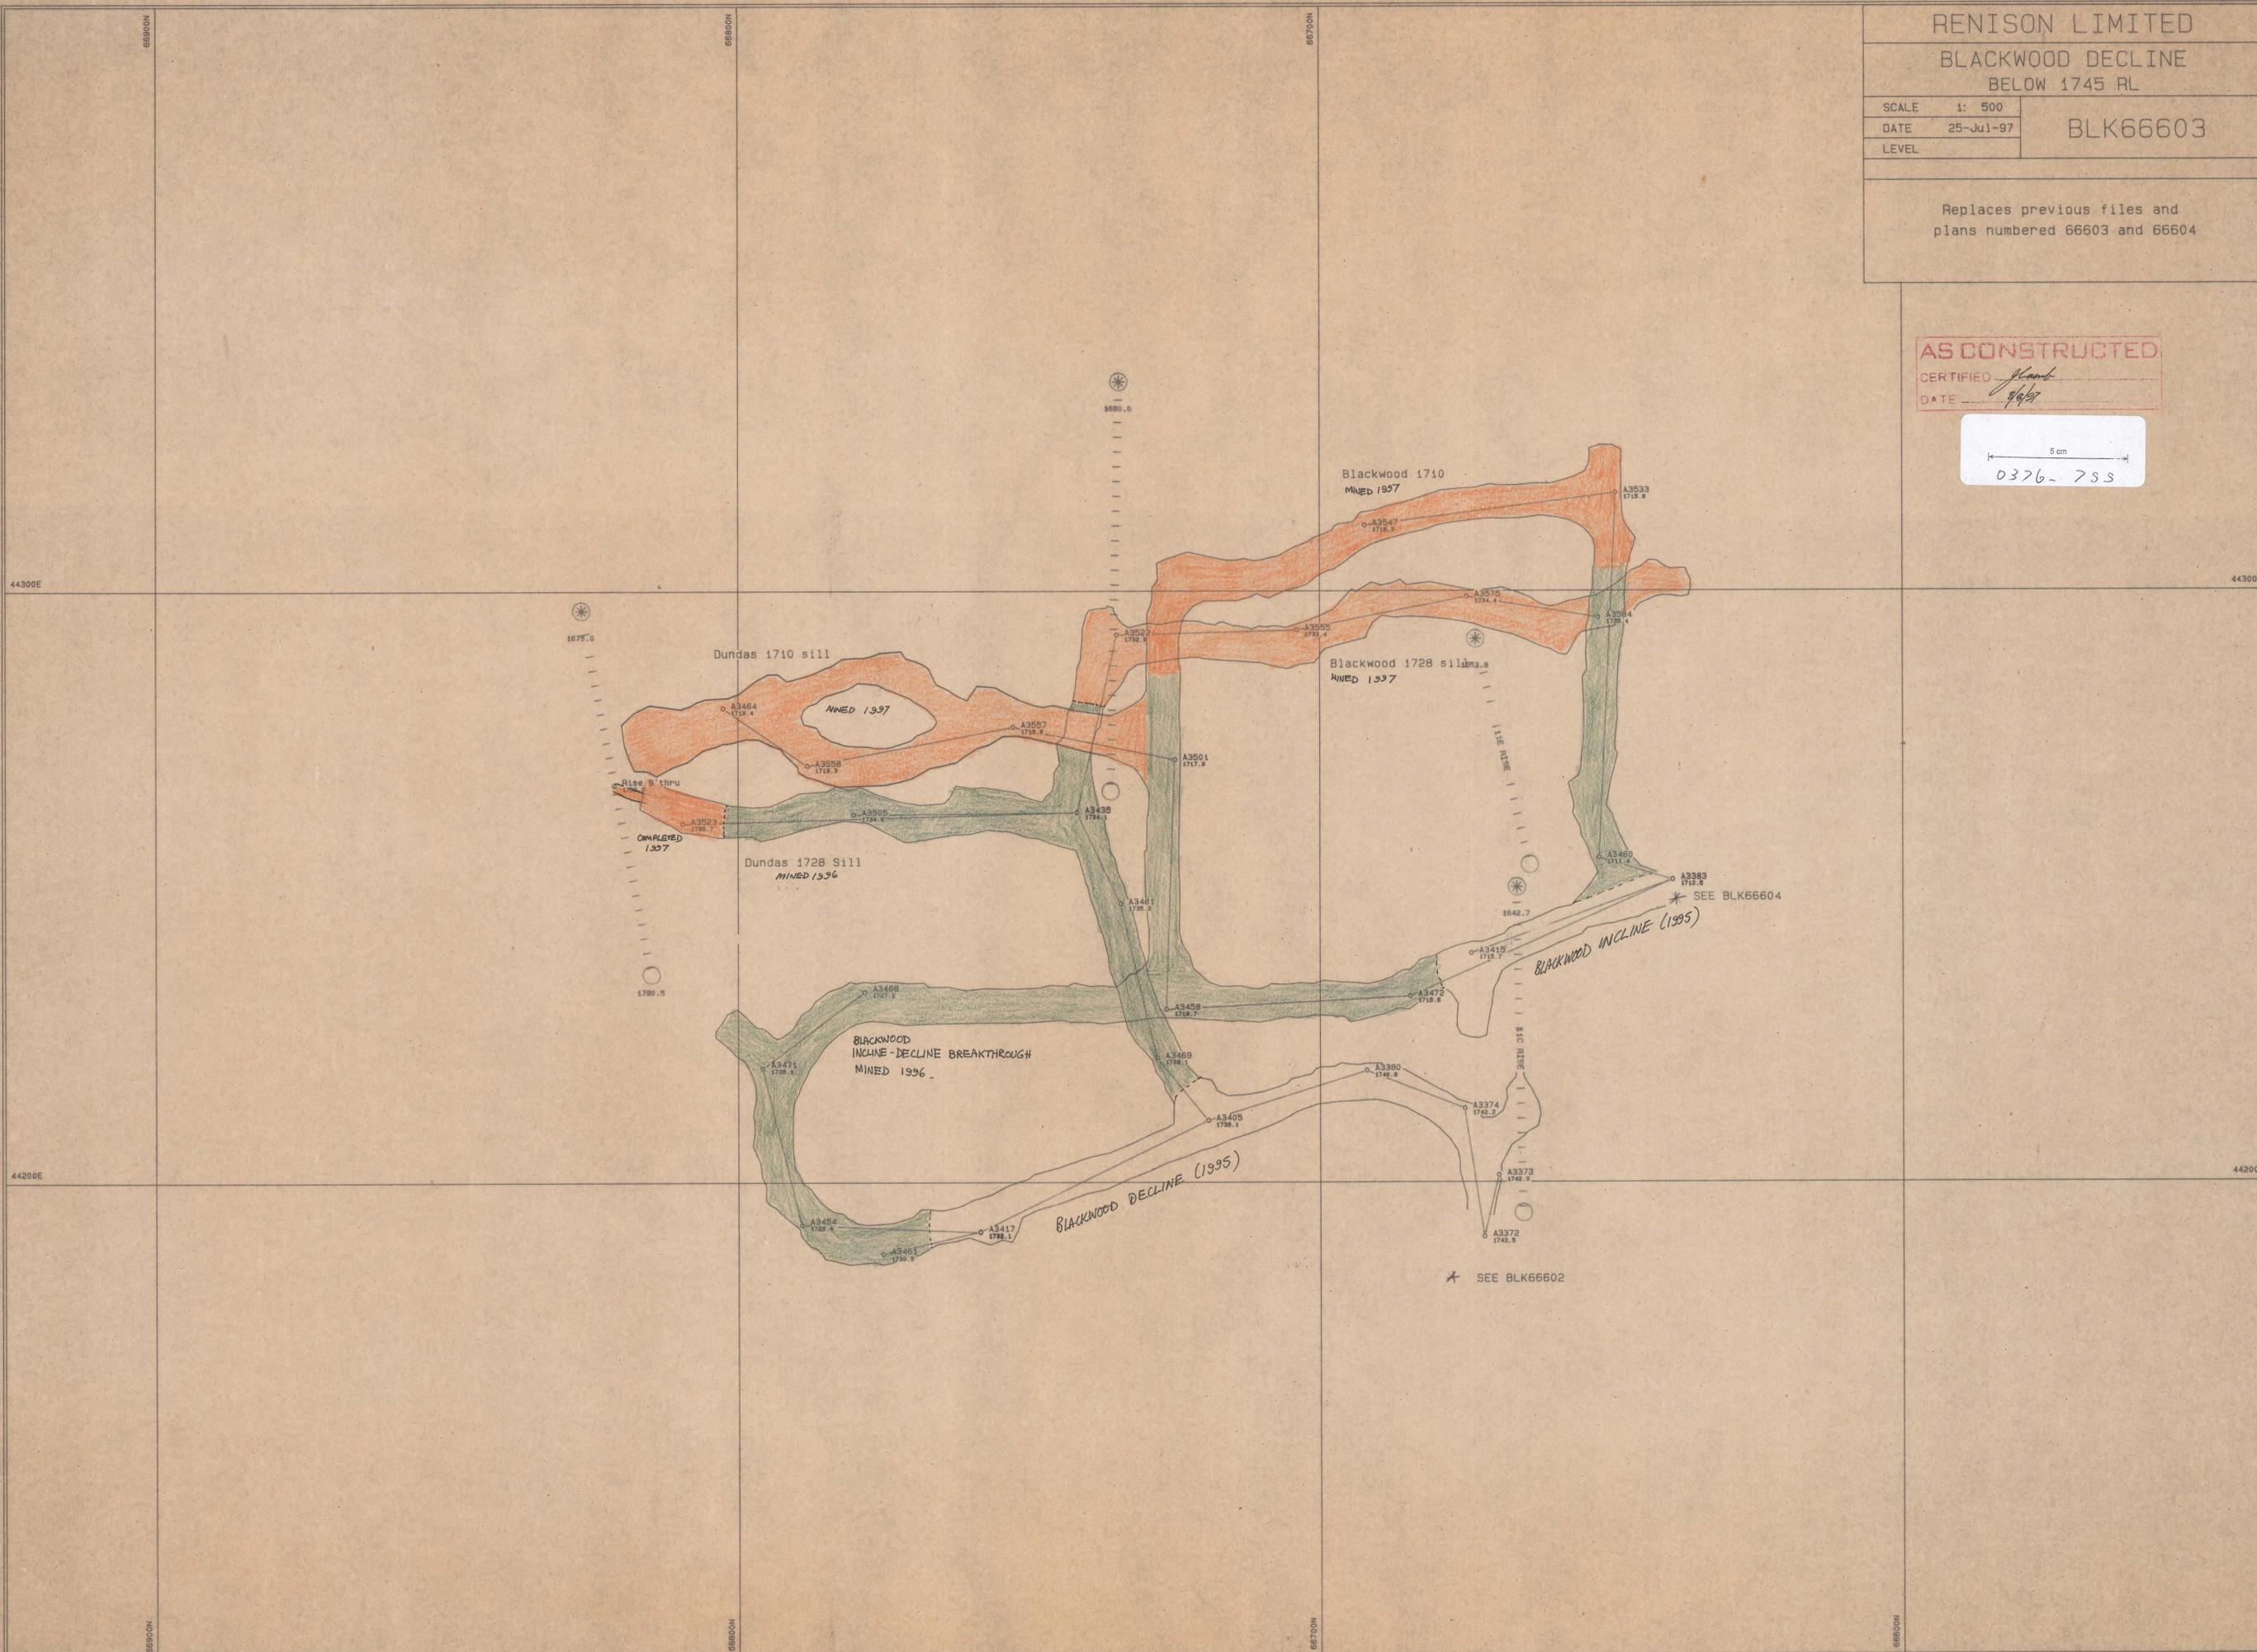

0376-7SS