

0376-757

RENISON LIMITED

SLIGO 3C SILL

MASTER

SCALE 1: 500


DATE 28-Apr-97

LEVEL SL3

222: 000/01

RENISON LIMITED

Silling of block C commenced
from the lift 5 and 6 access.
The sill was completed April
1997.

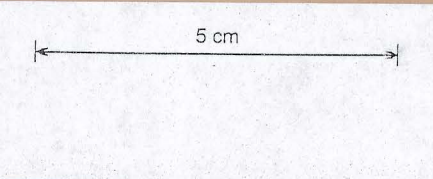

AS CONSTRUCTED

CERTIFIED *Hand*

DATE 6/8/97

