
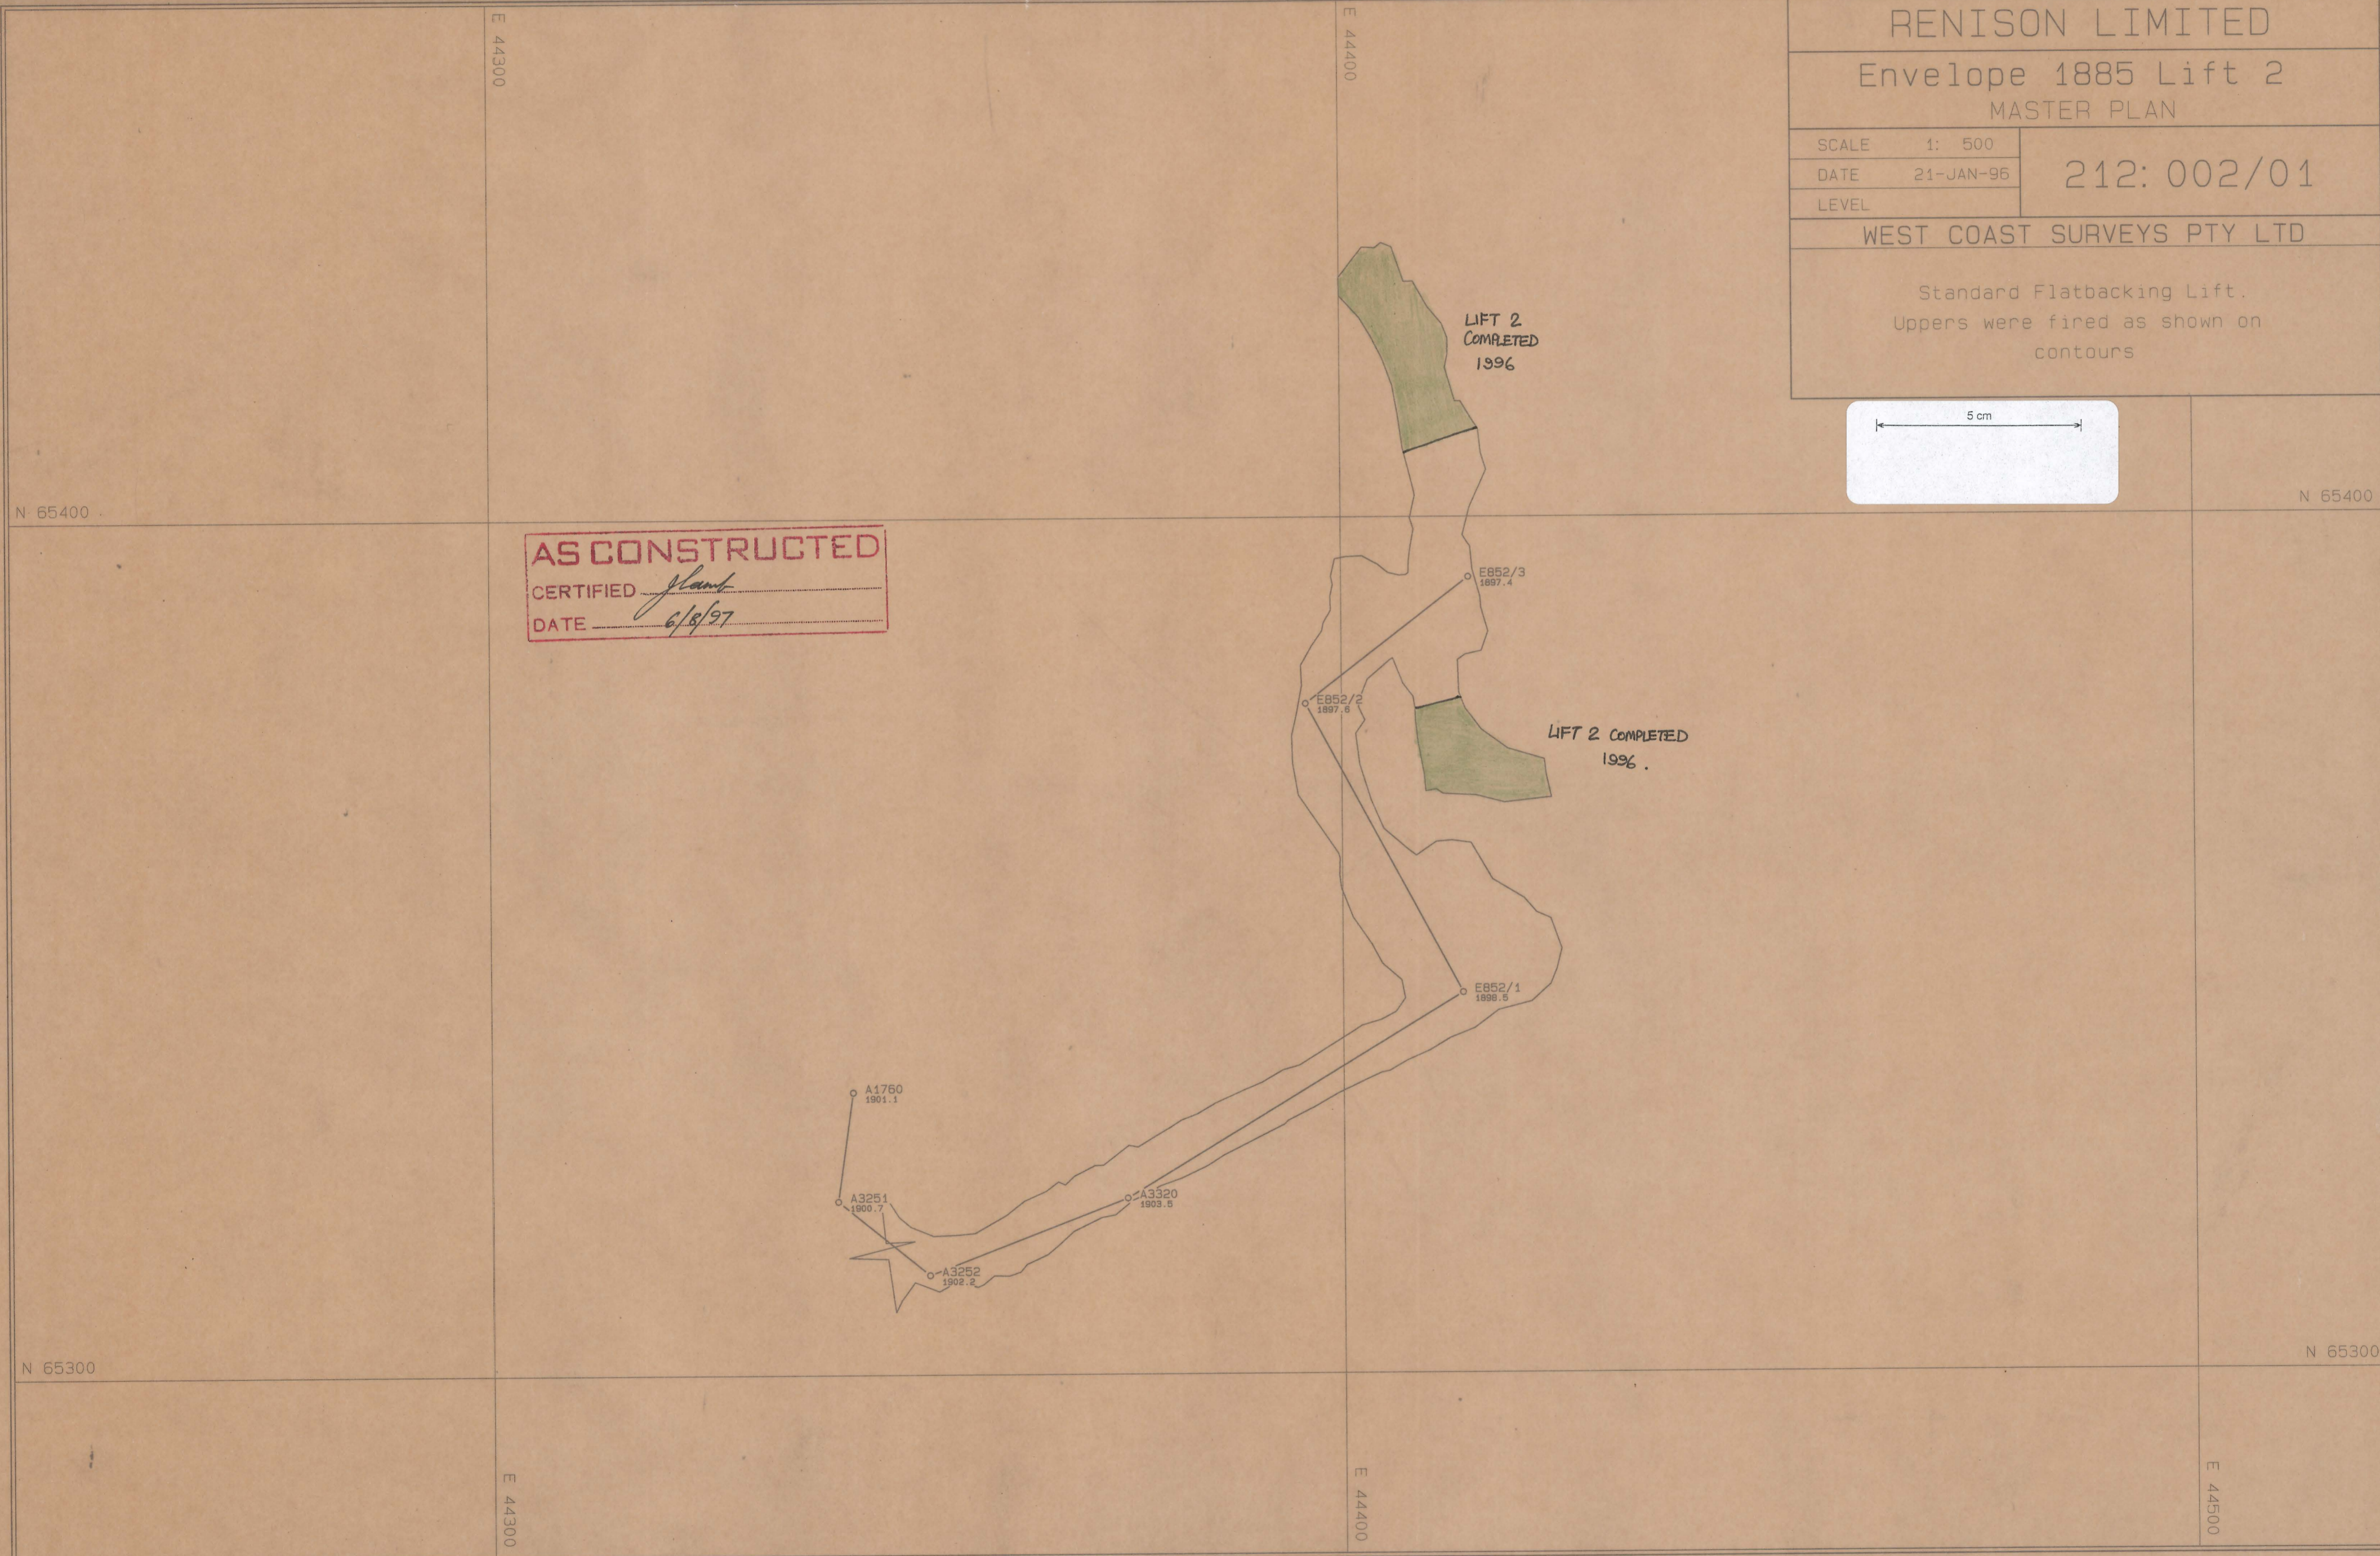


0376-758

RENISON LIMITED
Envelope 1885 Lift 2
MASTER PLAN

SCALE	1: 500	212: 002/01
DATE	21-JAN-96	
LEVEL		
WEST COAST SURVEYS PTY LTD		

Standard Flatbacking Lift.
Uppers were fired as shown on
contours

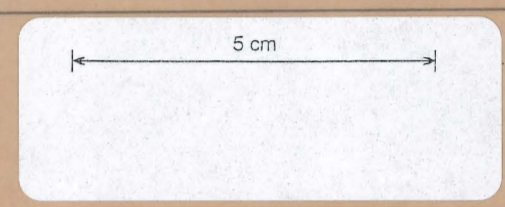

AS CONSTRUCTED
 CERTIFIED *Plant*
 DATE *6/8/97*