


0376-759

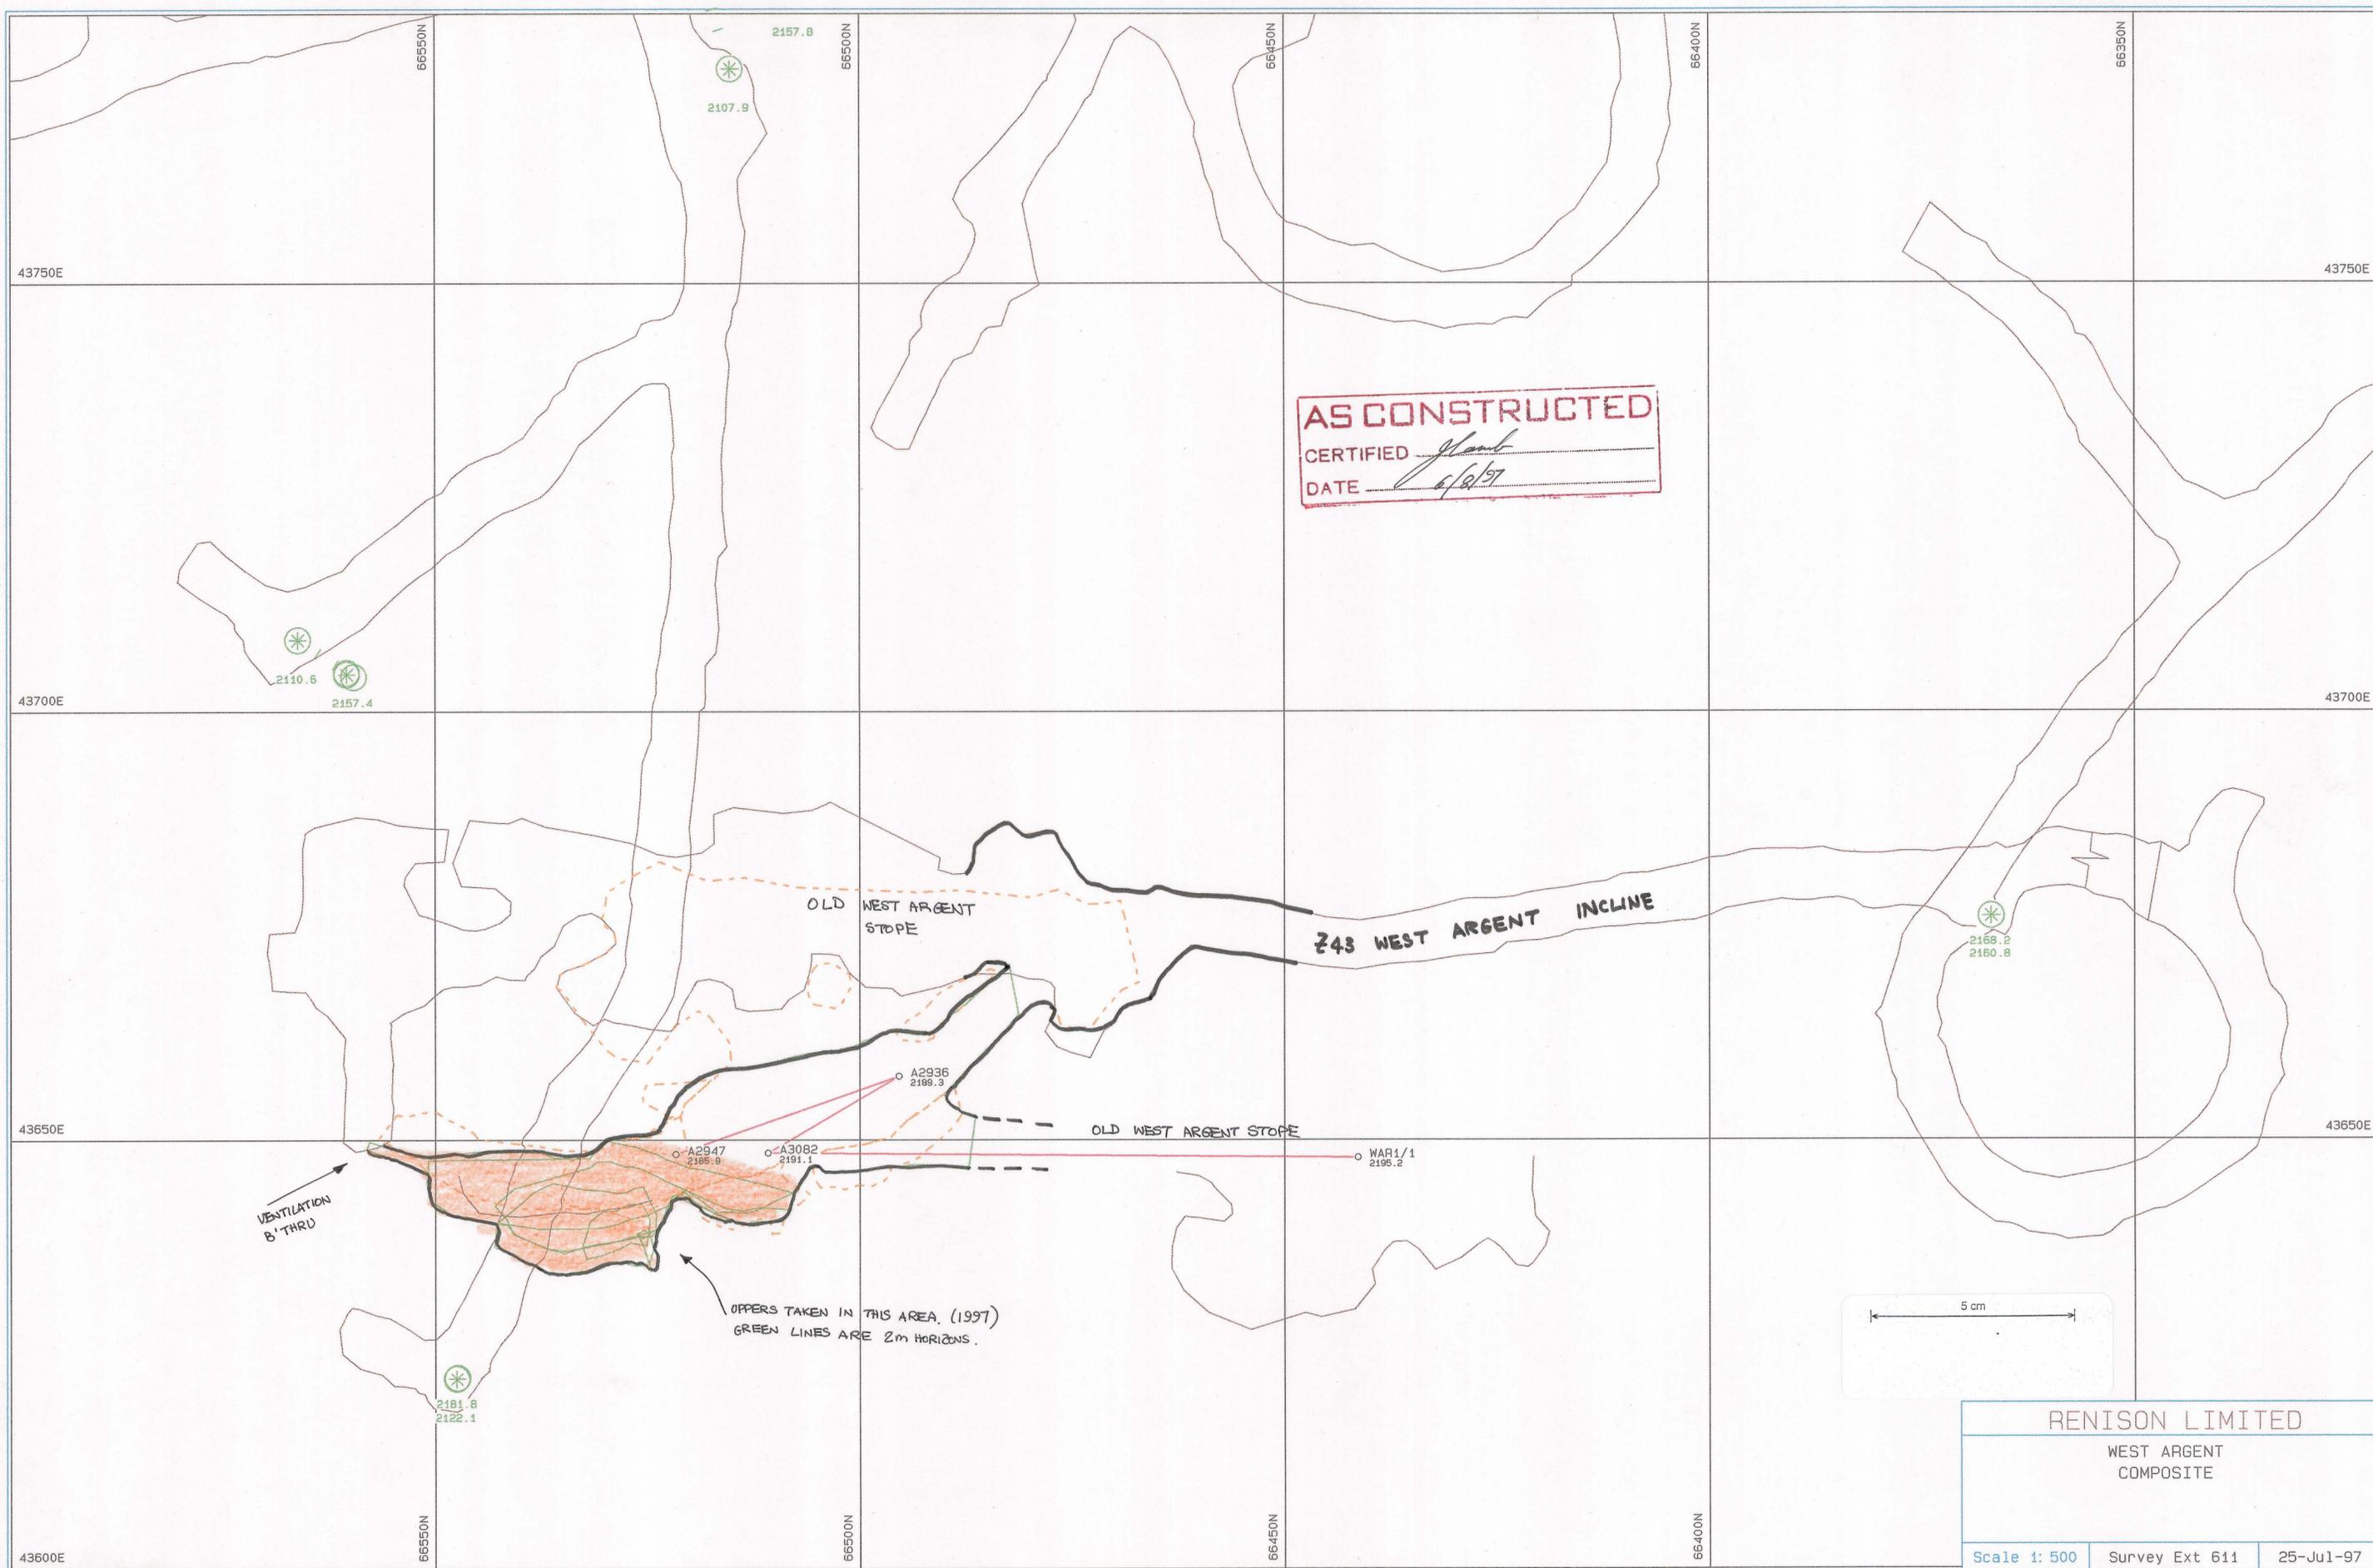

AS CONSTRUCTED
 CERTIFIED *[Signature]*
 DATE *6/8/97*


VENTILATION
B'THRD

OLD WEST ARGENT
STOPE

243 WEST ARGENT
INCLINE

OLD WEST ARGENT
STOPE

OPPERS TAKEN IN THIS AREA (1997)
GREEN LINES ARE 2m HORIZONS.

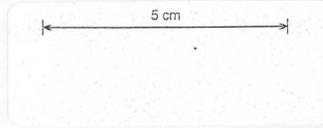

RENISON LIMITED		
WEST ARGENT COMPOSITE		
Scale 1: 500	Survey Ext 611	25-Jul-97

westargd.pf