


0376-760

AS CONSTRUCTED
CERTIFIED *Glenn*
DATE *6/8/97*

5 cm

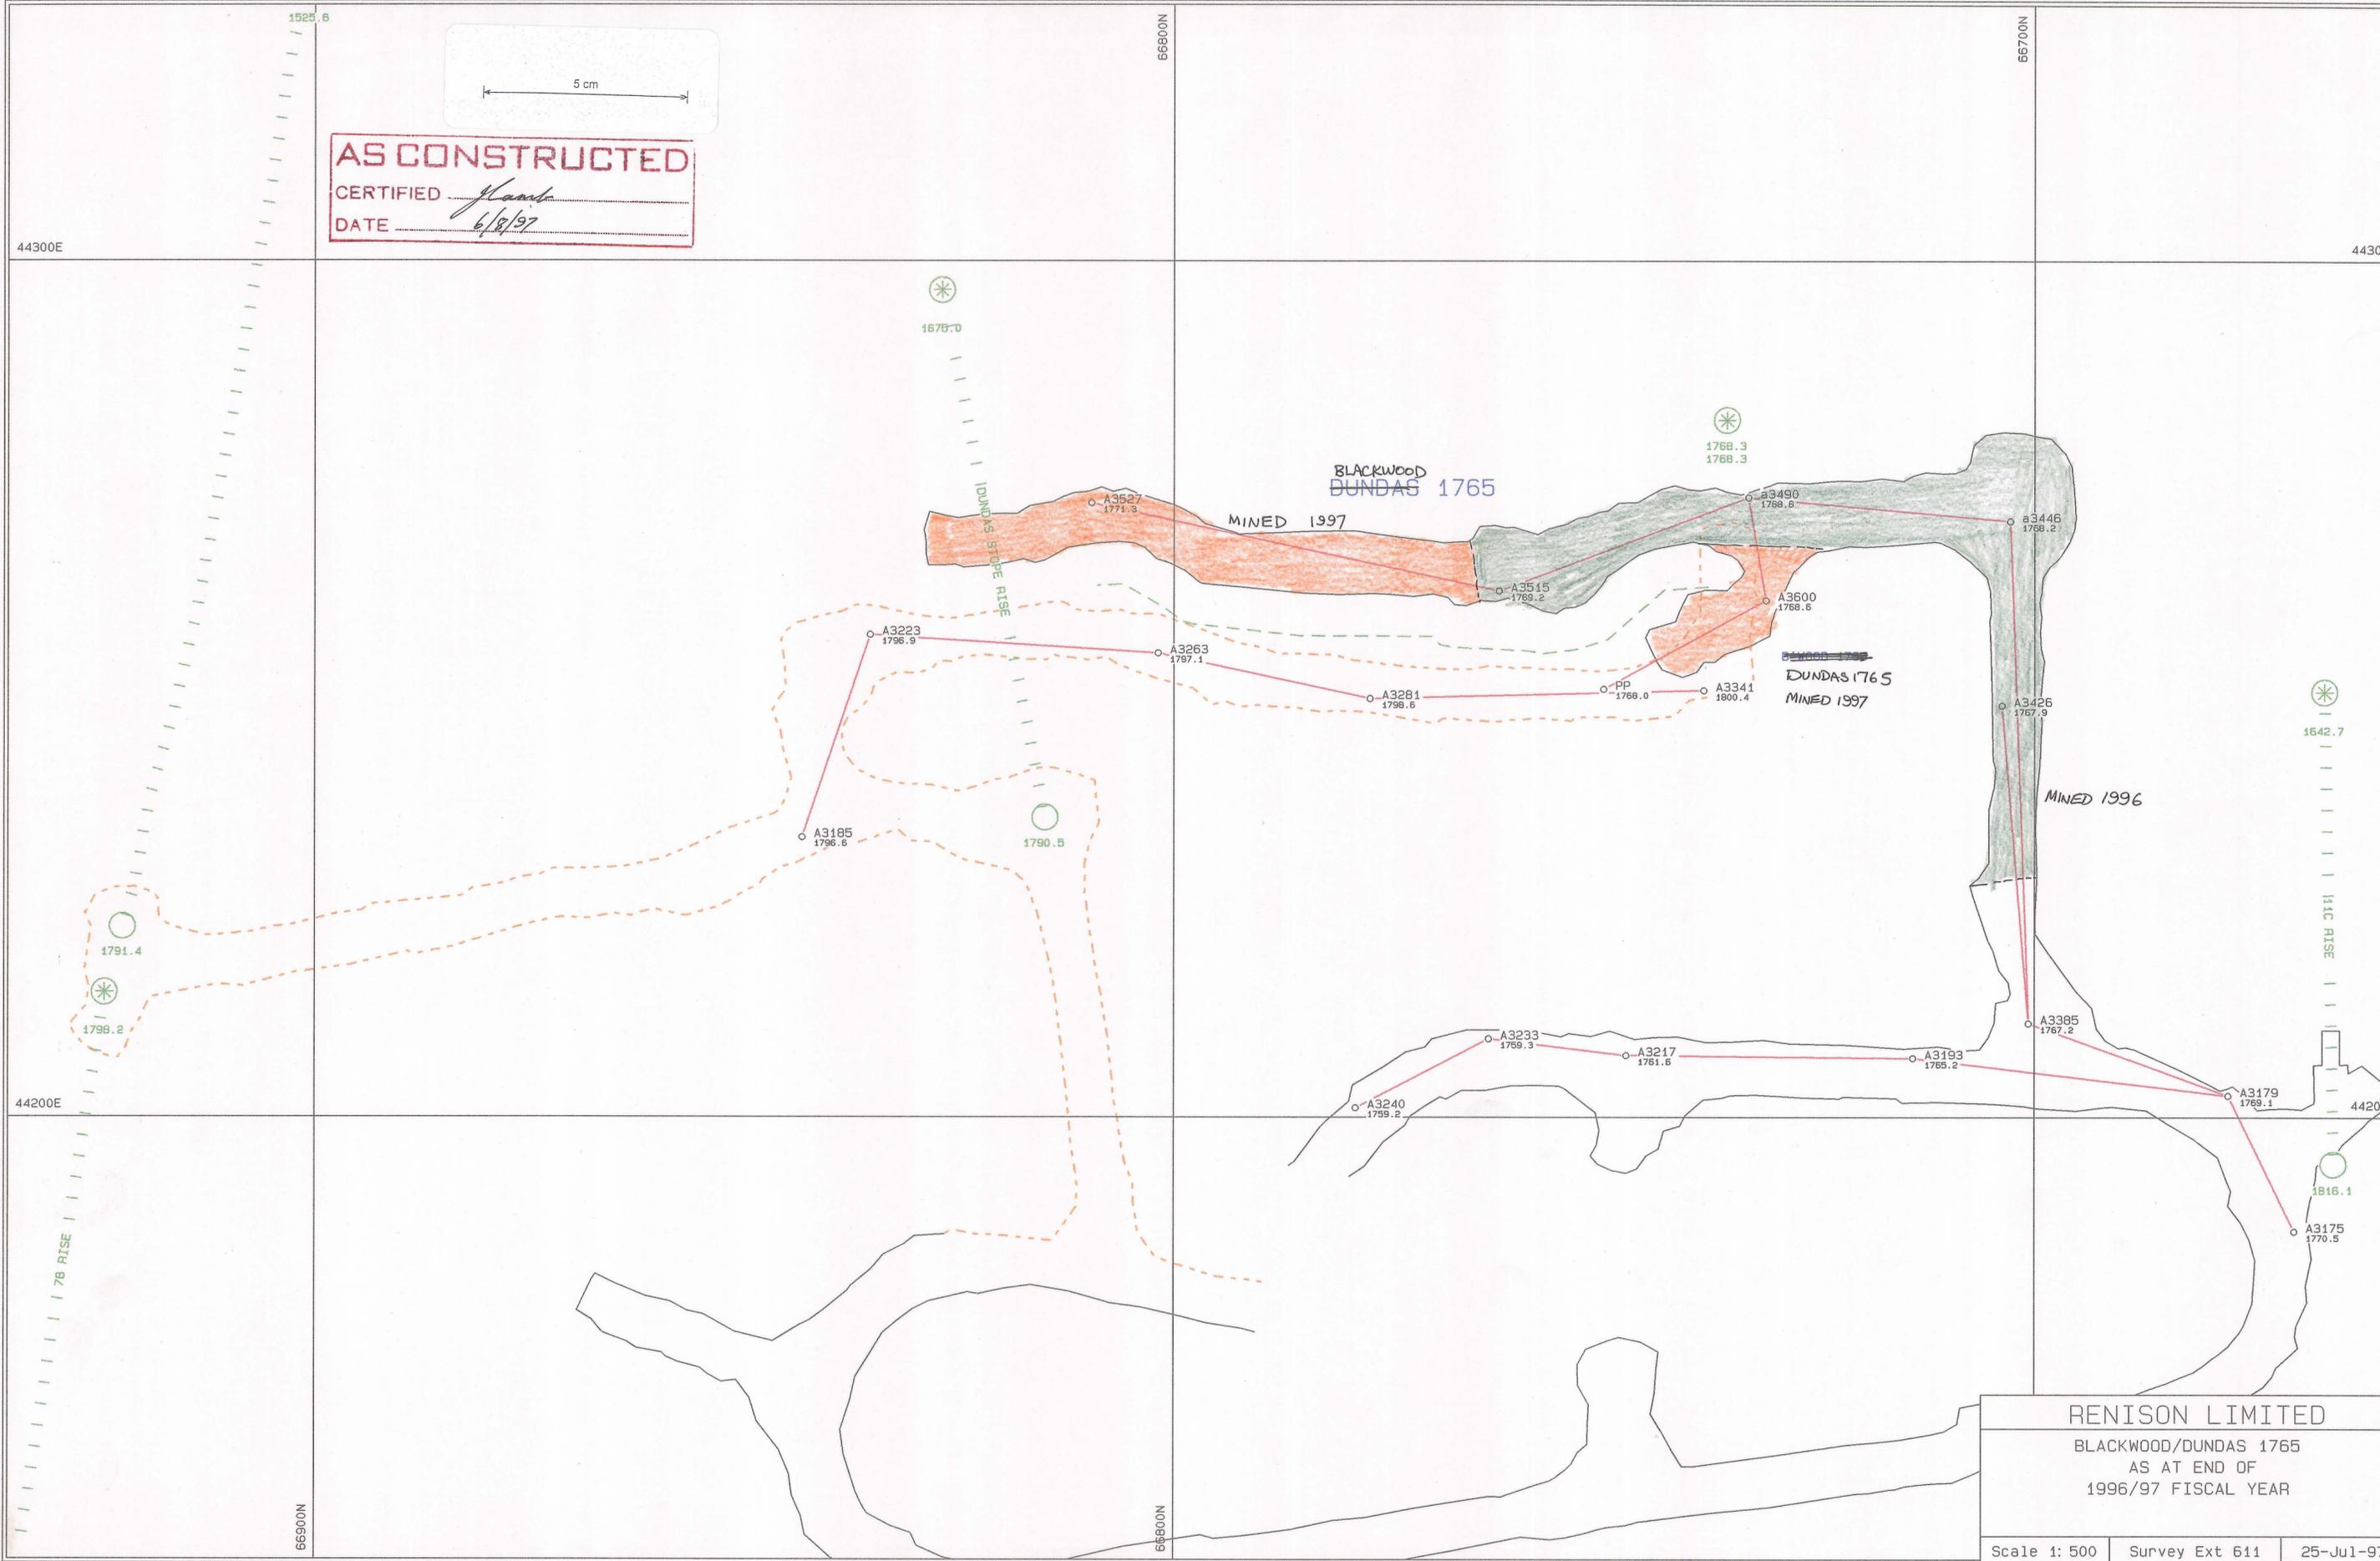

RENISON LIMITED
 BLACKWOOD/DUNDAS 1765
 AS AT END OF
 1996/97 FISCAL YEAR

Scale 1: 500 Survey Ext 611 25-Jul-97

dundas1a..pf