

0376-762

RENISON LIMITED

POLARIS BLOCK 6/10 AREA WORKING PLAN




SCALE 1: 500
DATE 01-May-97
LEVEL POL

204-6

RENISON LIMITED

Combined view of South, West,
Central and North Argent
Stopes; previous Polaris lifts
and Argent development.

AS CONSTRUCTED
CERTIFIED *James*
DATE *8/8/97*

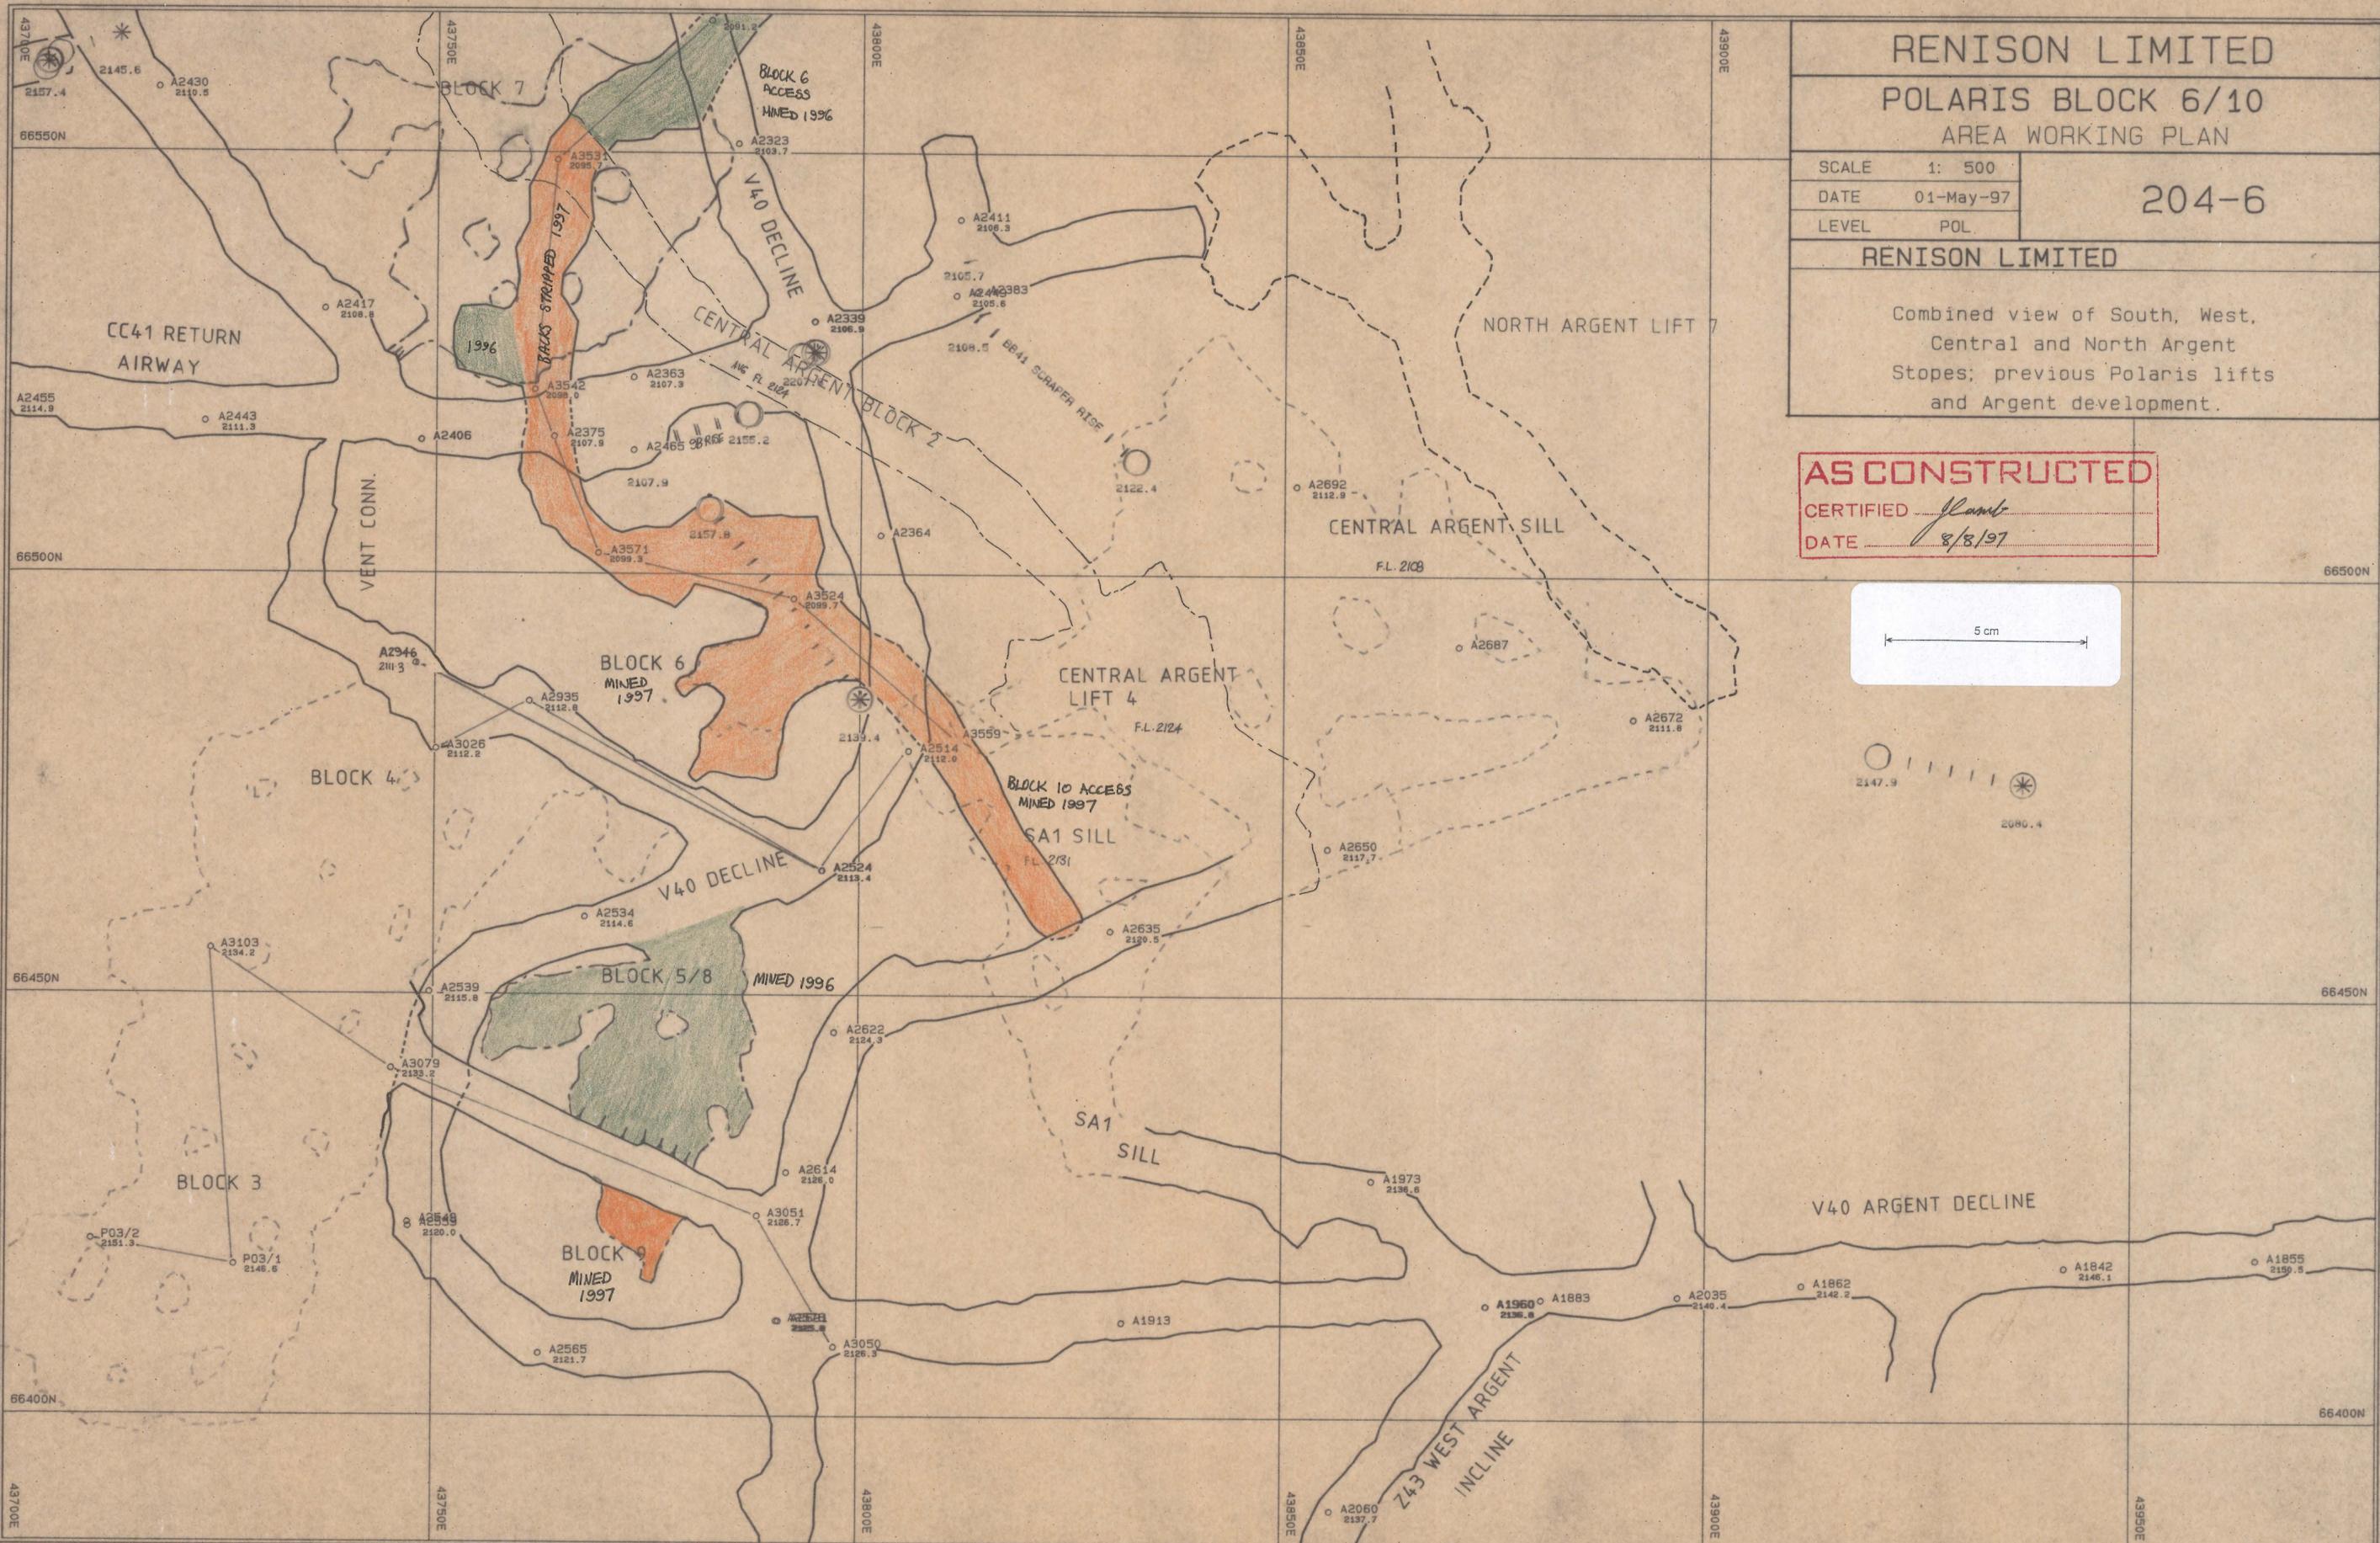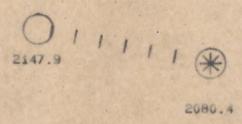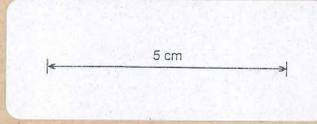

jd.pst:det:od