


0376\_763

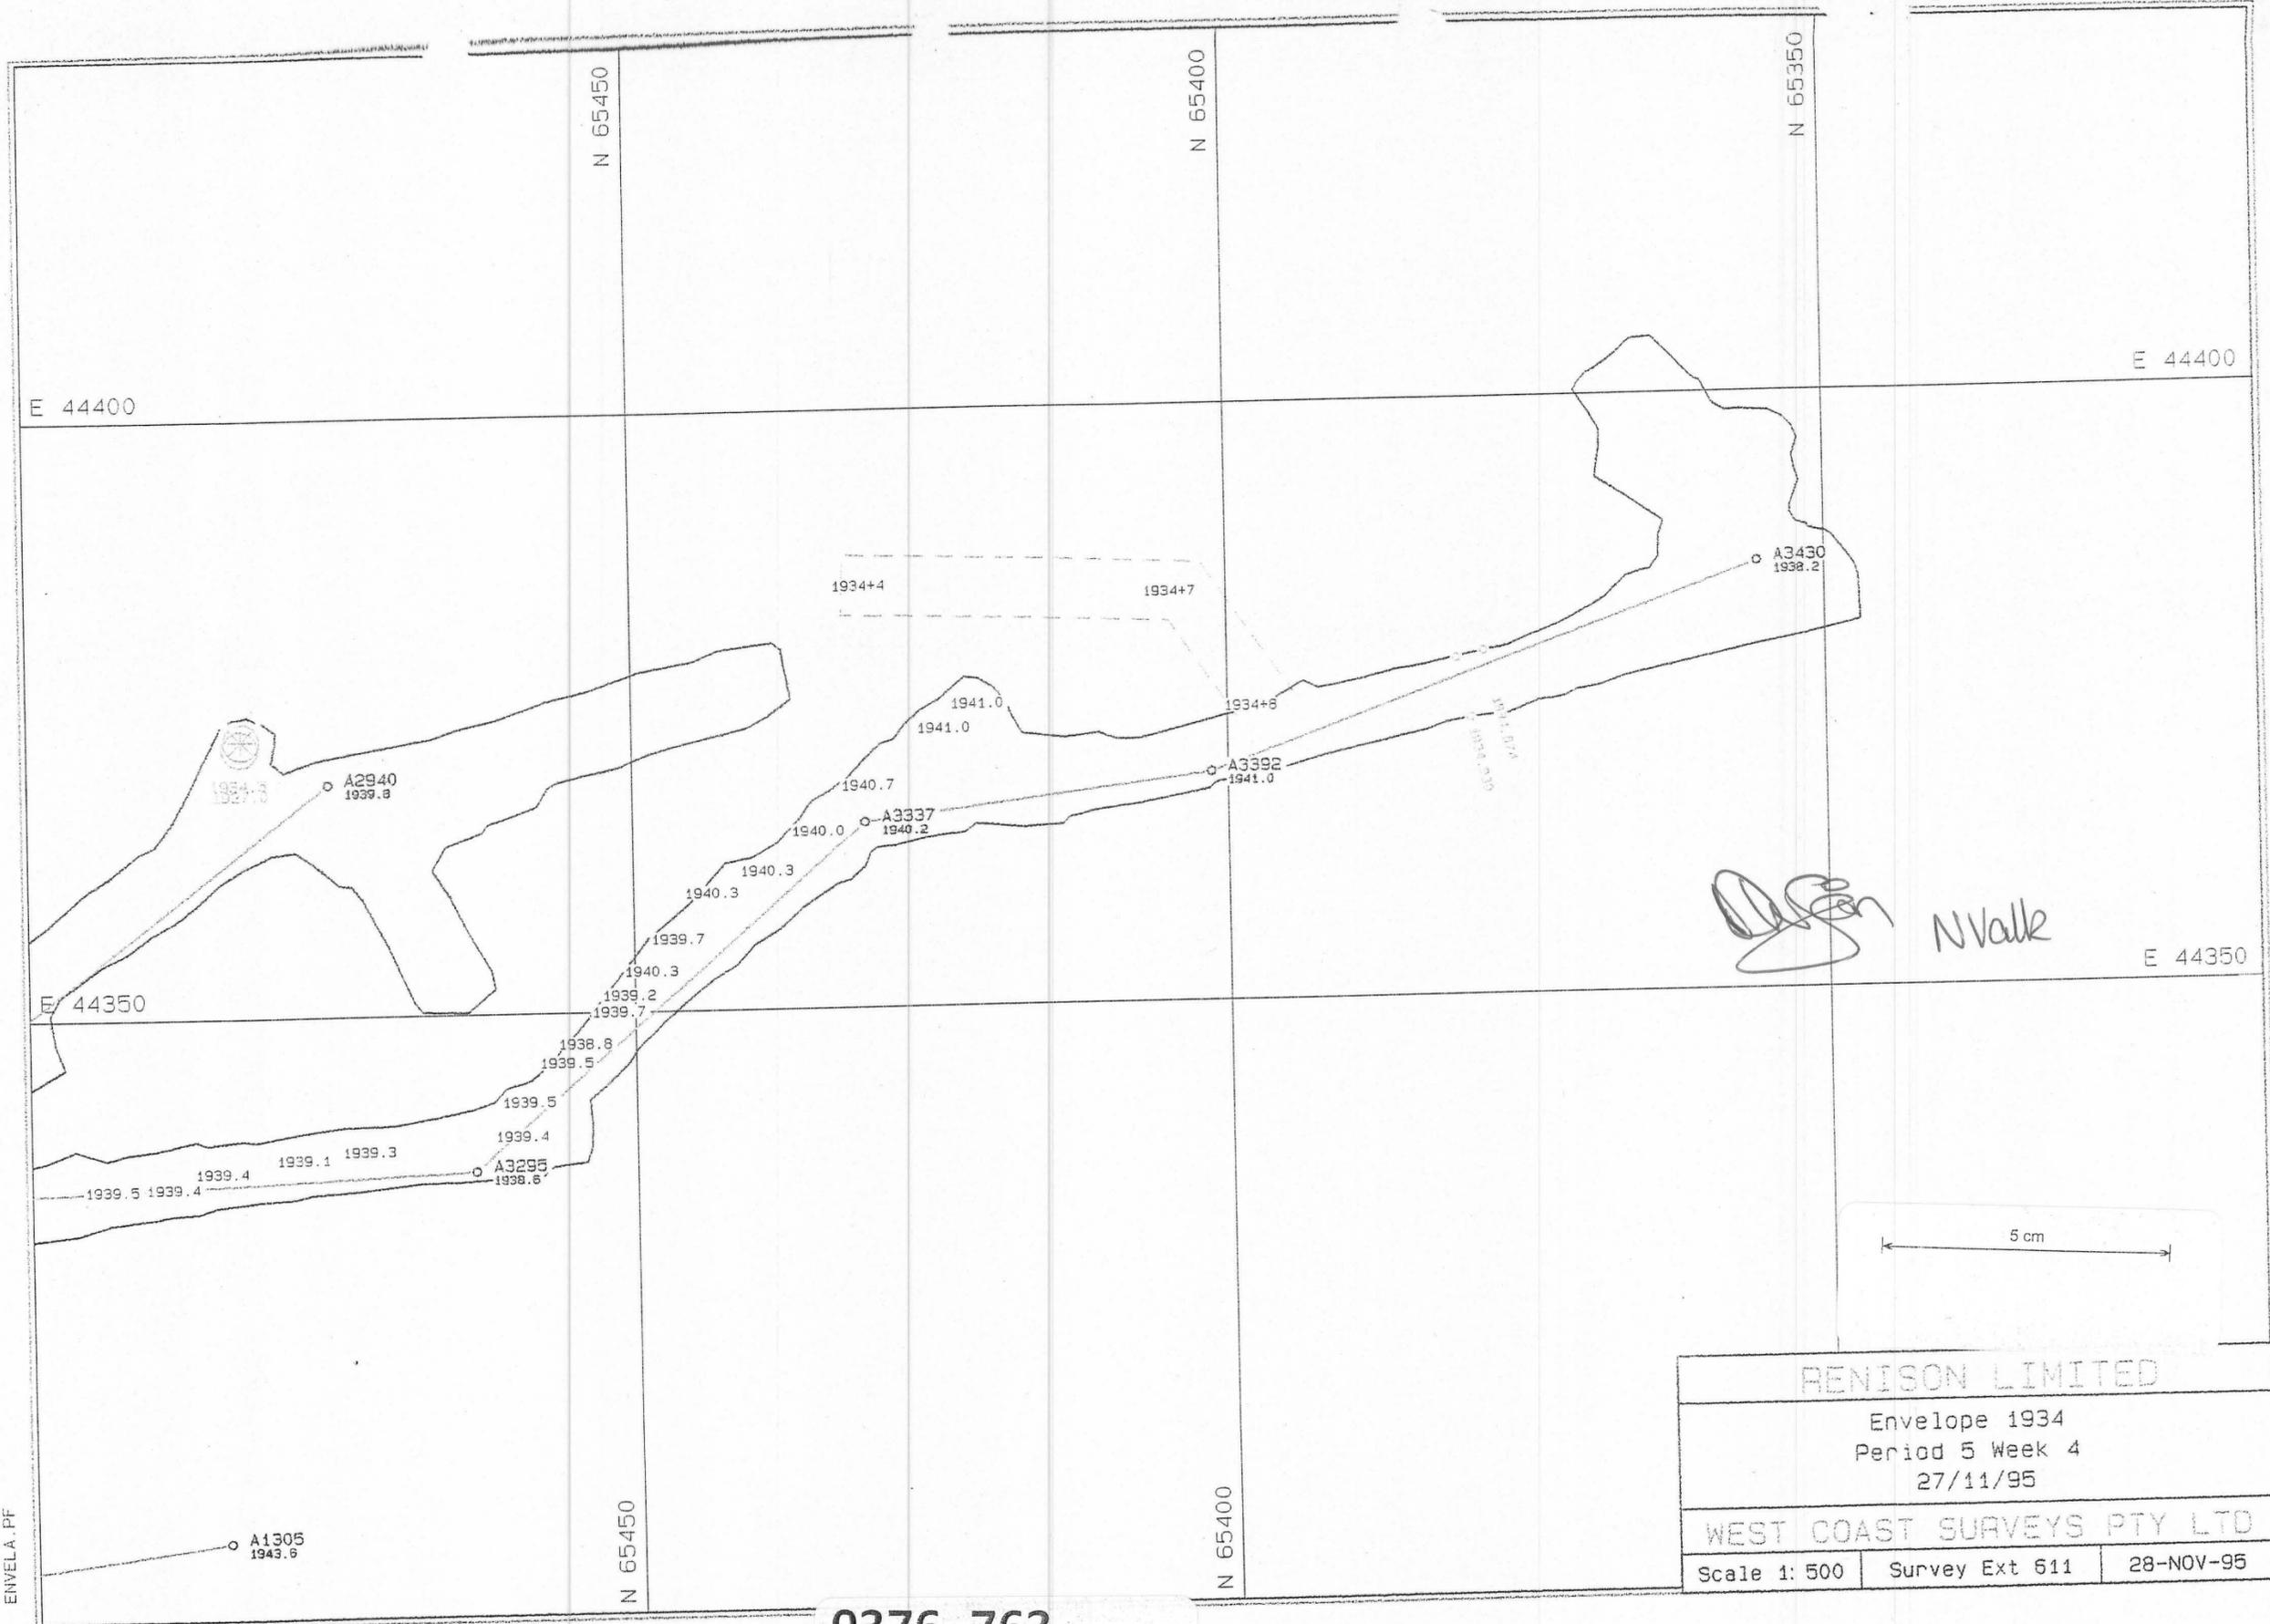

RENISON LIMITED		
Envelope 1934		
Period 5 Week 4		
27/11/95		
WEST COAST SURVEYS PTY LTD		
Scale 1: 500	Survey Ext 611	28-NOV-95

0376\_763

ENVELA.PF

K