


0376_767

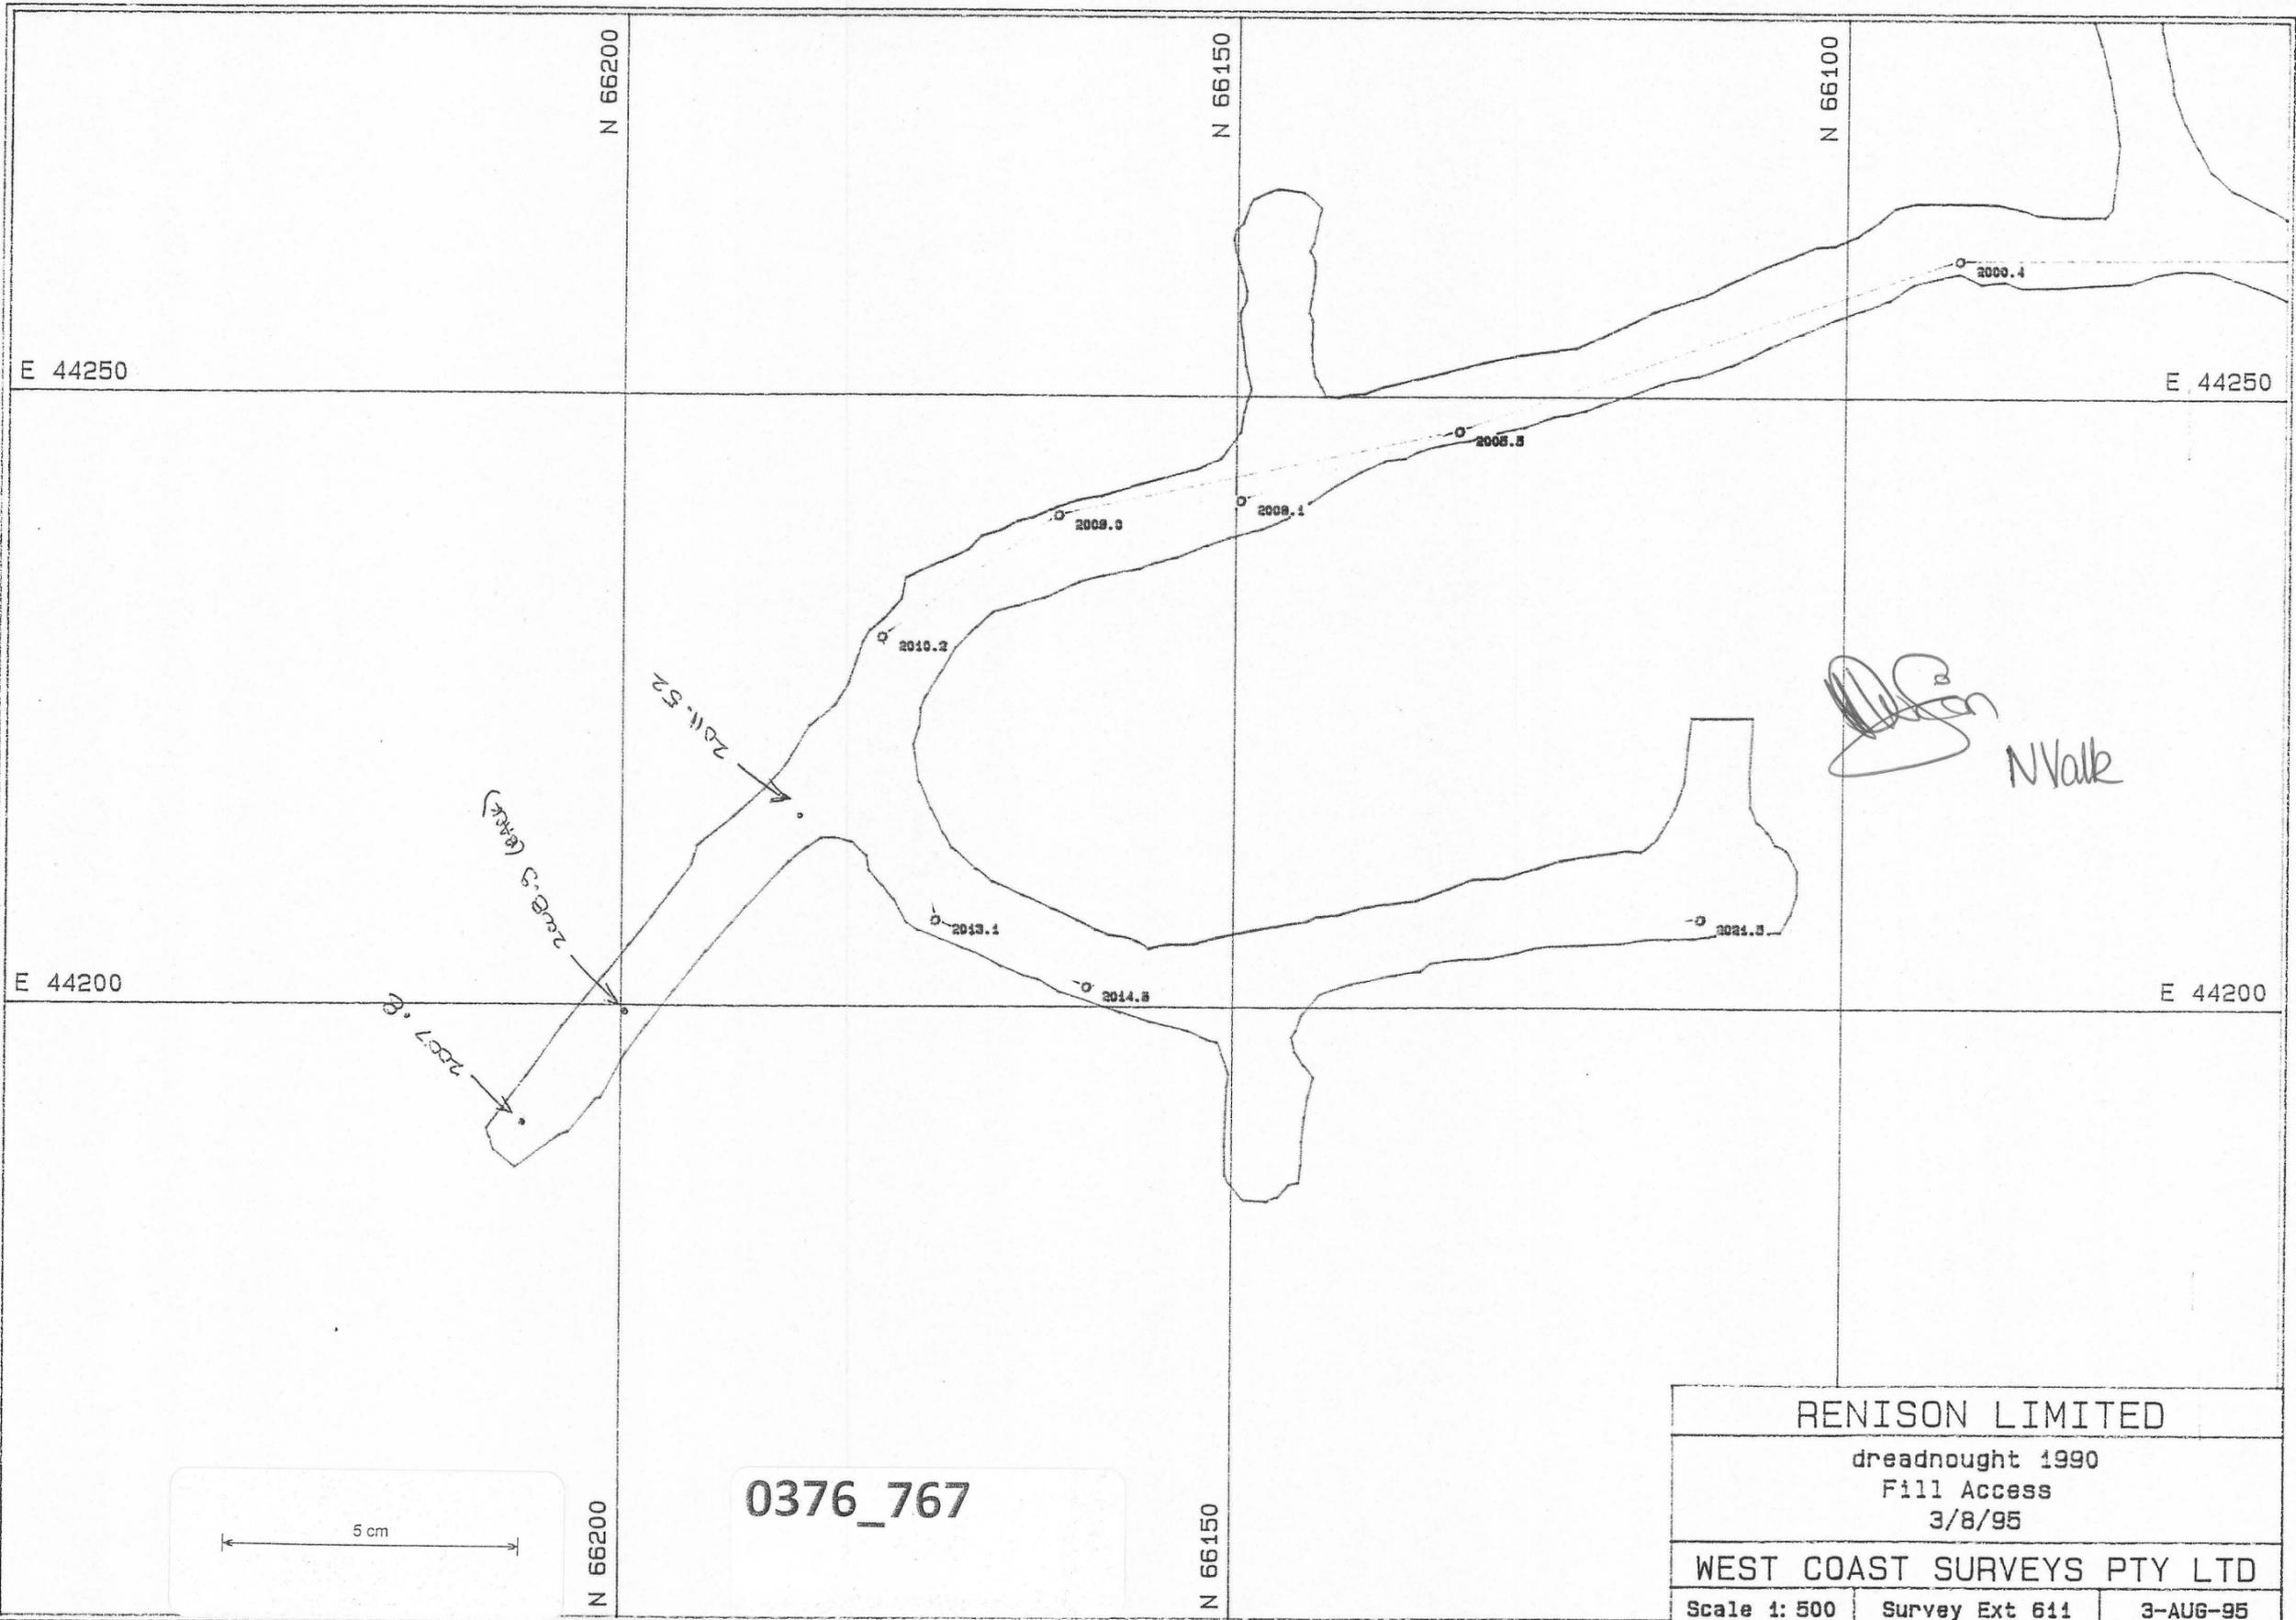

DREADA.PF