


0376\_768

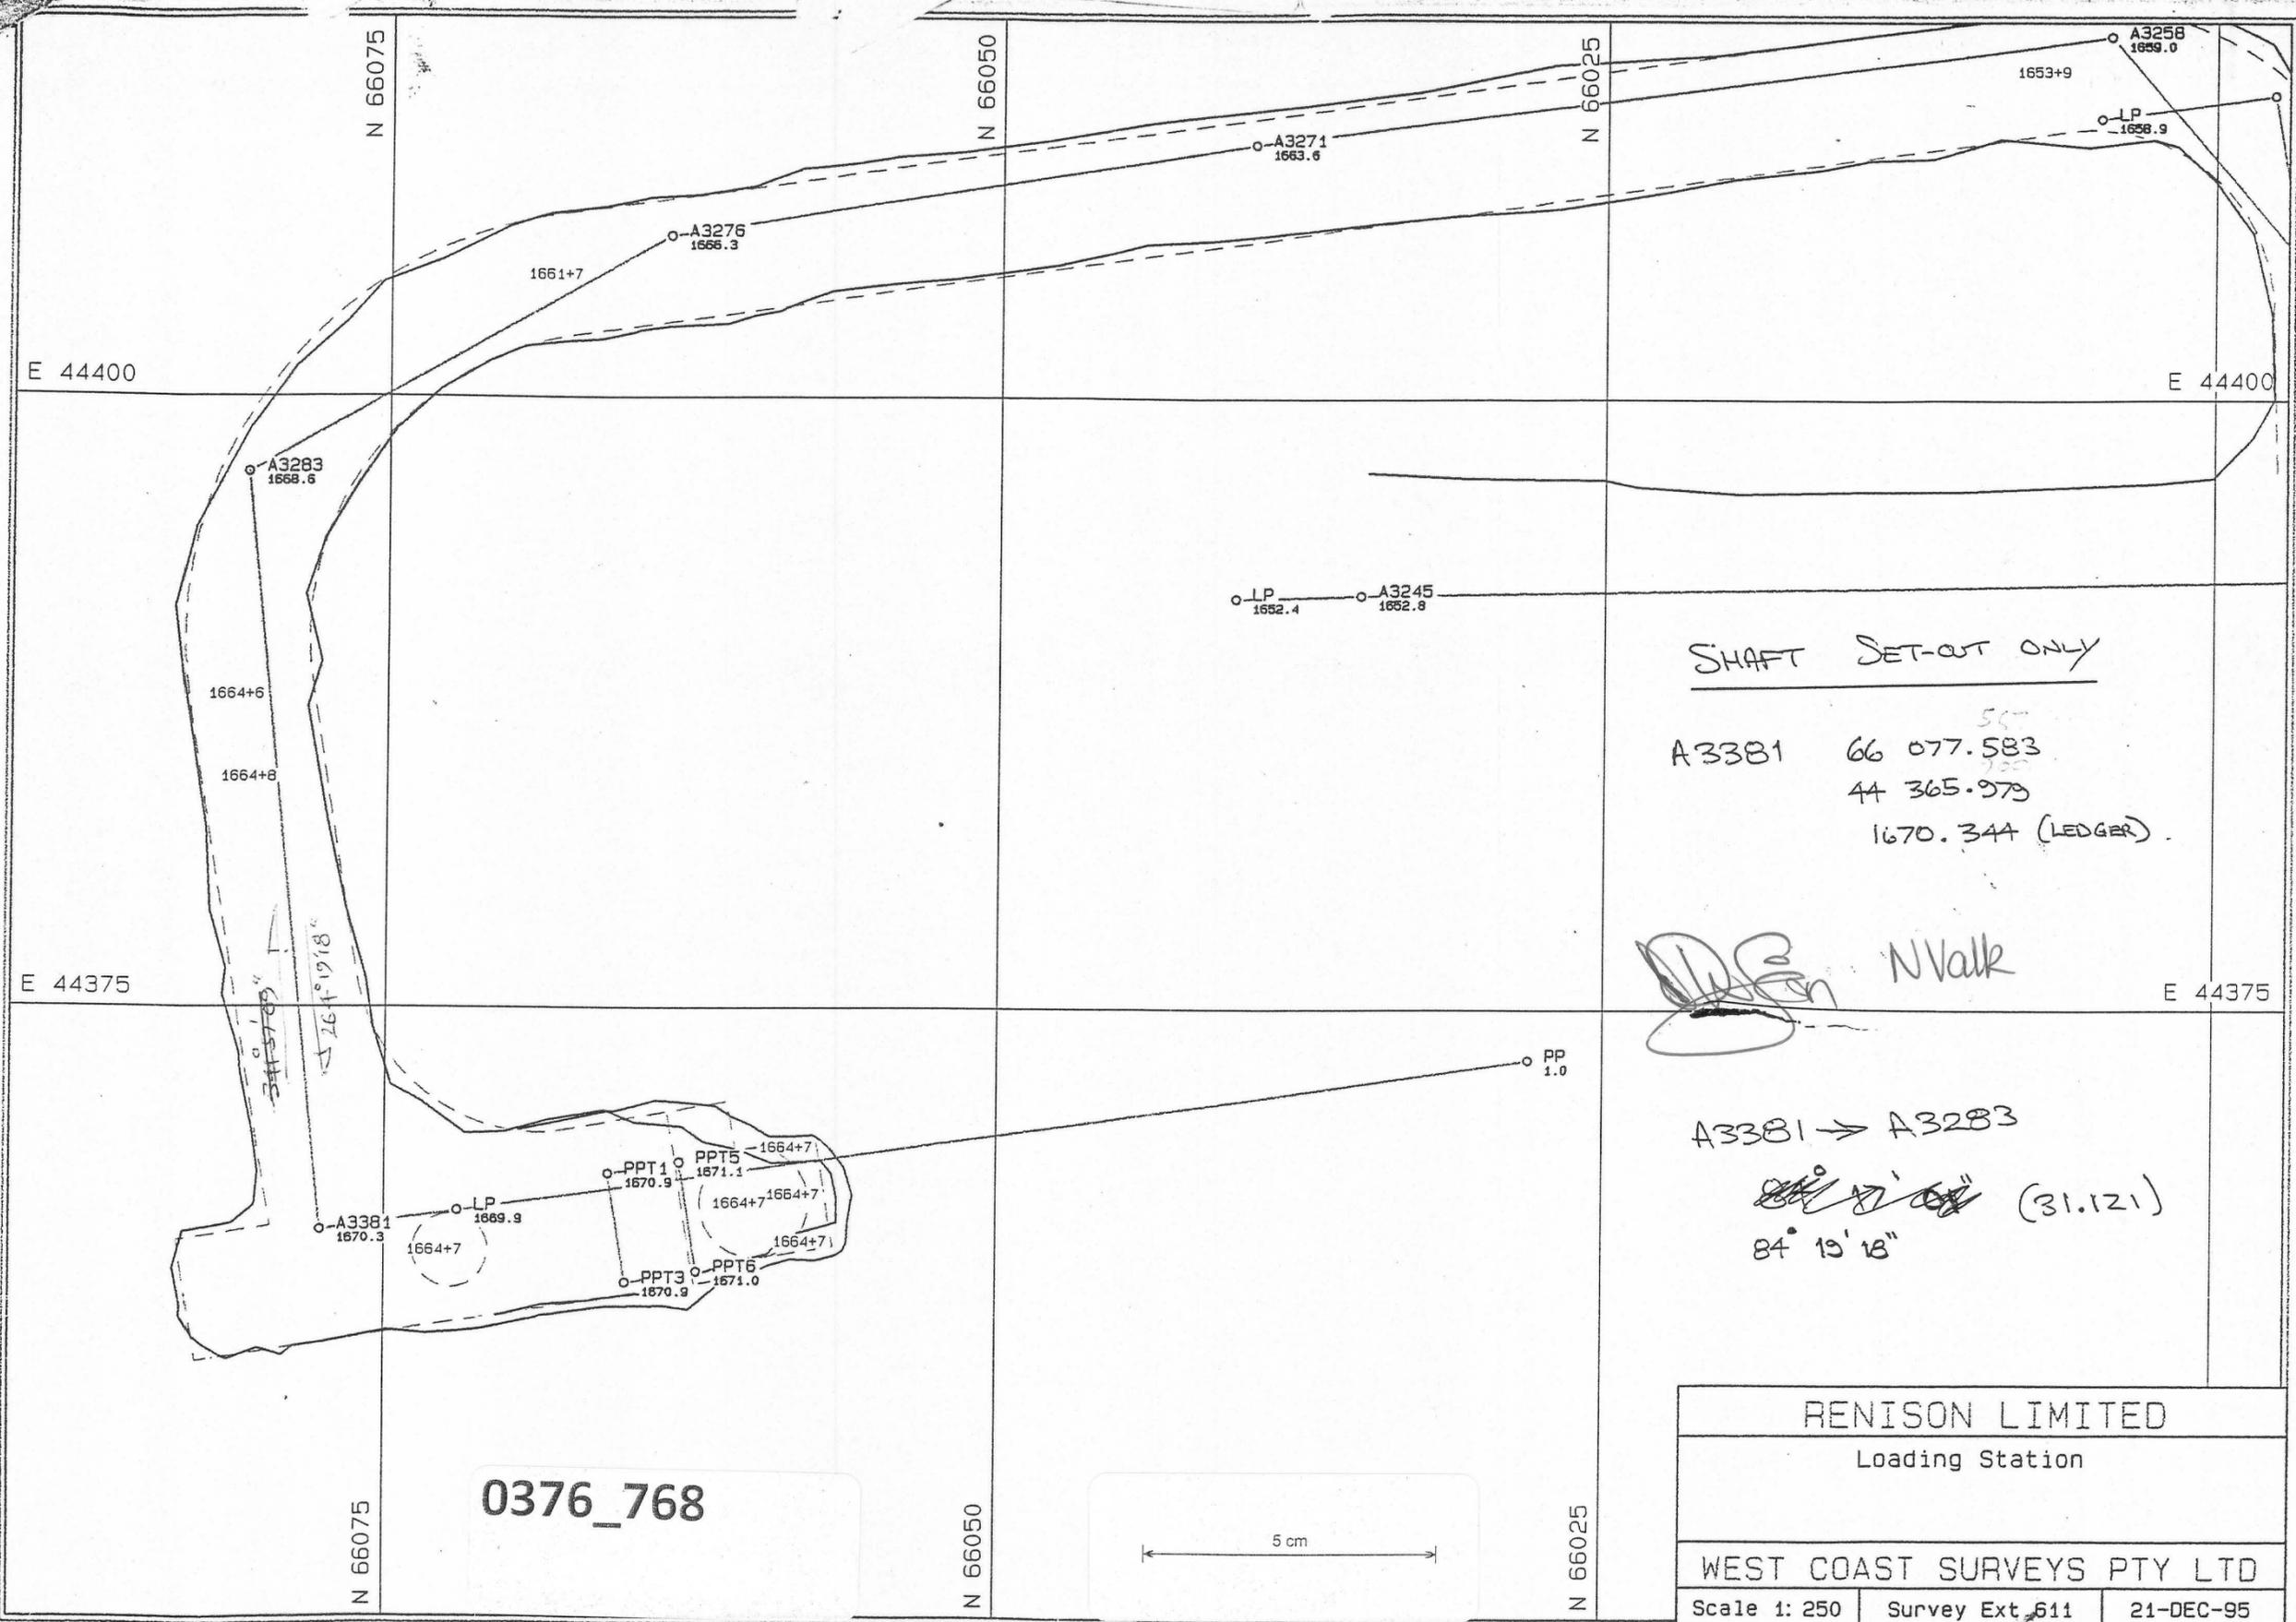

SHAFT SET-OUT ONLY


A3381 66 077.583  
 44 365.979  
 1670.344 (LEDGER)

*W. J. N. Valk*

A3381 → A3283  
~~84° 19' 18"~~ (31.121)  
 84° 19' 18"

RENISON LIMITED		
Loading Station		
WEST COAST SURVEYS PTY LTD		
Scale 1: 250	Survey Ext 611	21-DEC-95

0376\_768

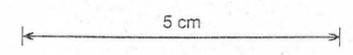

LOADIB.PF