


0376\_769

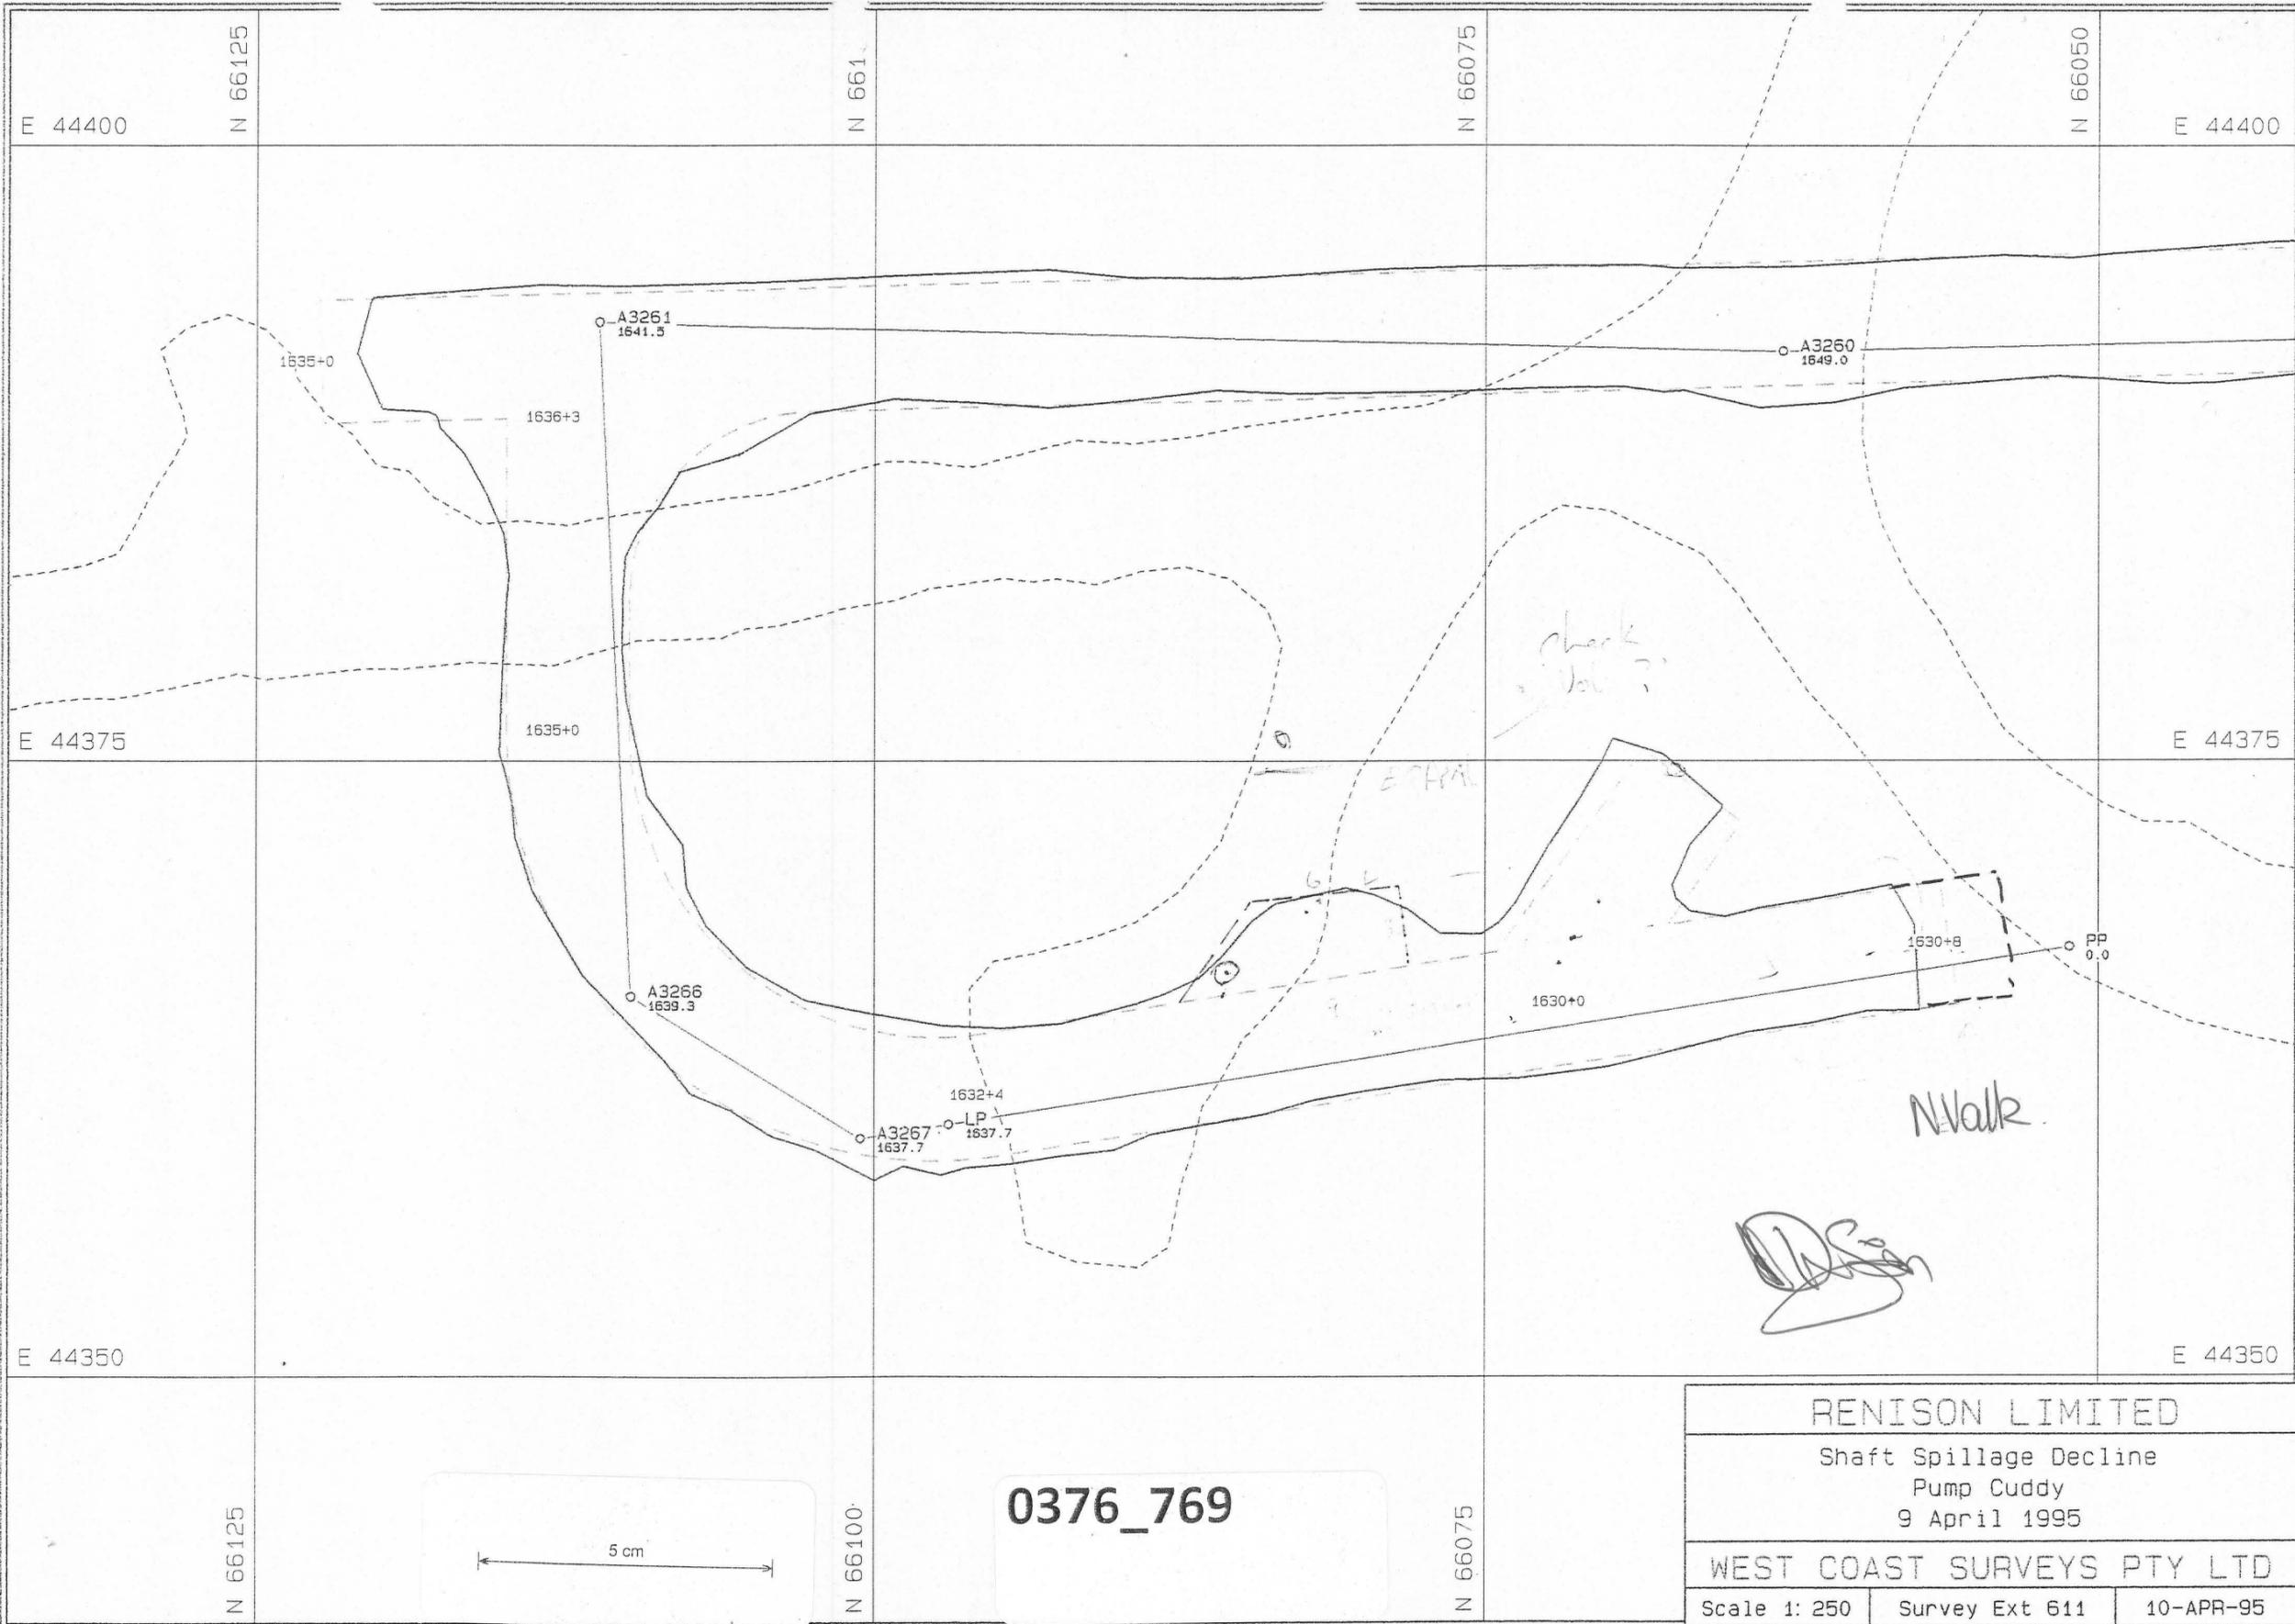

RENISON LIMITED

Shaft Spillage Decline  
Pump Cuddy  
9 April 1995

WEST COAST SURVEYS PTY LTD

Scale 1: 250    Survey Ext 611    10-APR-95

0376\_769

5 cm

SHAFTD.PF