


0376_770

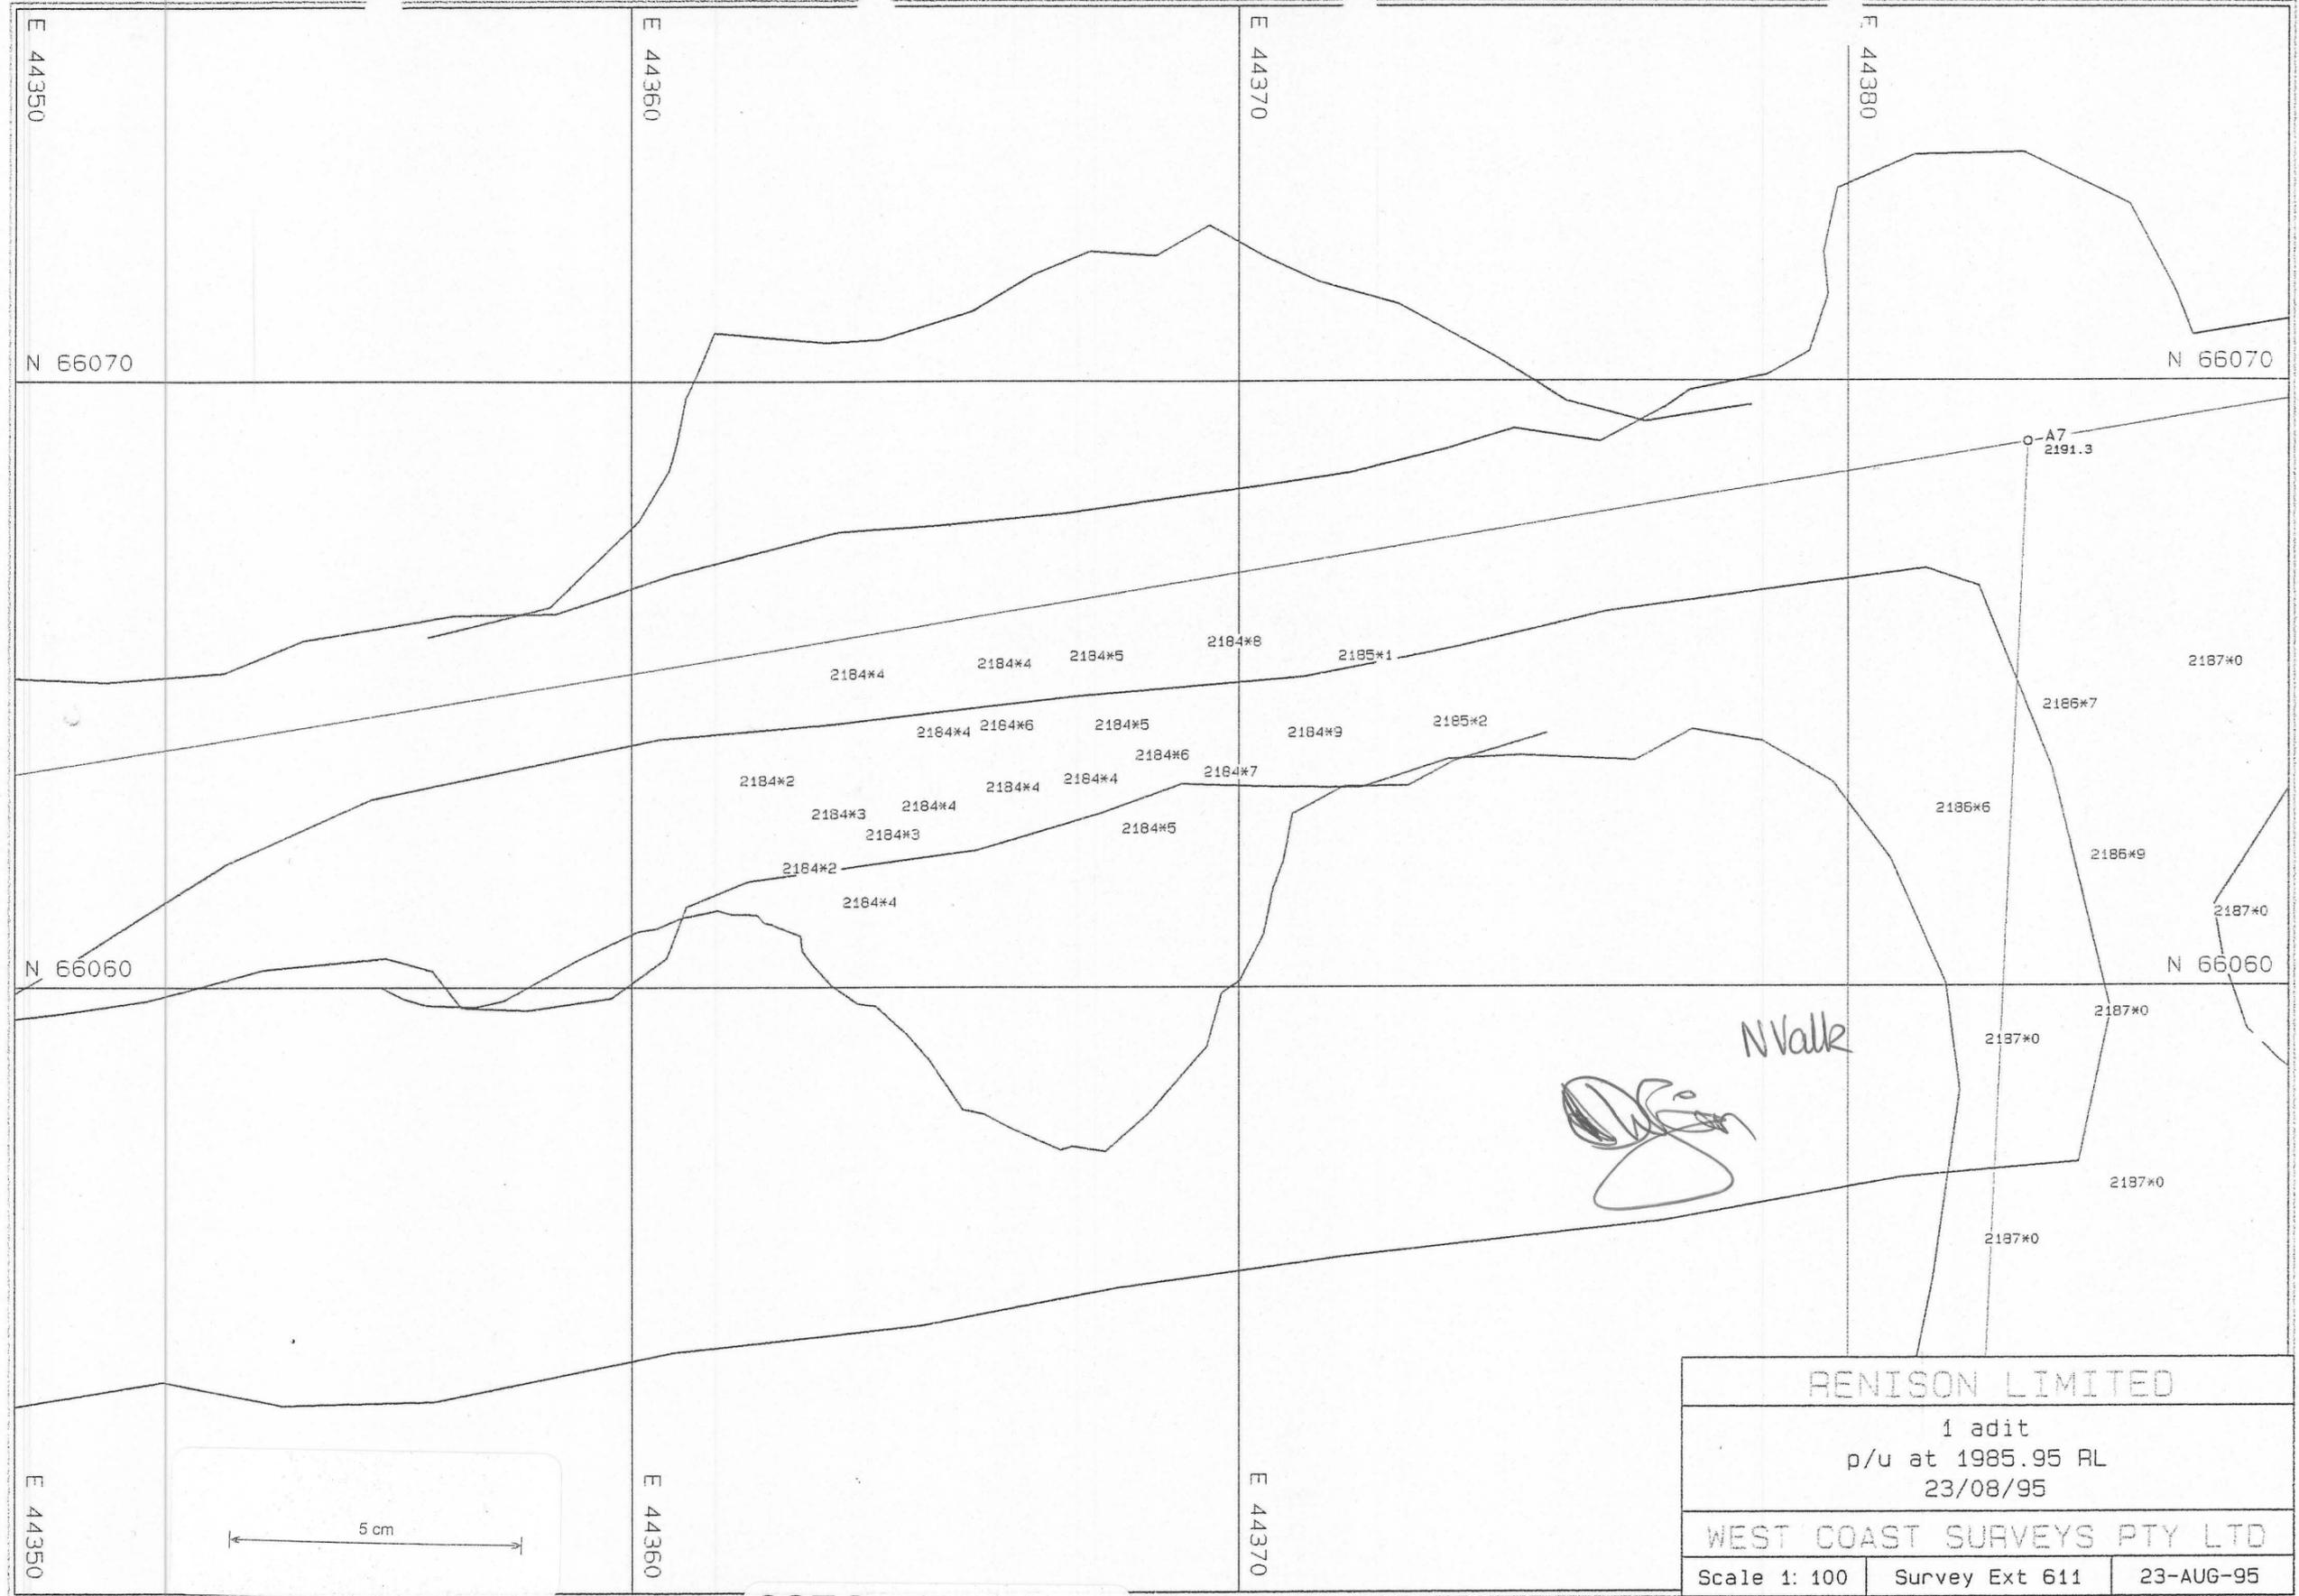

ADITH.PF

E 44350

E 44360

E 44370

E 44380

N 66070

N 66060

N 66070

N 66060

5 cm

RENISON LIMITED

1 adit
p/u at 1985.95 RL
23/08/95

WEST COAST SURVEYS PTY LTD

Scale 1: 100 | Survey Ext 611 | 23-AUG-95

0376_770