


0376_772

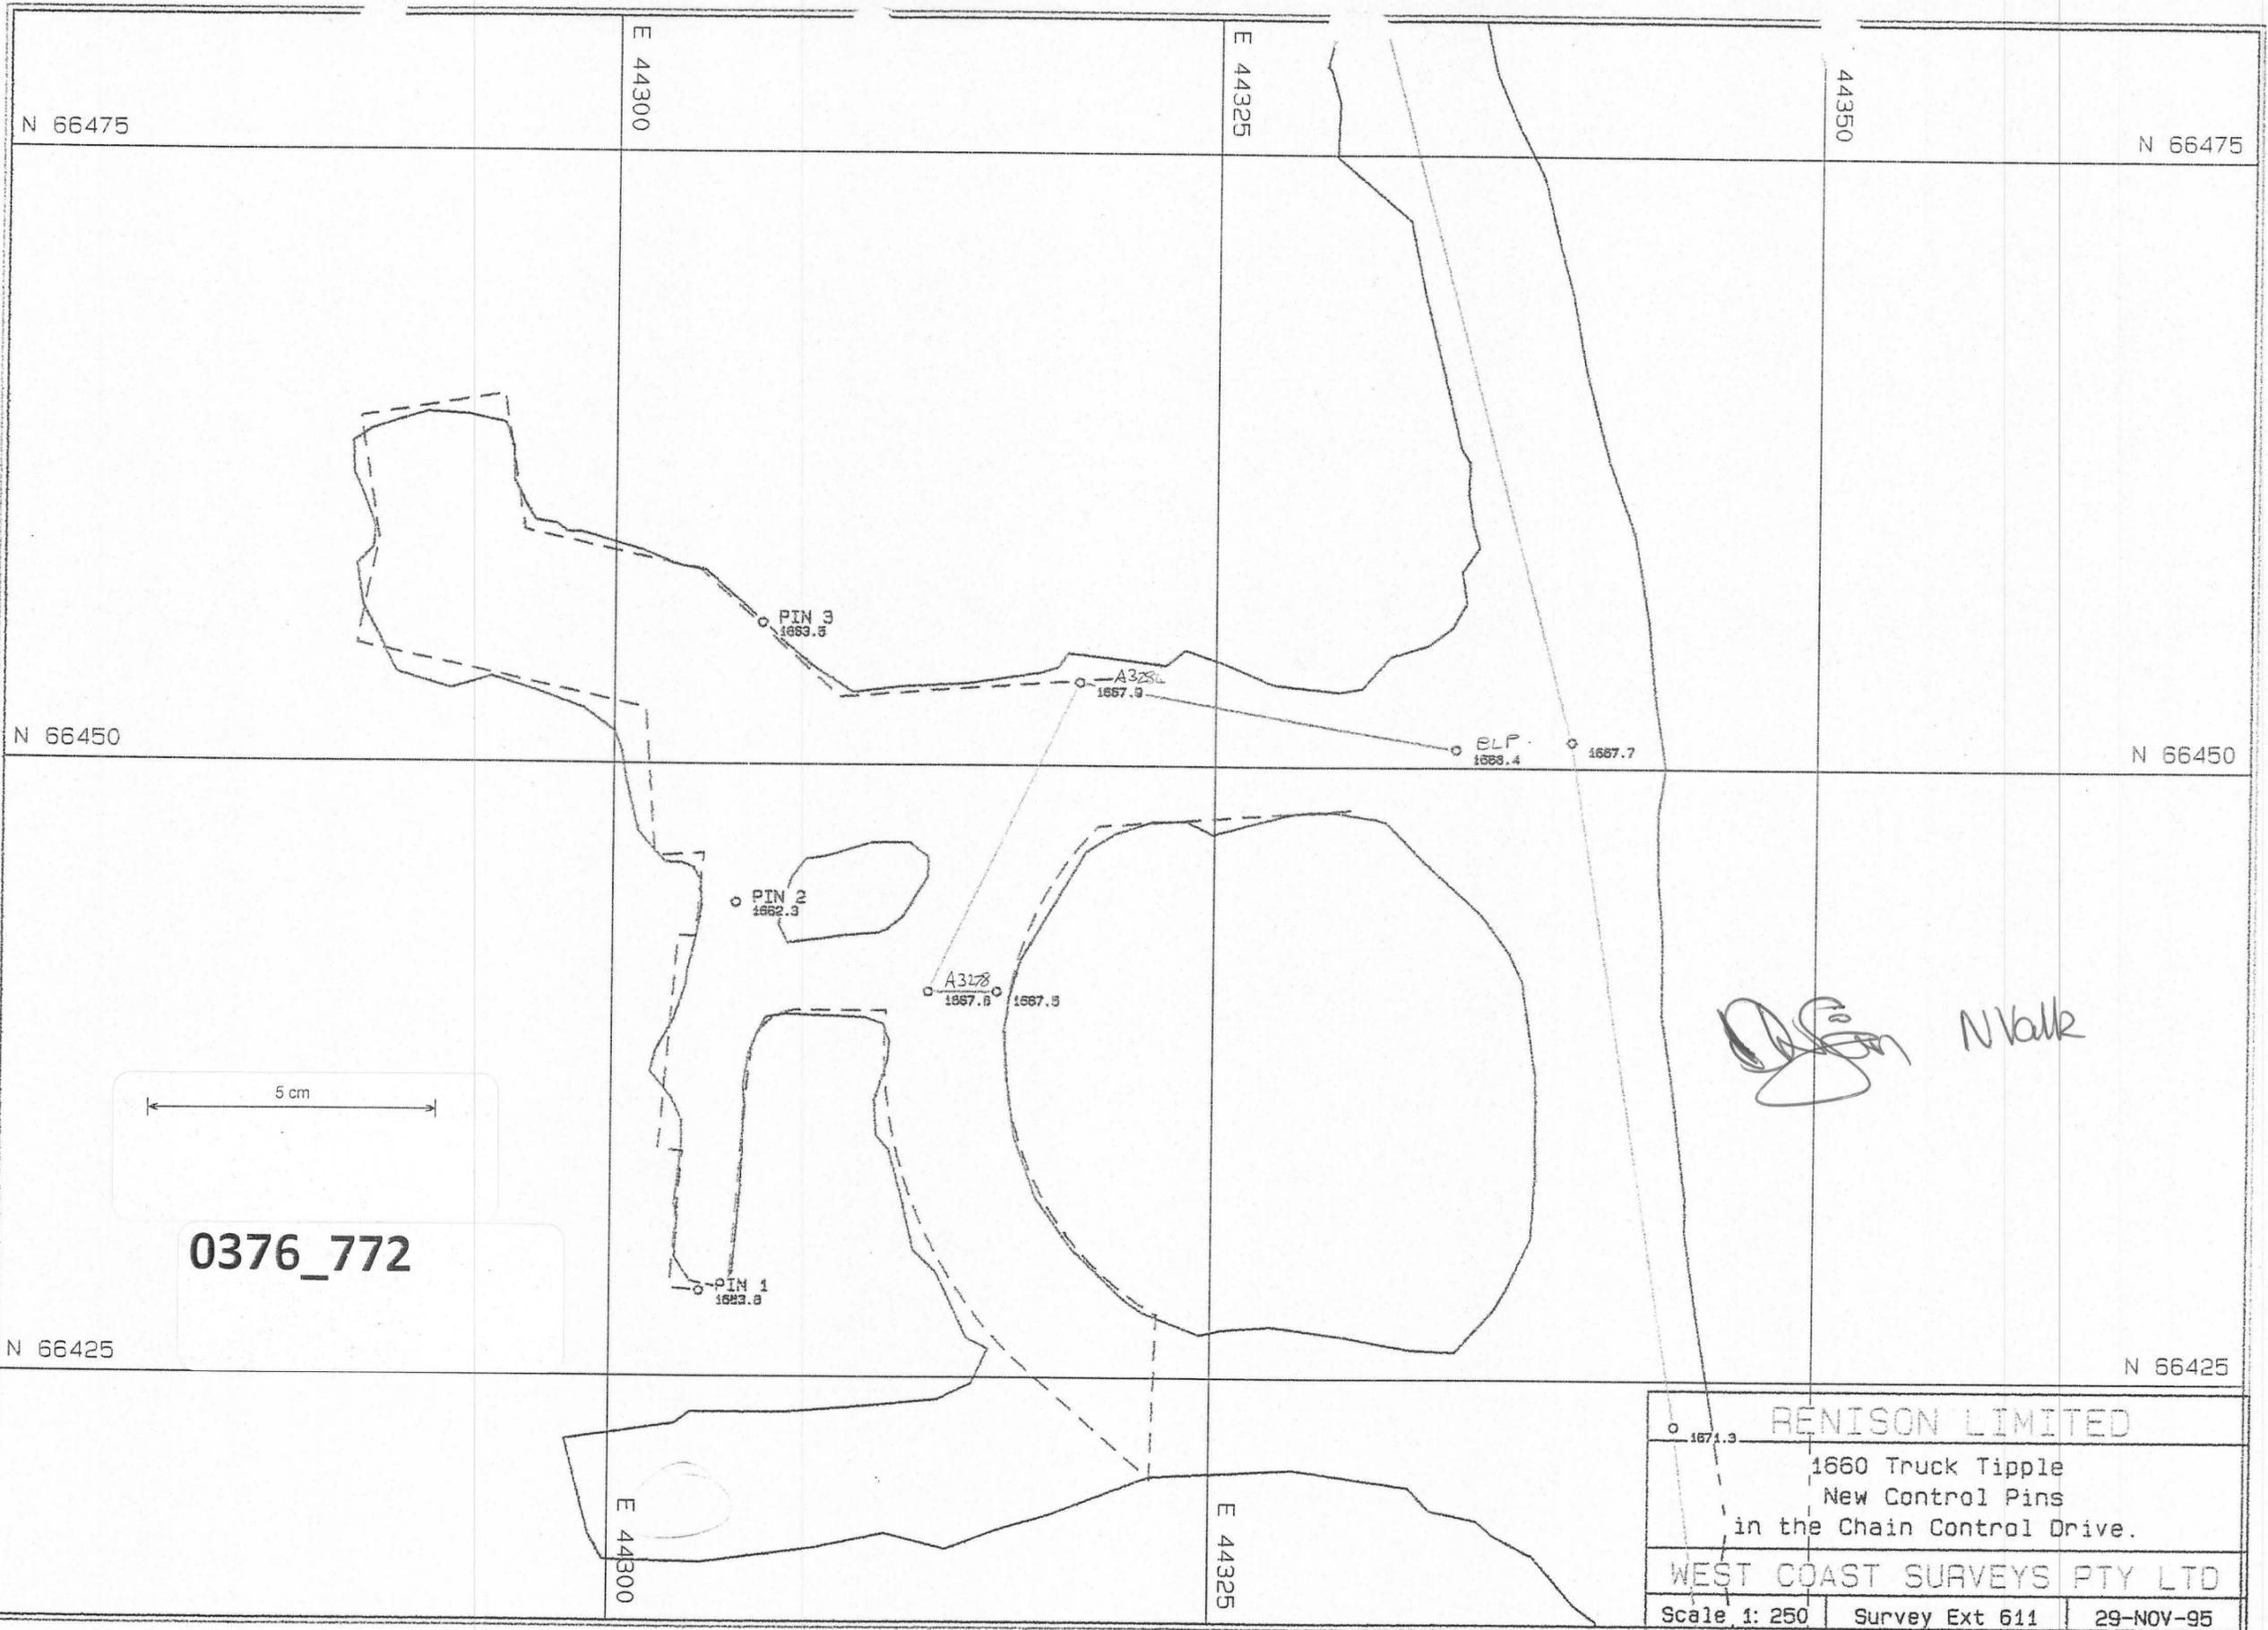

[Handwritten Signature] N Walk

0376_772

1671.3 RENISON LIMITED		
1660 Truck Tipple New Control Pins in the Chain Control Drive.		
WEST COAST SURVEYS PTY LTD		
Scale 1: 250	Survey Ext 611	29-NOV-95

TRUCKB.PF