


0376\_773

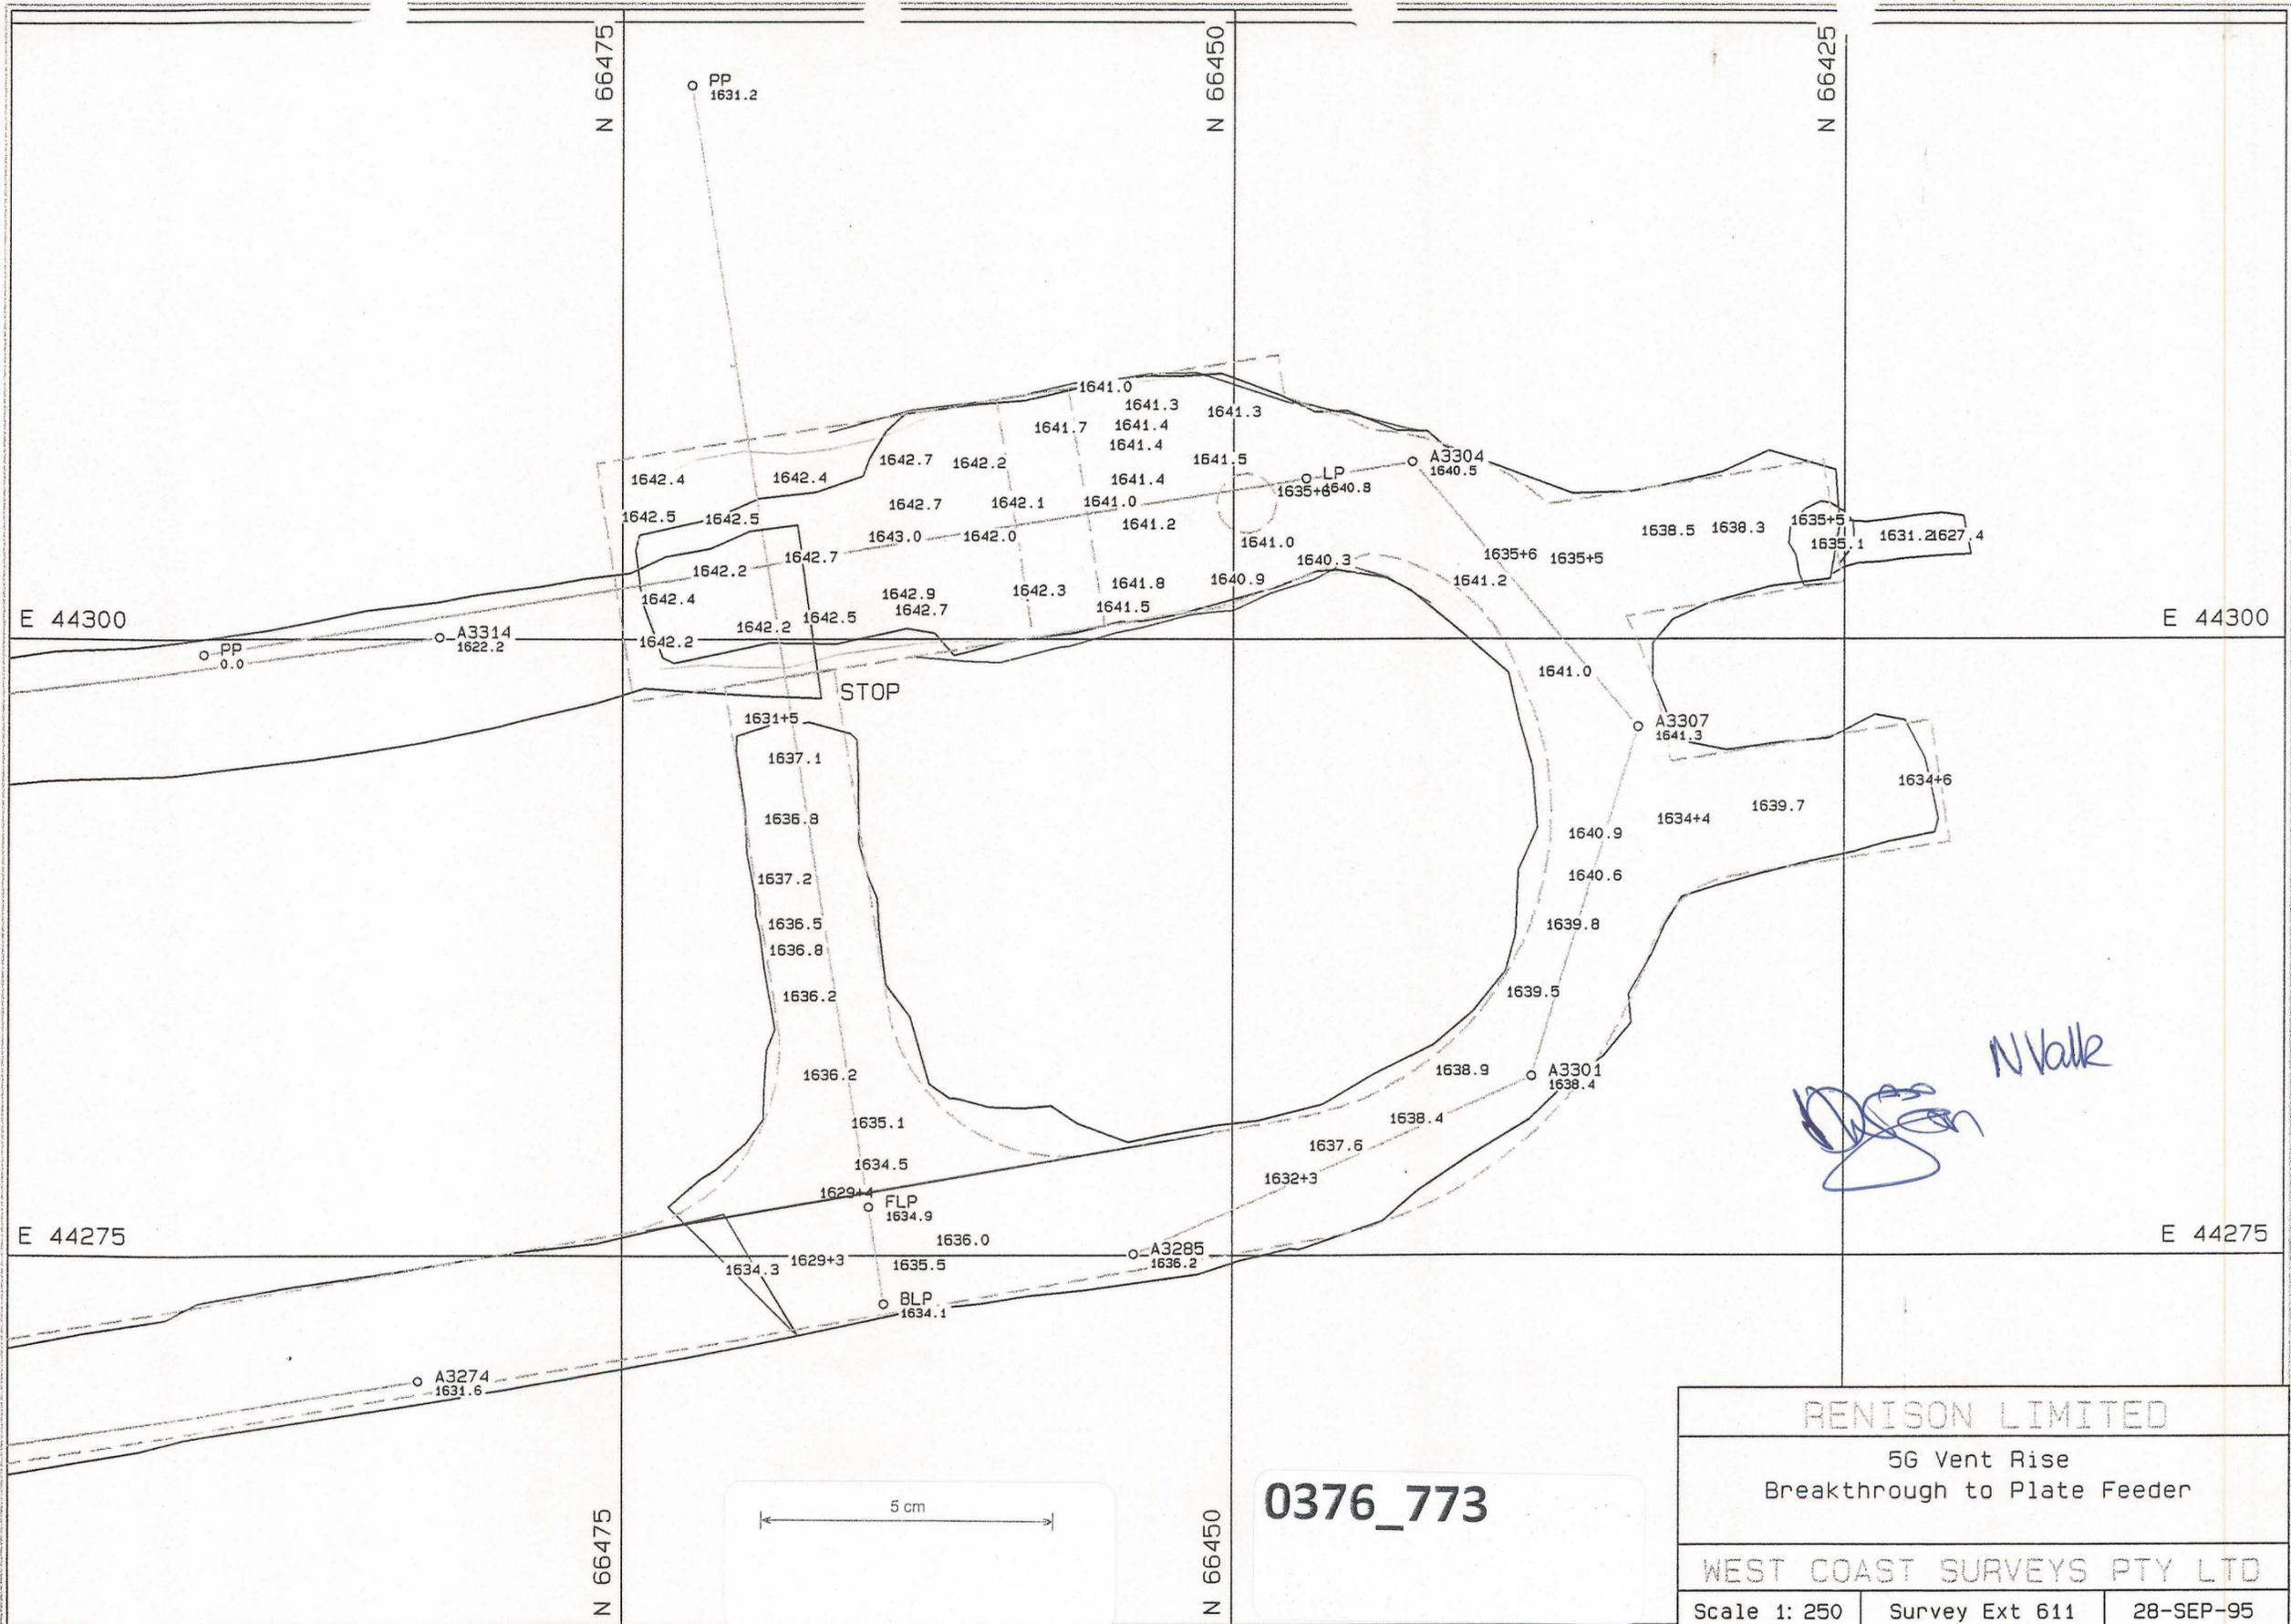

RENISON LIMITED		
5G Vent Rise Breakthrough to Plate Feeder		
WEST COAST SURVEYS PTY LTD		
Scale 1: 250	Survey Ext 611	28-SEP-95

CRUSHB.PF