


0376\_774

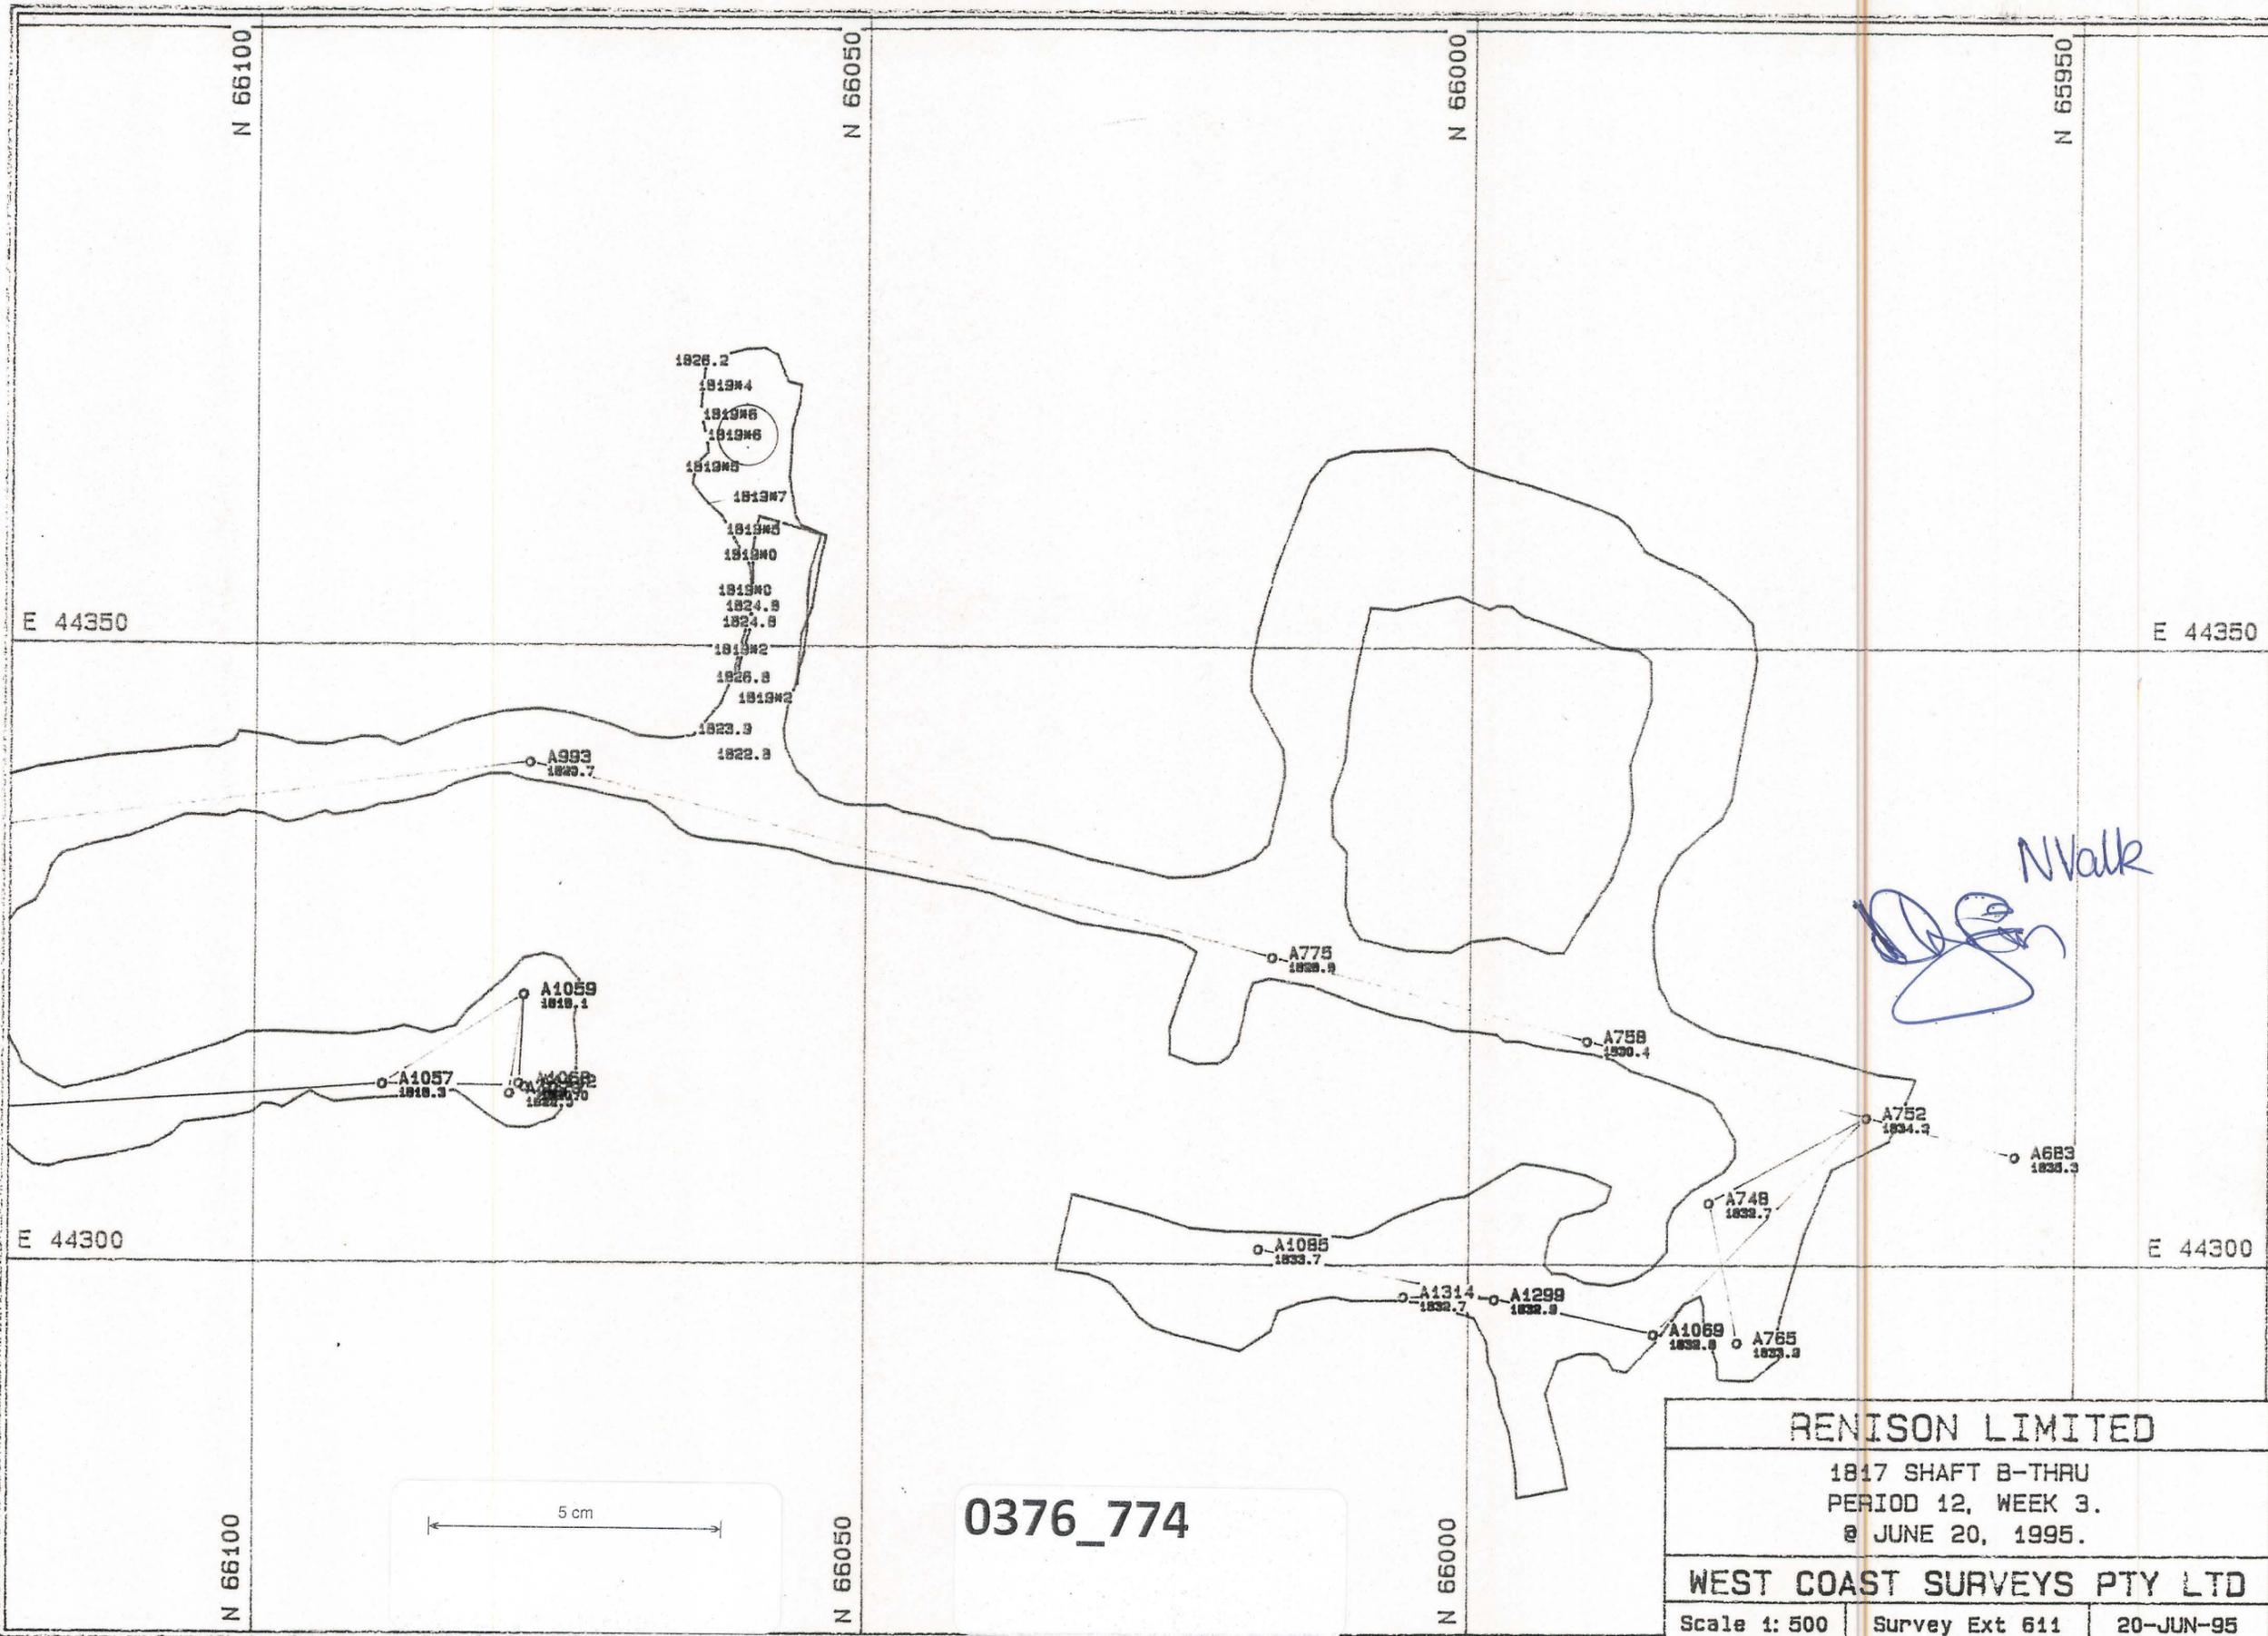

|   |                |           |
|---|----------------|-----------|
| <b>RENISON LIMITED</b>                                      |                |           |
| 1817 SHAFT B-THRU<br>PERIOD 12, WEEK 3.<br>@ JUNE 20, 1995. |                |           |
| <b>WEST COAST SURVEYS PTY LTD</b>                           |                |           |
| Scale 1: 500  | Survey Ext 611 | 20-JUN-95 |

0376\_774

1830SC.PF