


0376_775

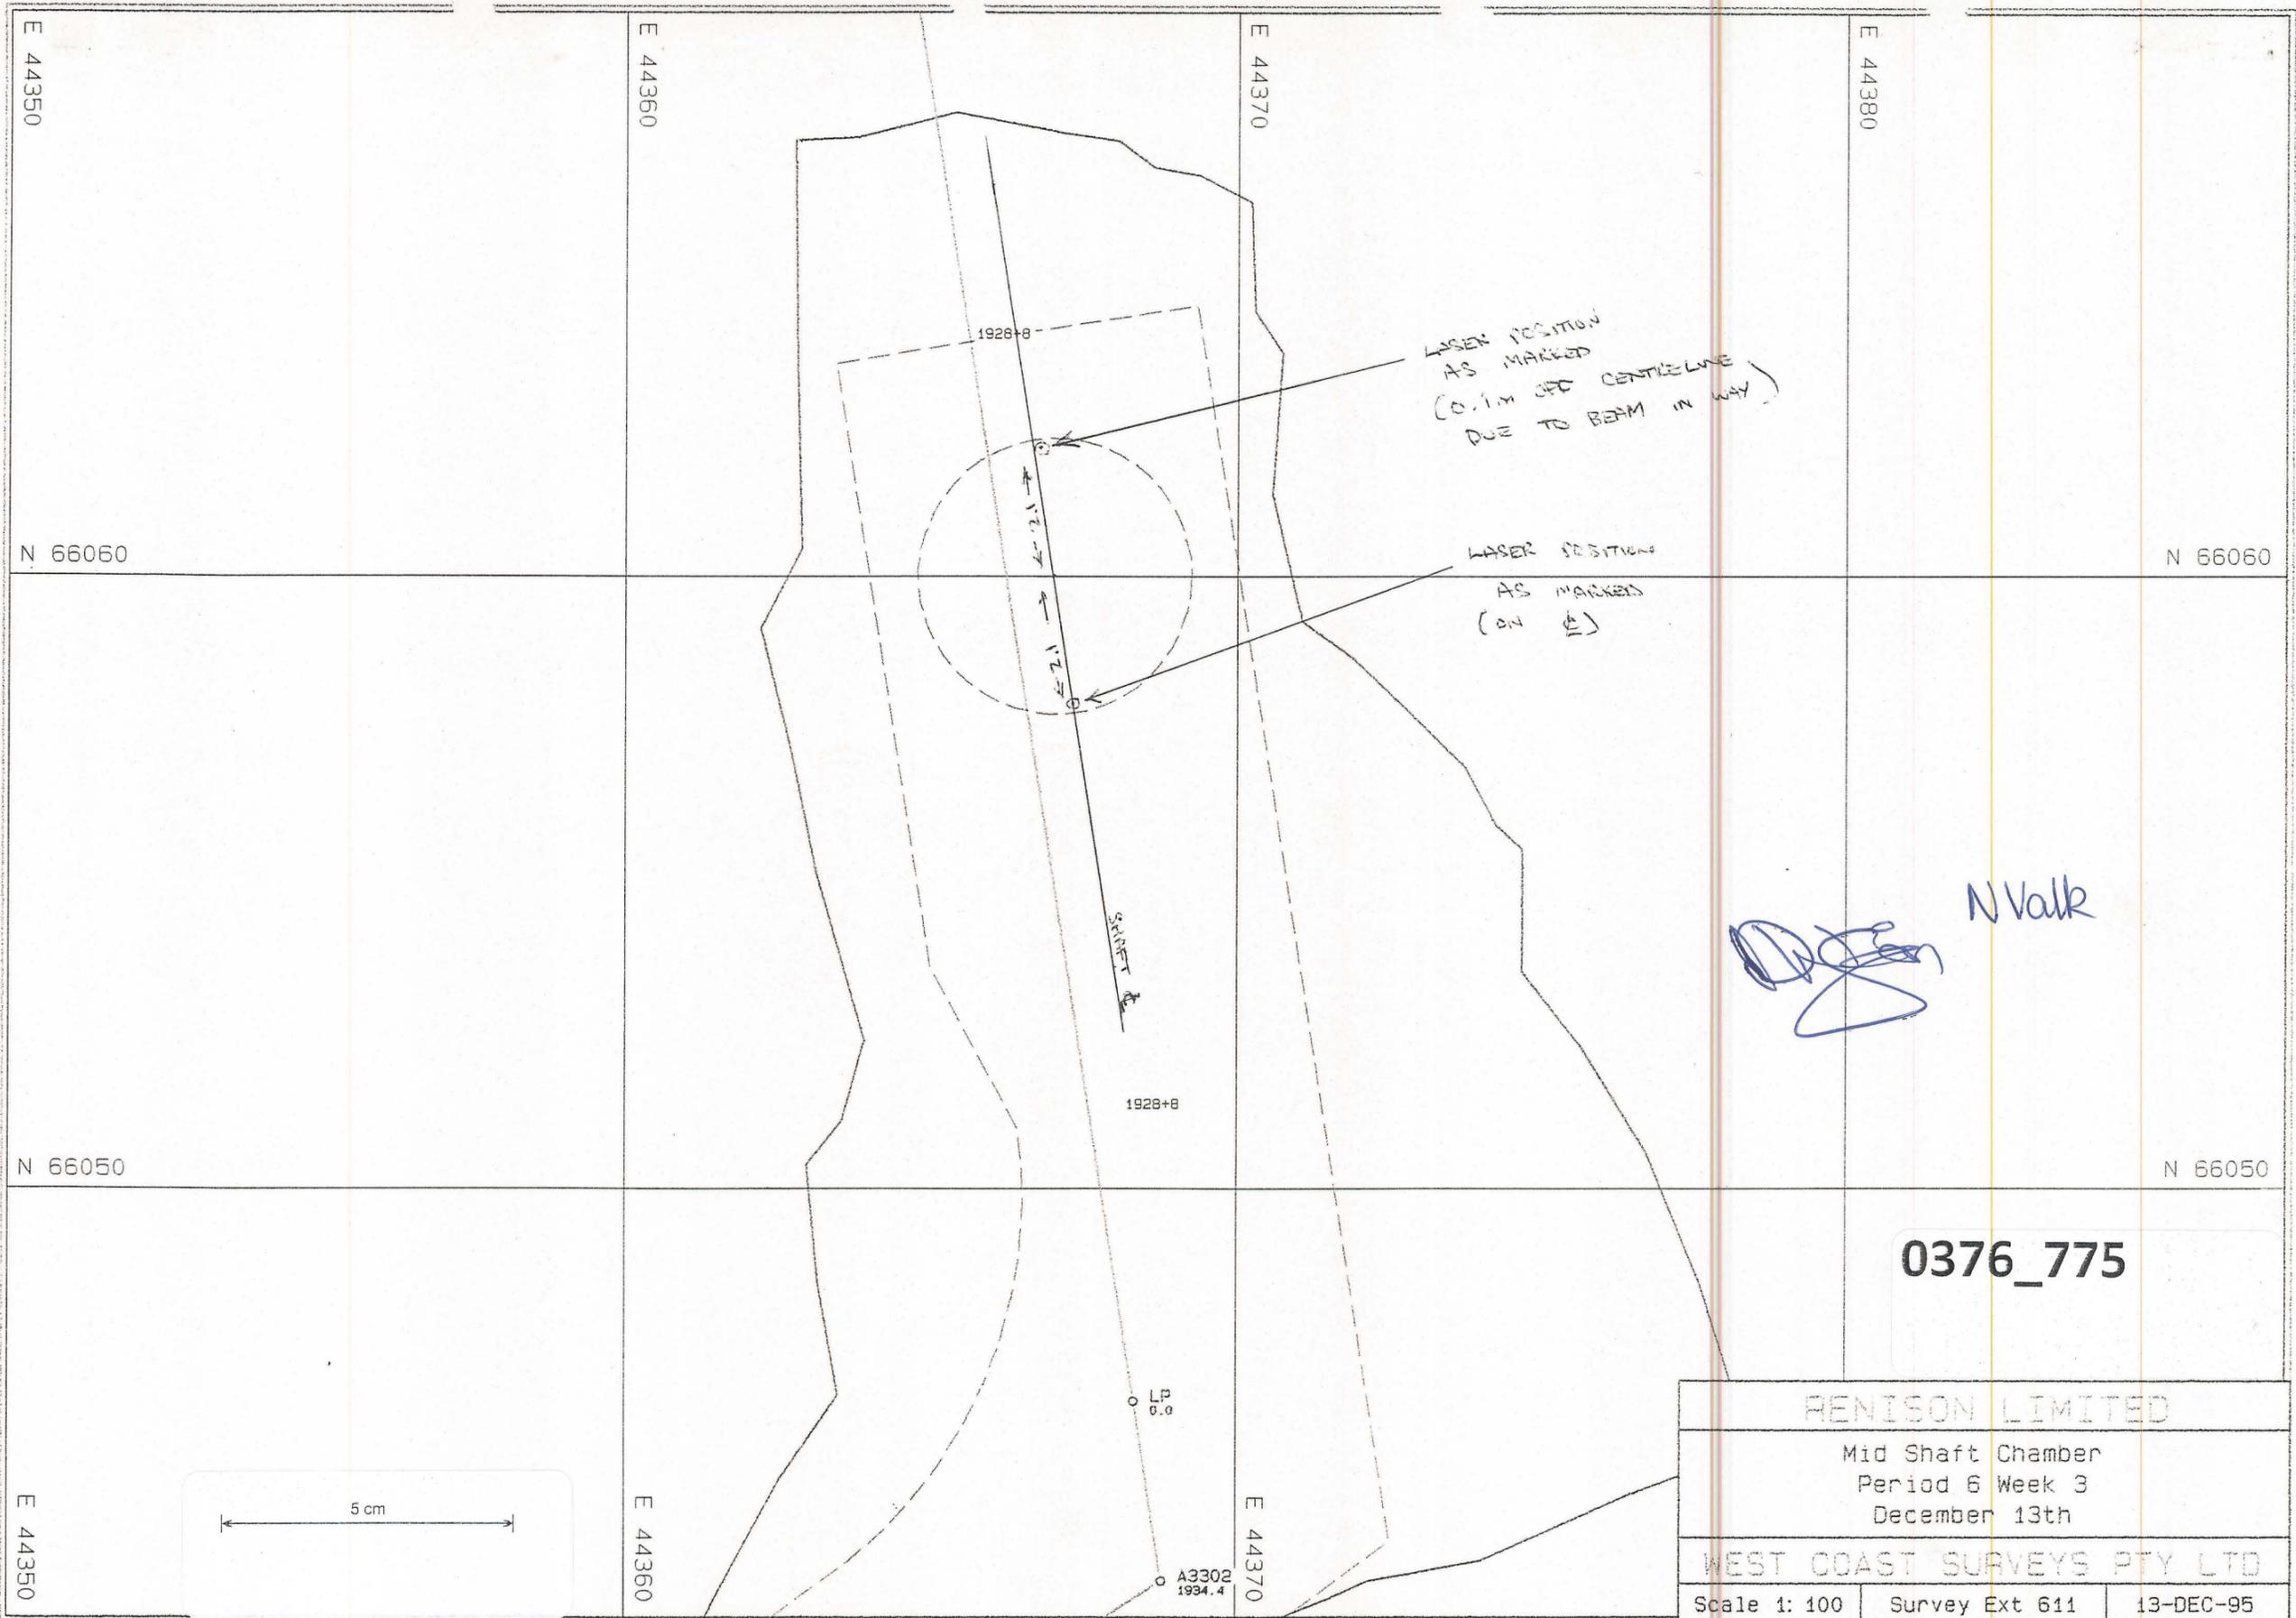

E 44350

E 44360

E 44370

E 44380

N 66060

N 66060

N 66050

N 66050

E 44350

E 44360

E 44370

0376_775

RENISON LIMITED

Mid Shaft Chamber
Period 6 Week 3
December 13th

WEST COAST SURVEYS PTY LTD

Scale 1: 100 | Survey Ext 611 | 13-DEC-95

5 cm

N Valk

SHAFT

1928+8

1928+8

LB
0.0

A3302
1934.4

LASER POSITION
AS MARKED
(0.1m off CENTRELINE
DUE TO BERM IN WAY)

LASER POSITION
AS MARKED
(ON IT)

MDSHF.PF