


0376_777

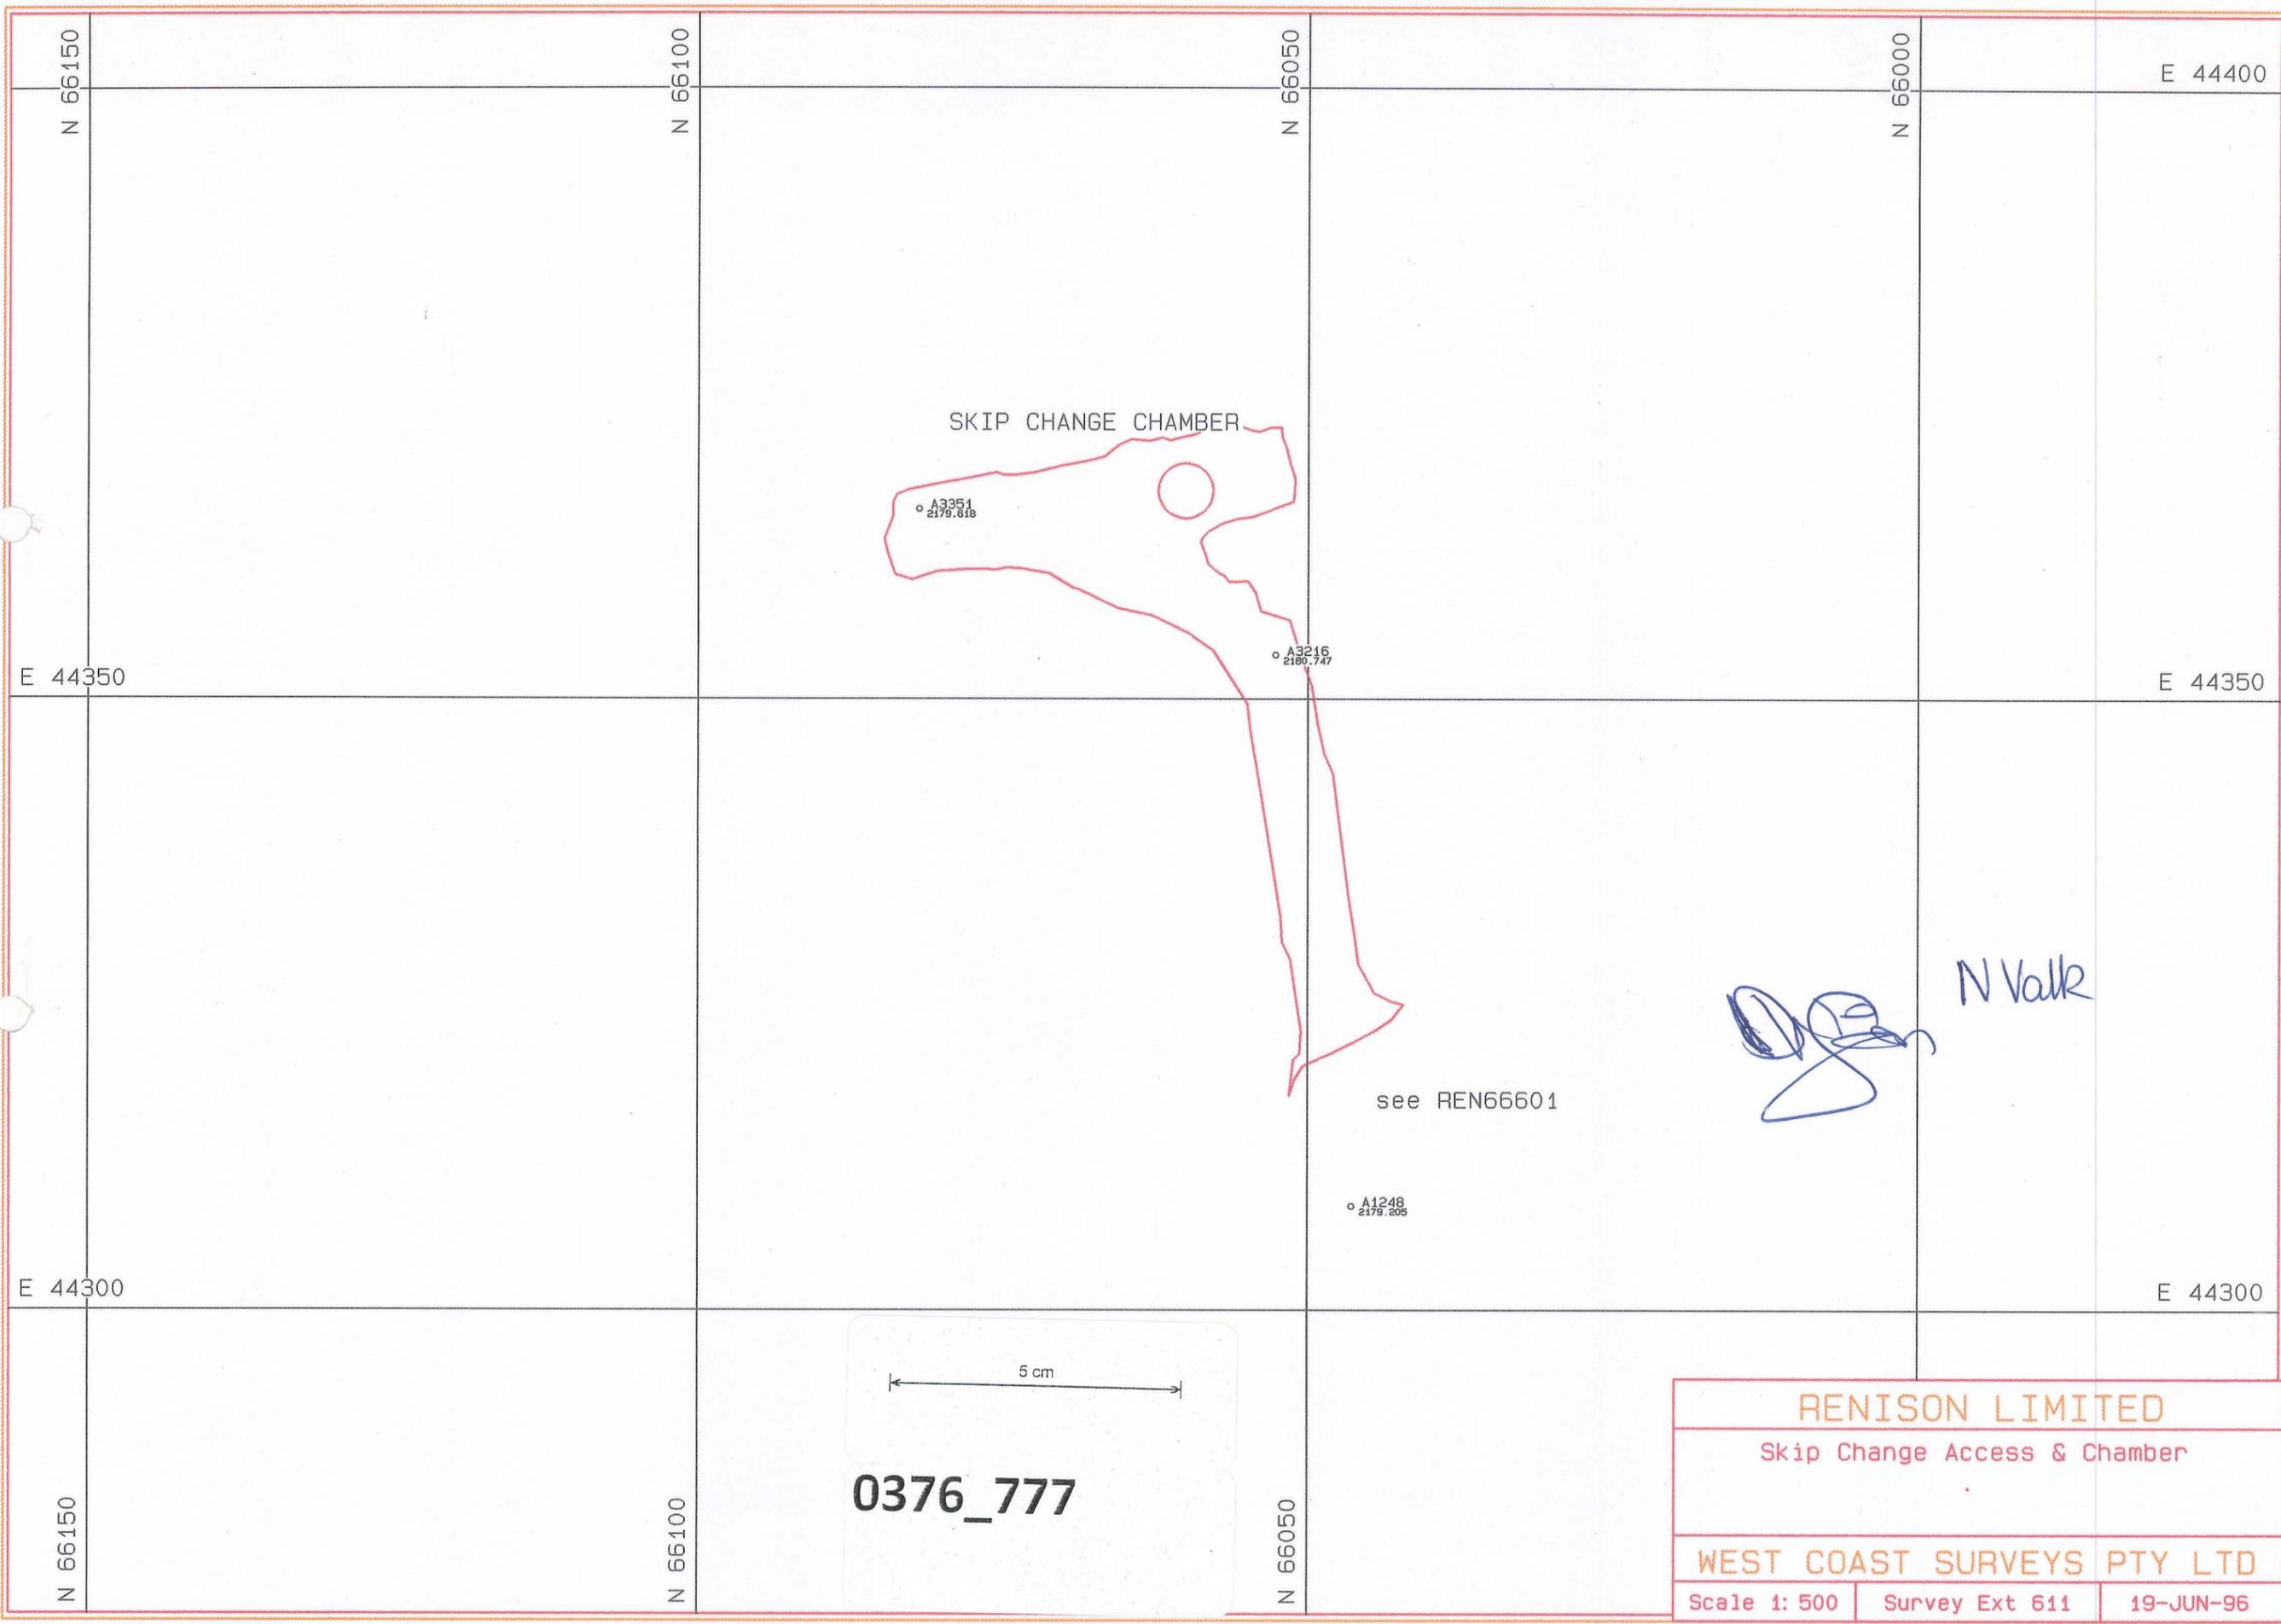

0376_777

RENISON LIMITED
 Skip Change Access & Chamber
 WEST COAST SURVEYS PTY LTD
 Scale 1: 500 | Survey Ext 611 | 19-JUN-96

DEVMAS.PF