


5 cm

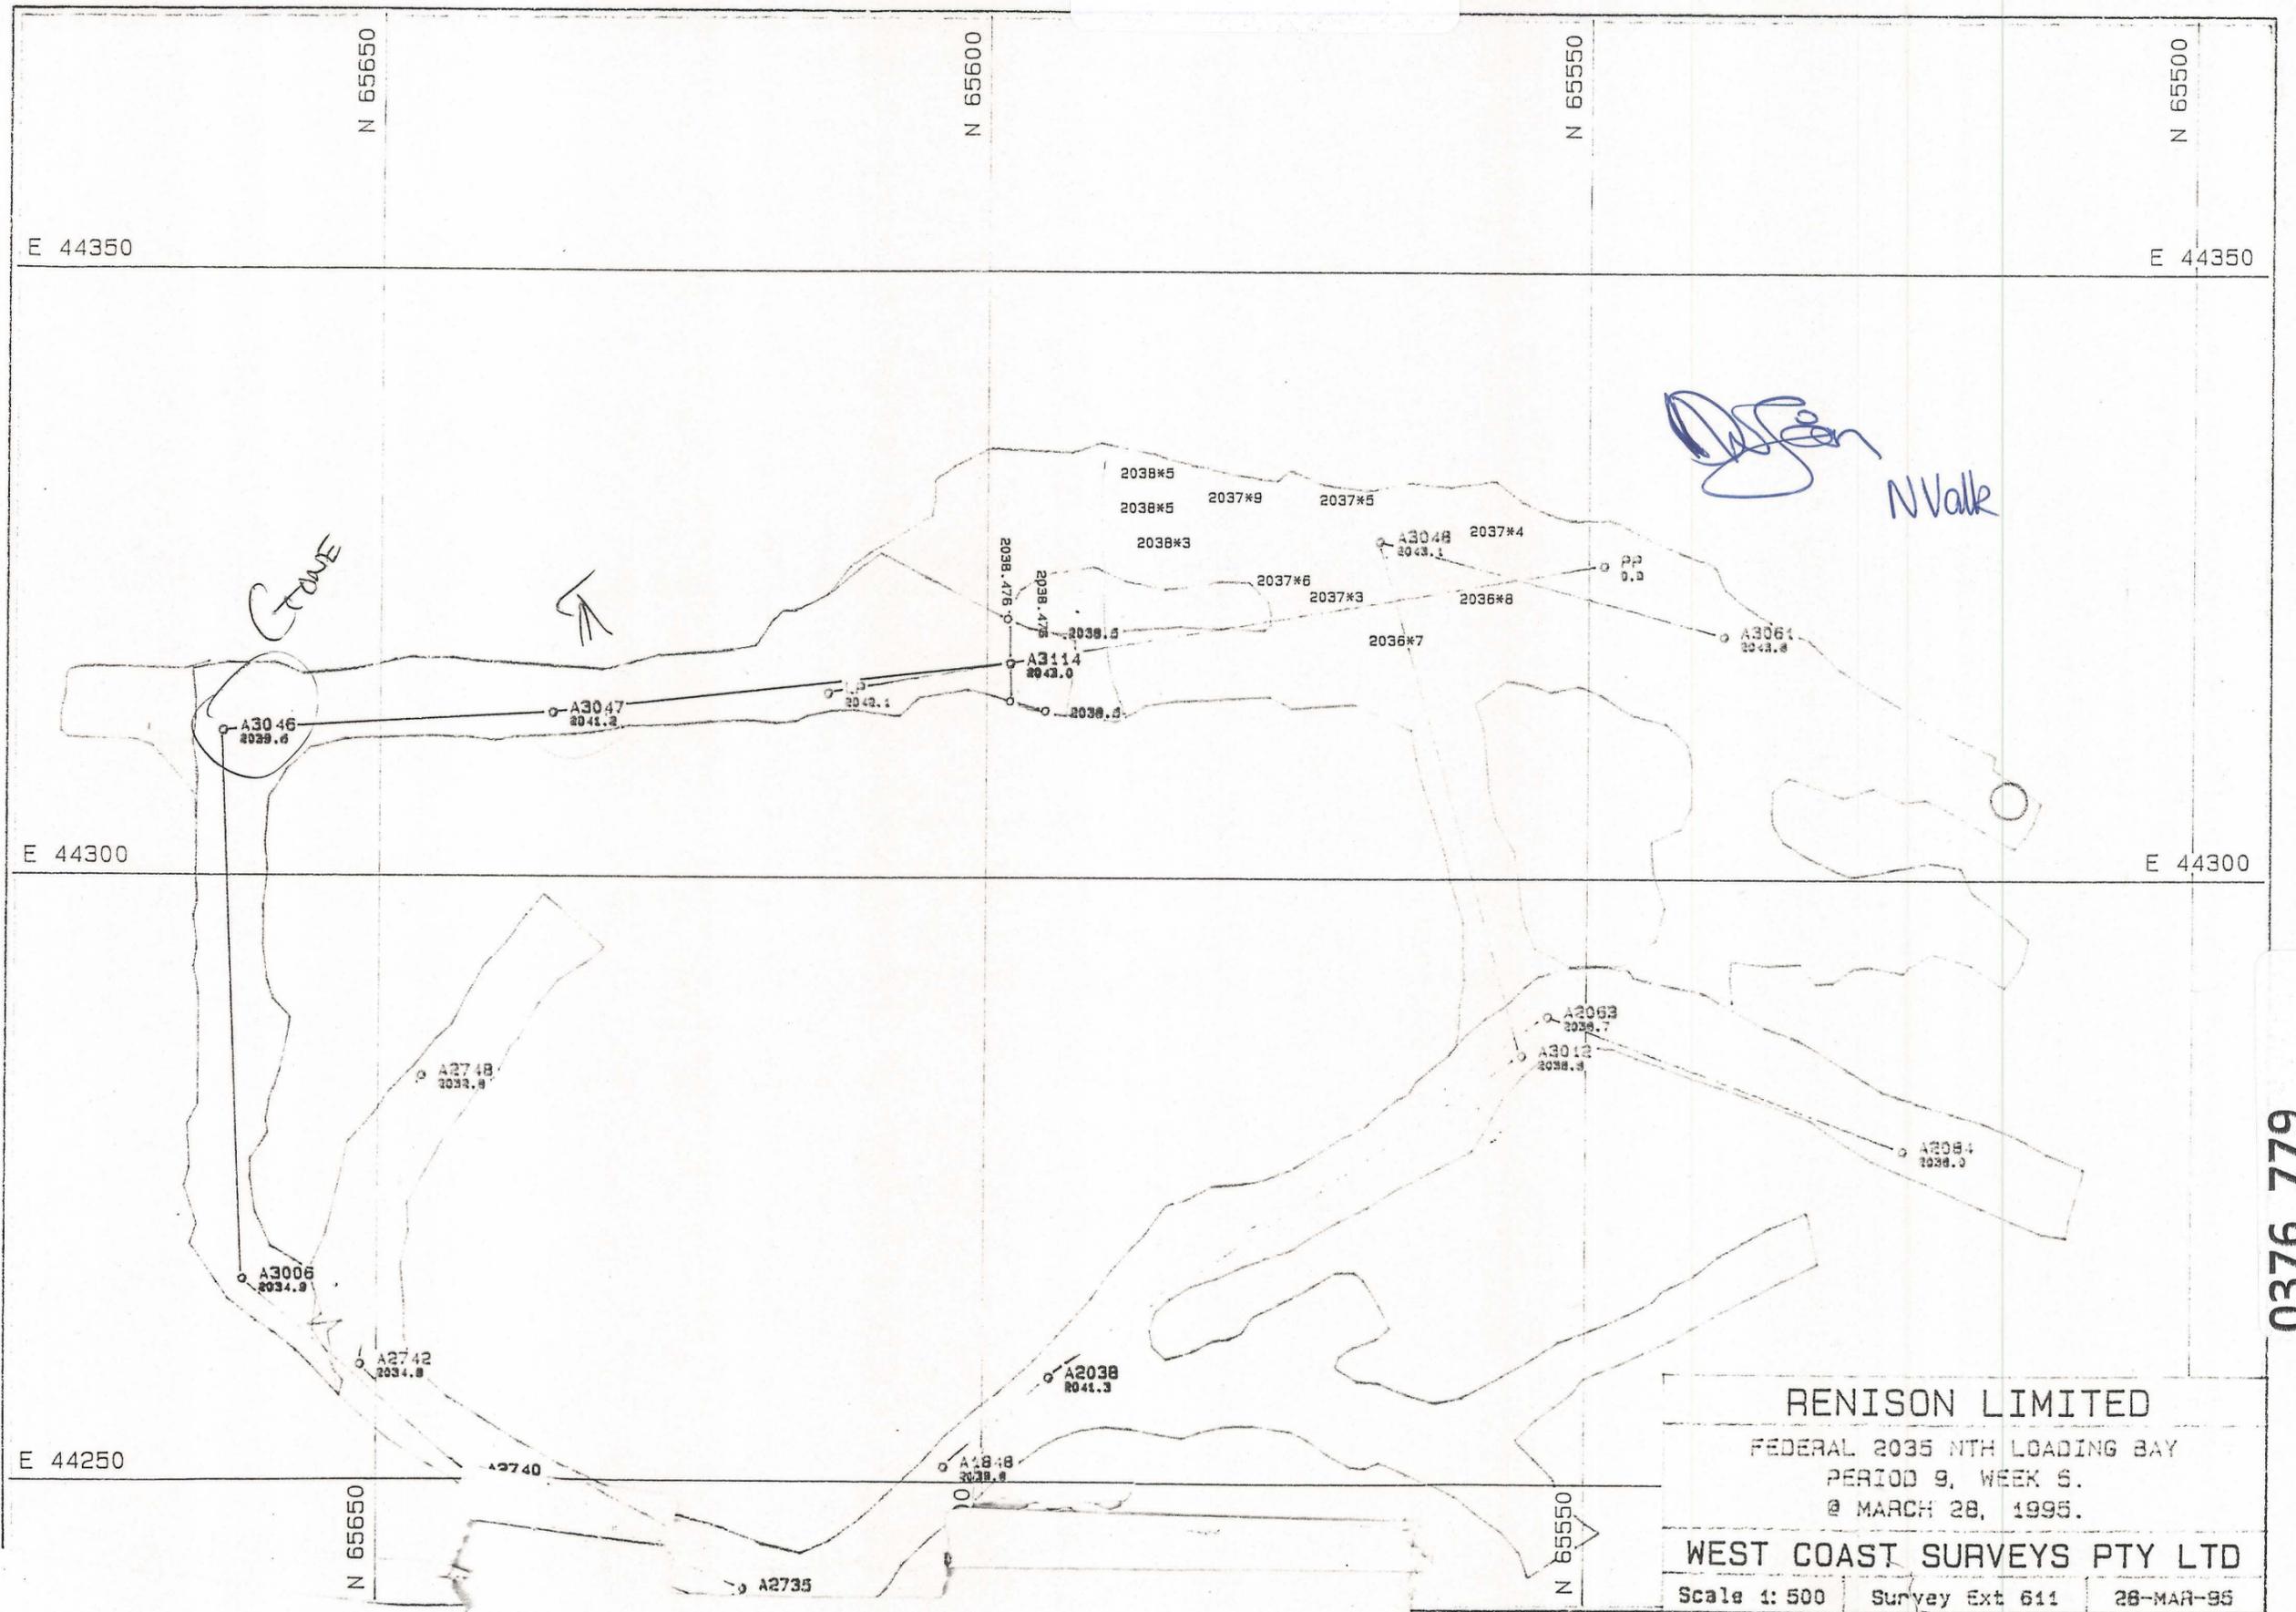

0376_779

RENISON LIMITED
 FEDERAL 2035 NTH LOADING BAY
 PERIOD 9, WEEK 5.
 @ MARCH 28, 1995.
 WEST COAST SURVEYS PTY LTD
 Scale 1: 500 Survey Ext 611 28-MAR-95