



0376_780

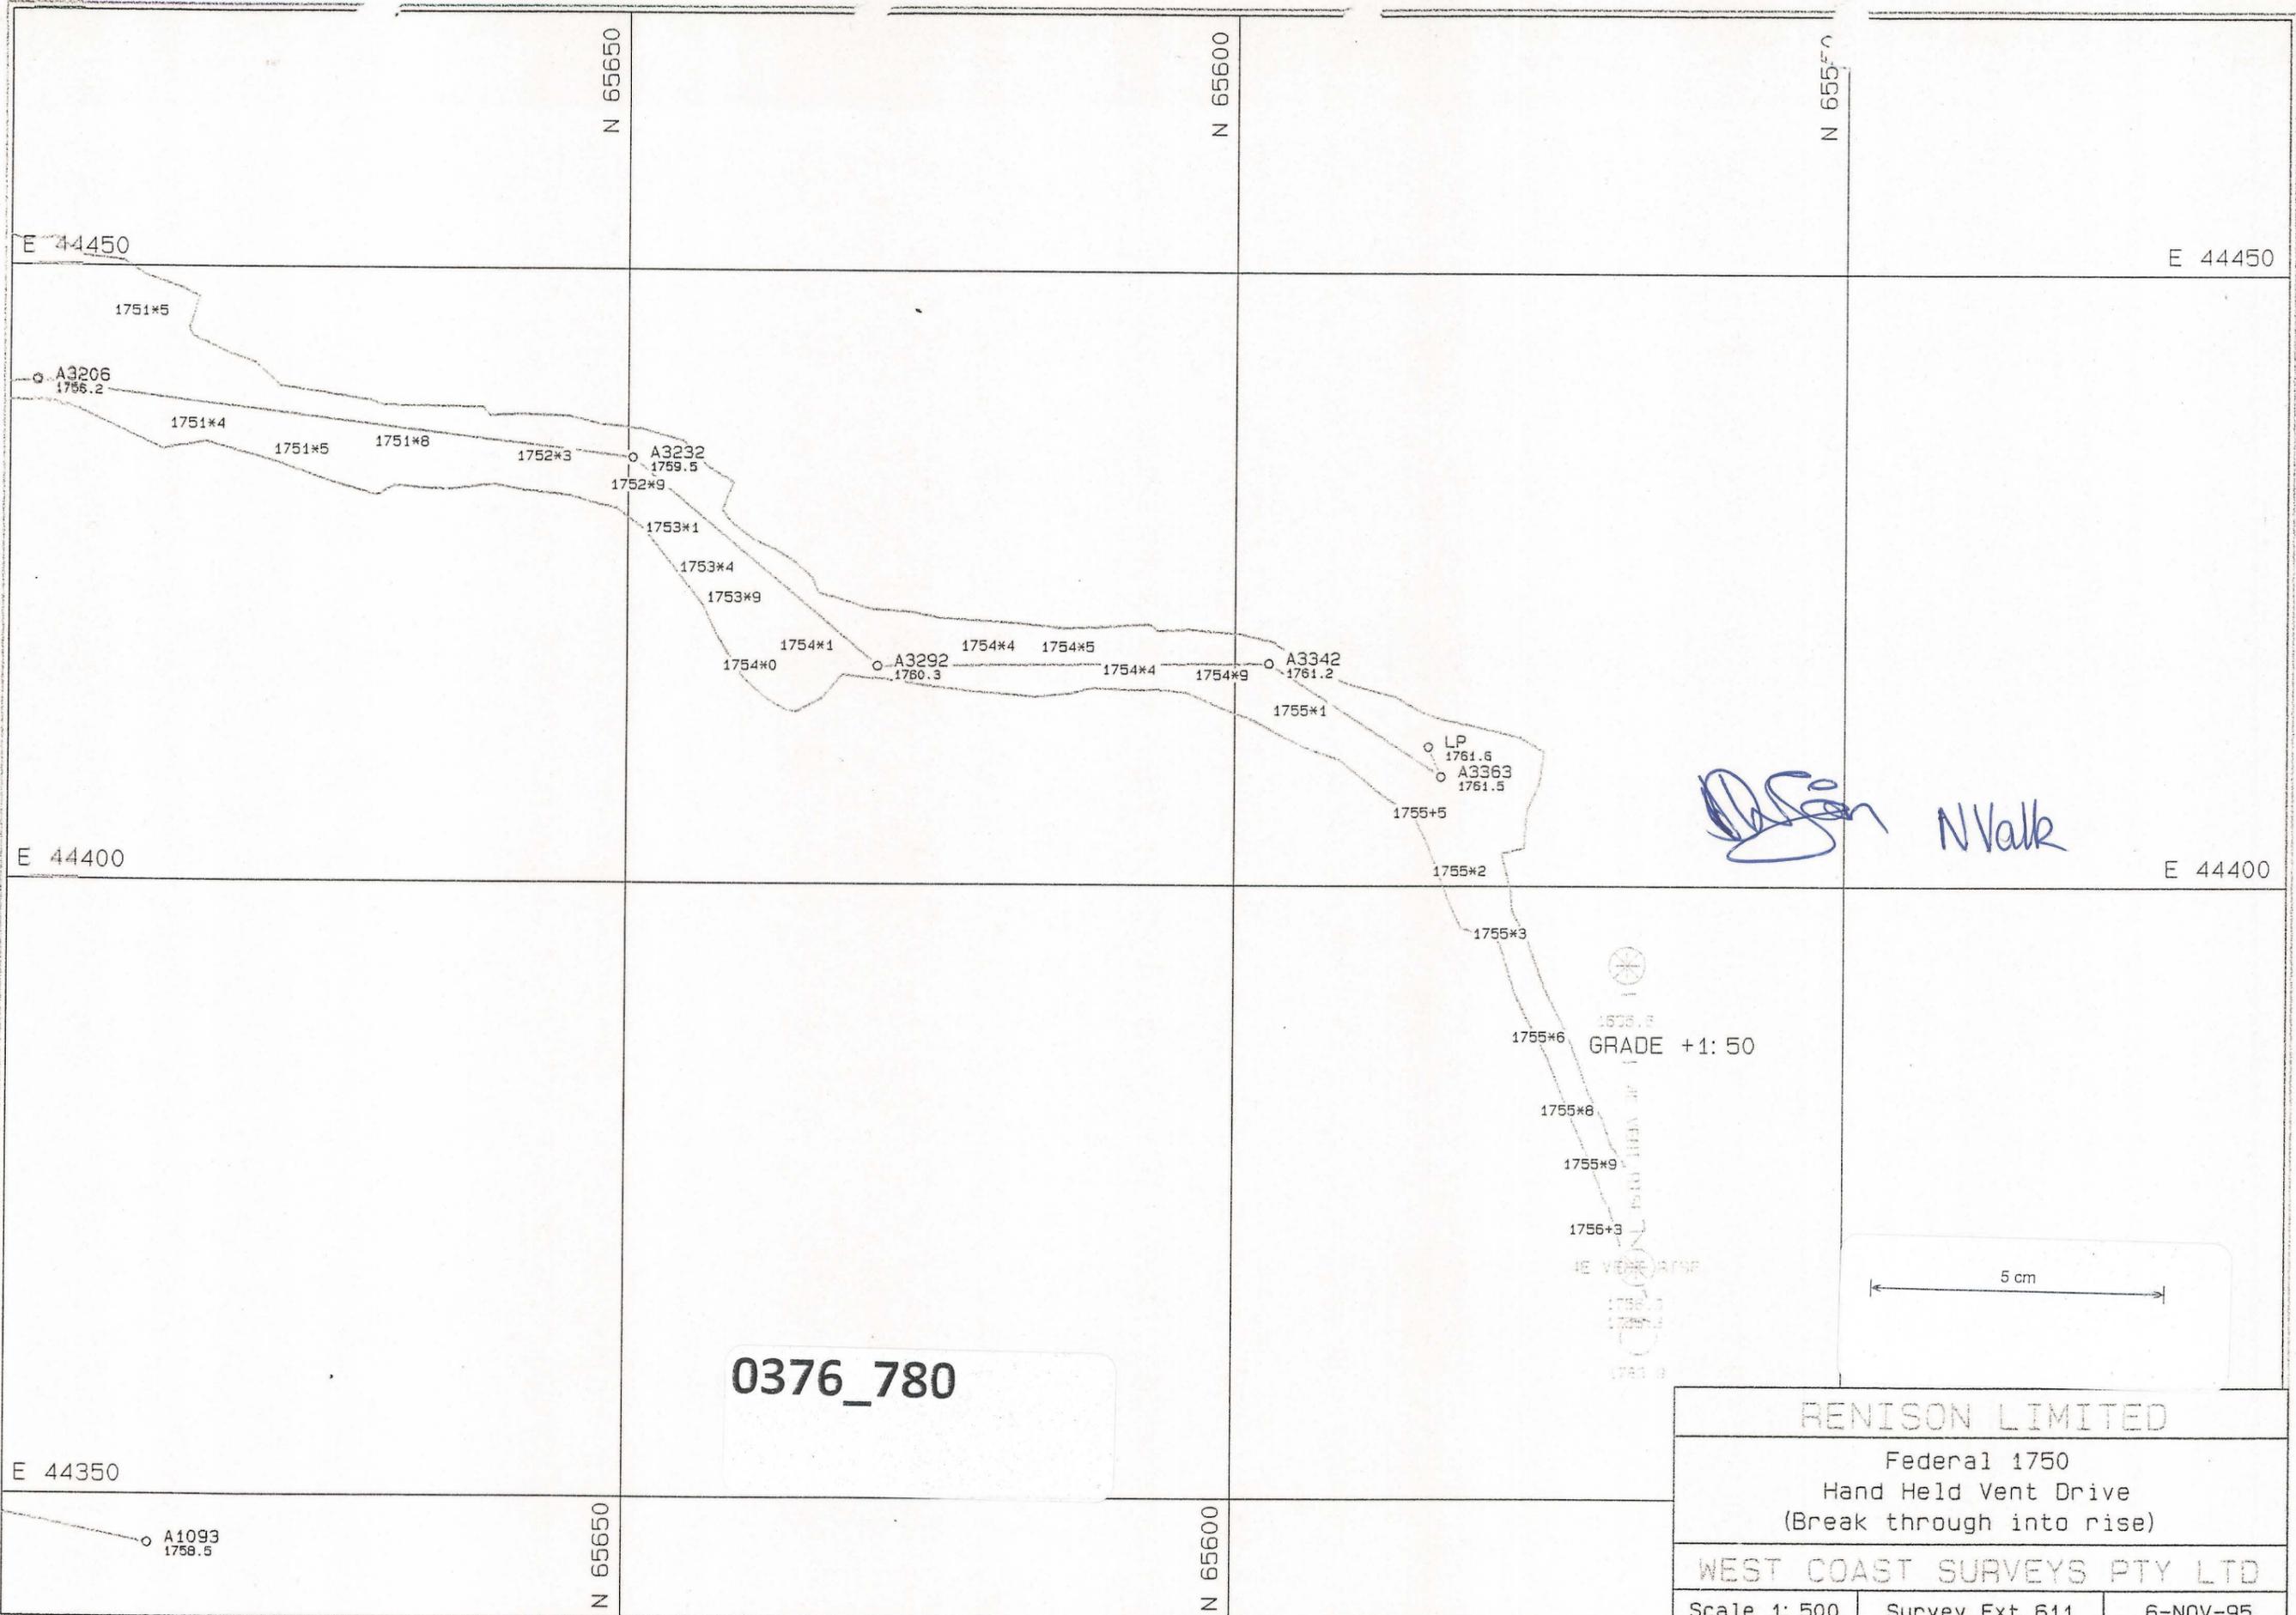

0376_780

N Valk

1608.8
 GRADE +1: 50
 1755*6
 1755*8
 1755*9
 1756*3
 1756*0
 1756*1
 1756*3

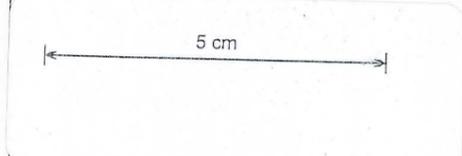

RENISON LIMITED
 Federal 1750
 Hand Held Vent Drive
 (Break through into rise)
 WEST COAST SURVEYS PTY LTD
 Scale 1: 500 Survey Ext 611 6-NOV-95

FEDERD.PF