


0376\_781

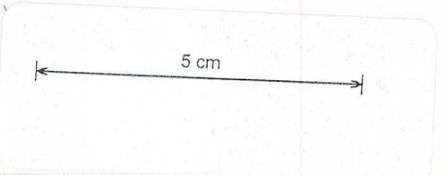

RENISON LIMITED		
Federal 1860 PU as at 30-10-95		
WEST COAST SURVEYS PTY LTD		
Scale 1: 500	Survey Ext 611	31-OCT-95

FEDERB.PF