


0376\_782

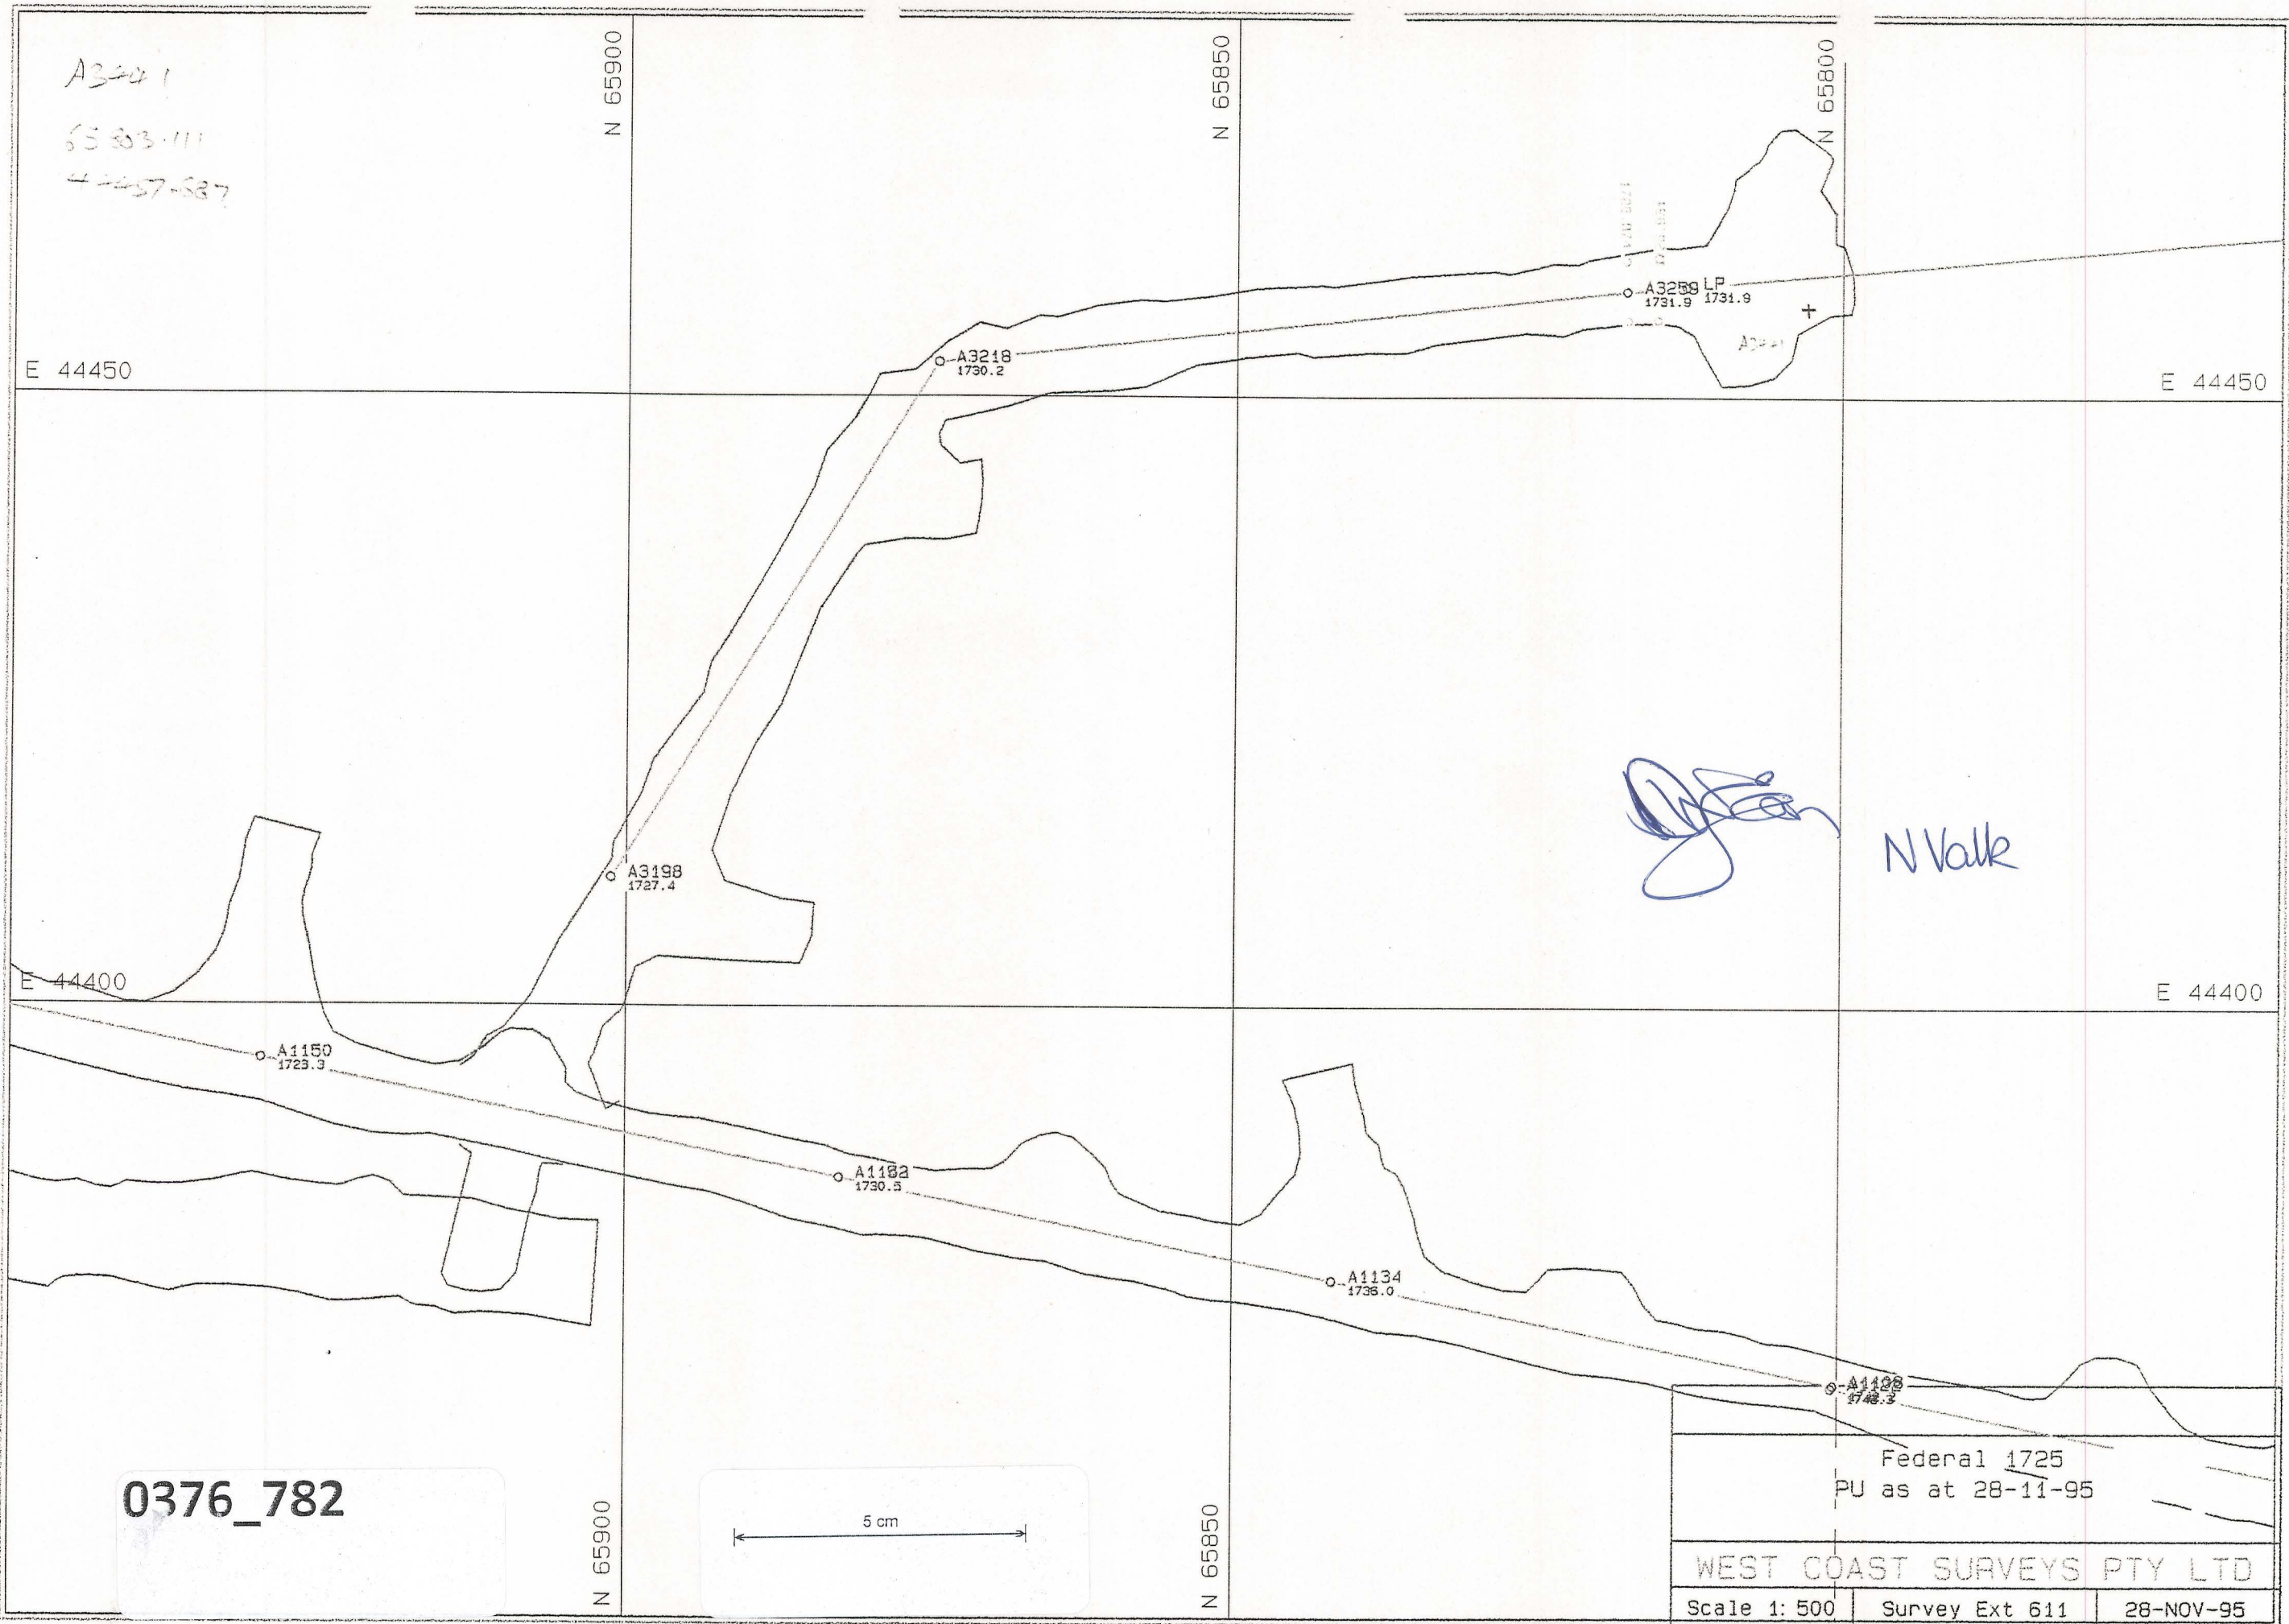

0376\_782

FEDERA.PF

Σ