


0376_783

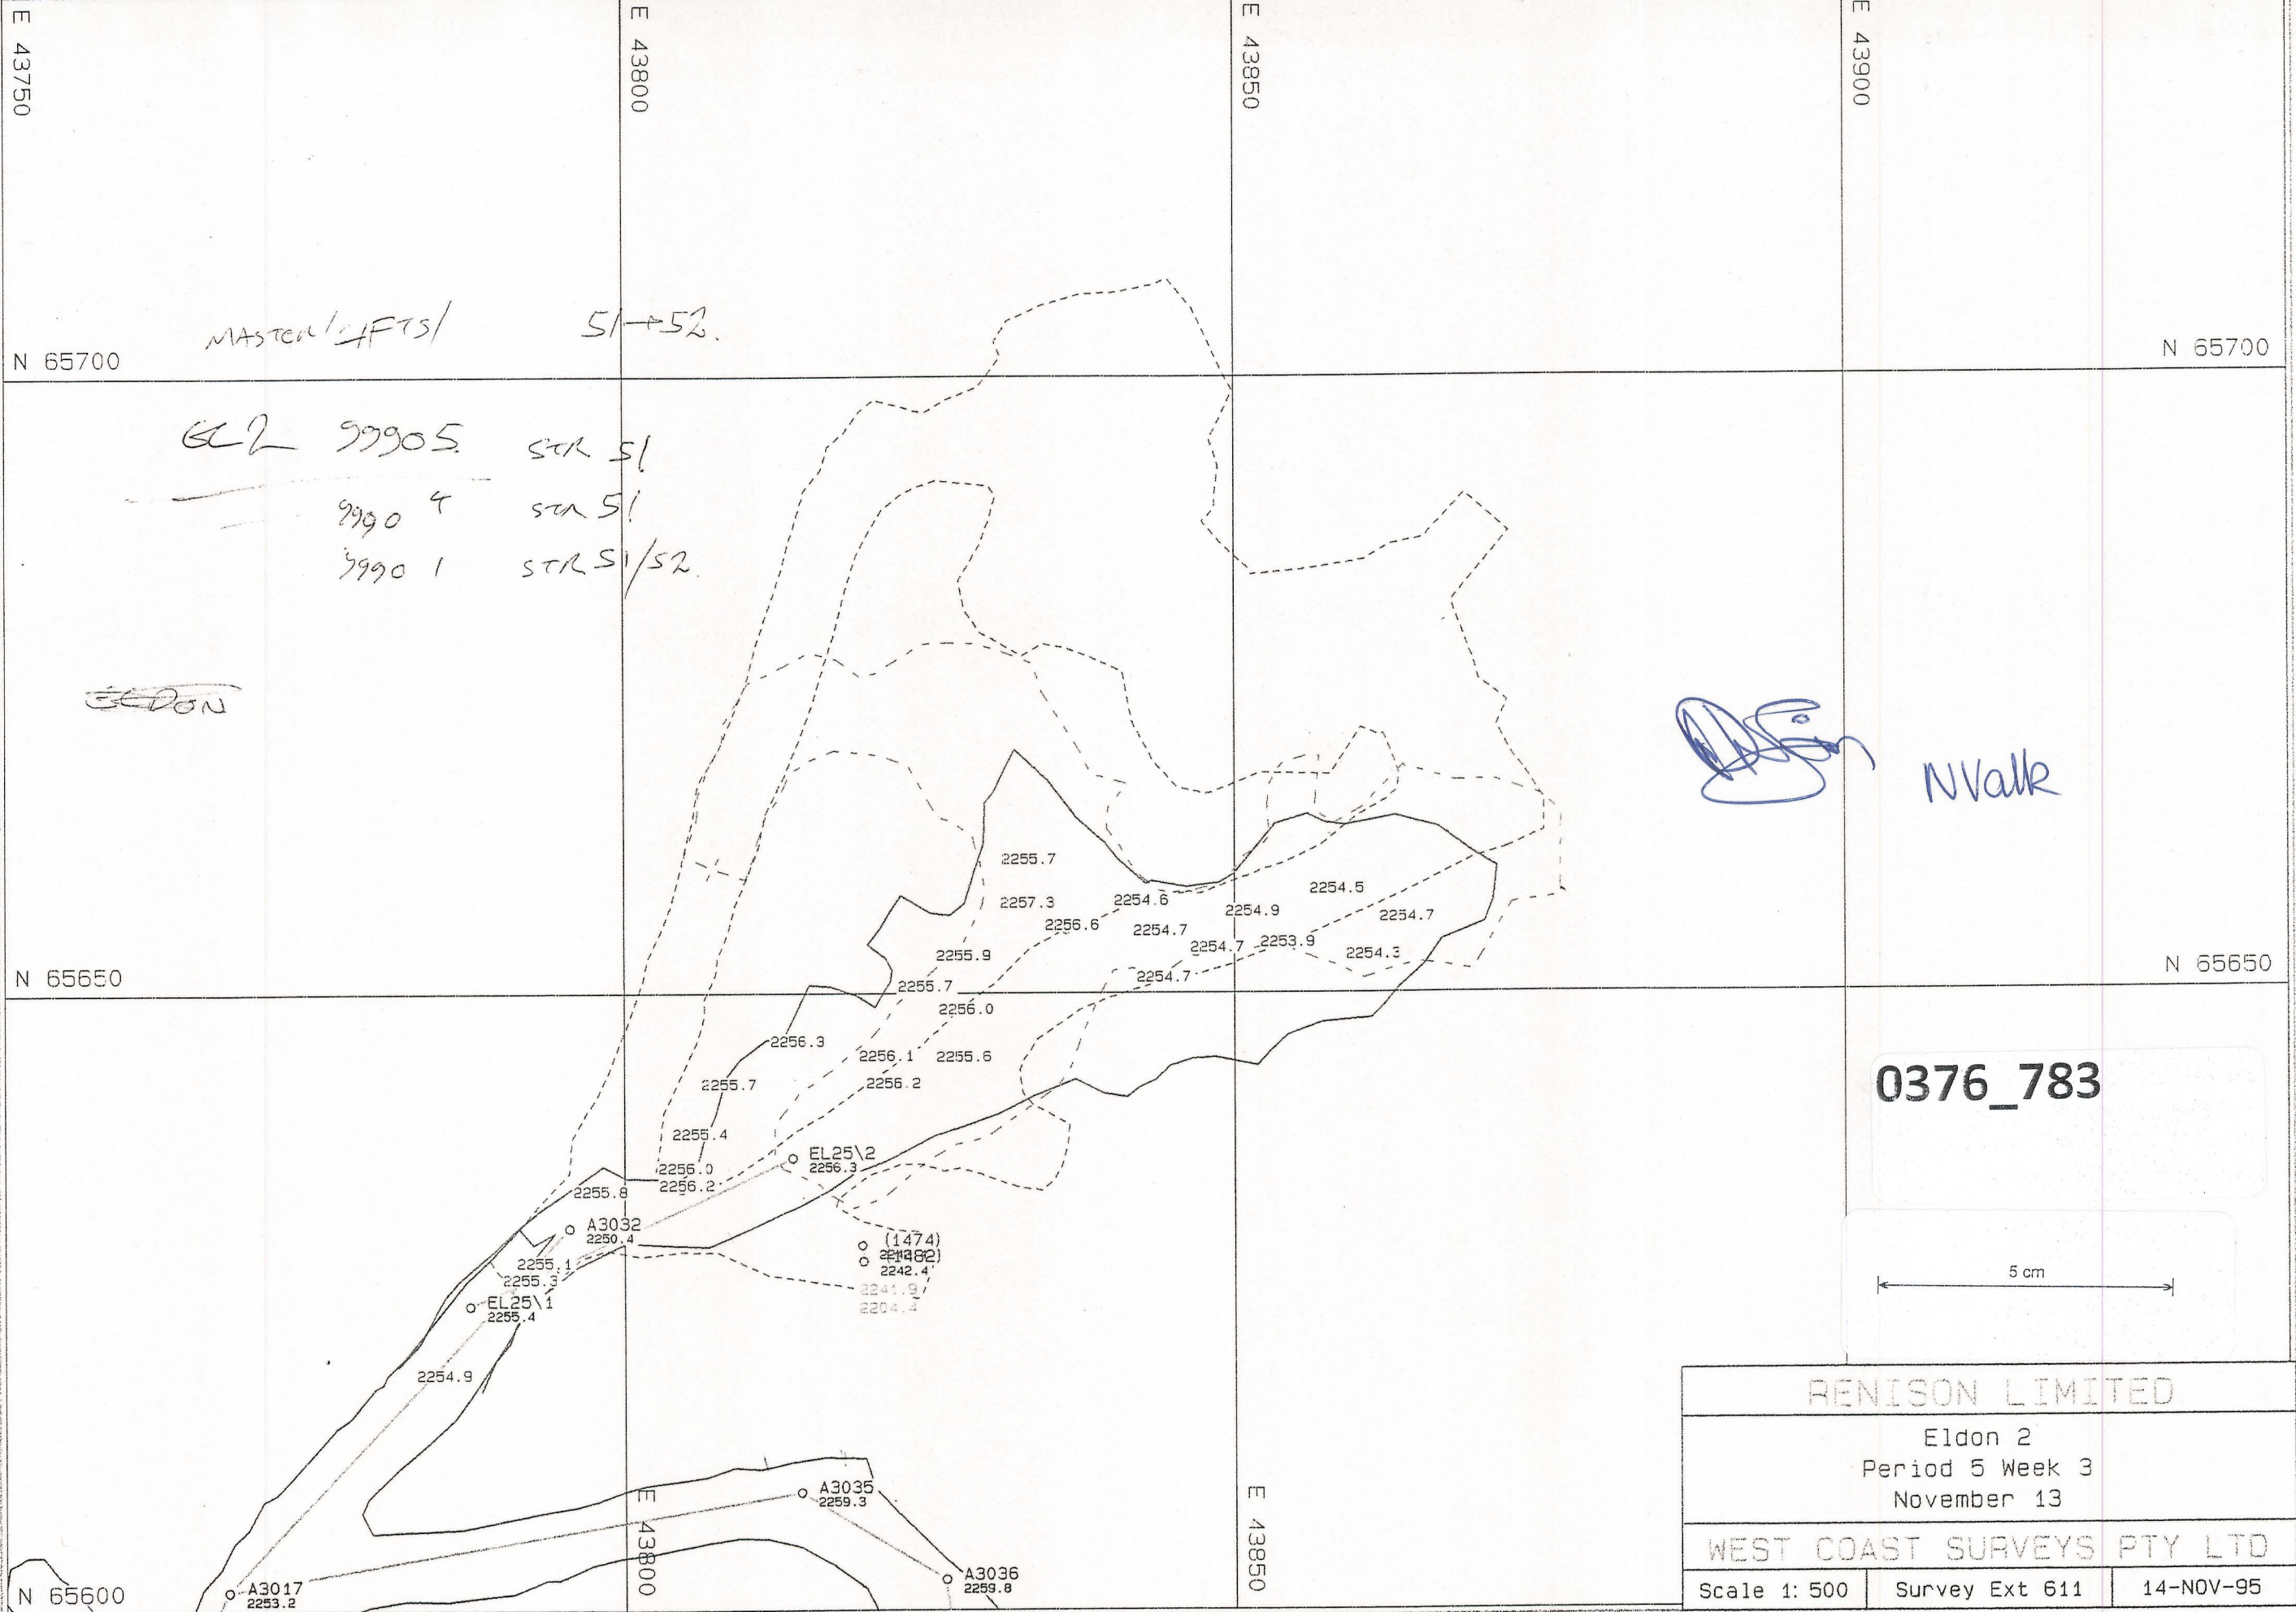

ELDONH.PF