


0376_784



0376_784

RENISON LIMITED		
Eldon 6		
Period 5 Week 3		
14/11/95		
WEST COAST SURVEYS PTY LTD		
Scale 1: 500	Survey Ext 611	14-NOV-95

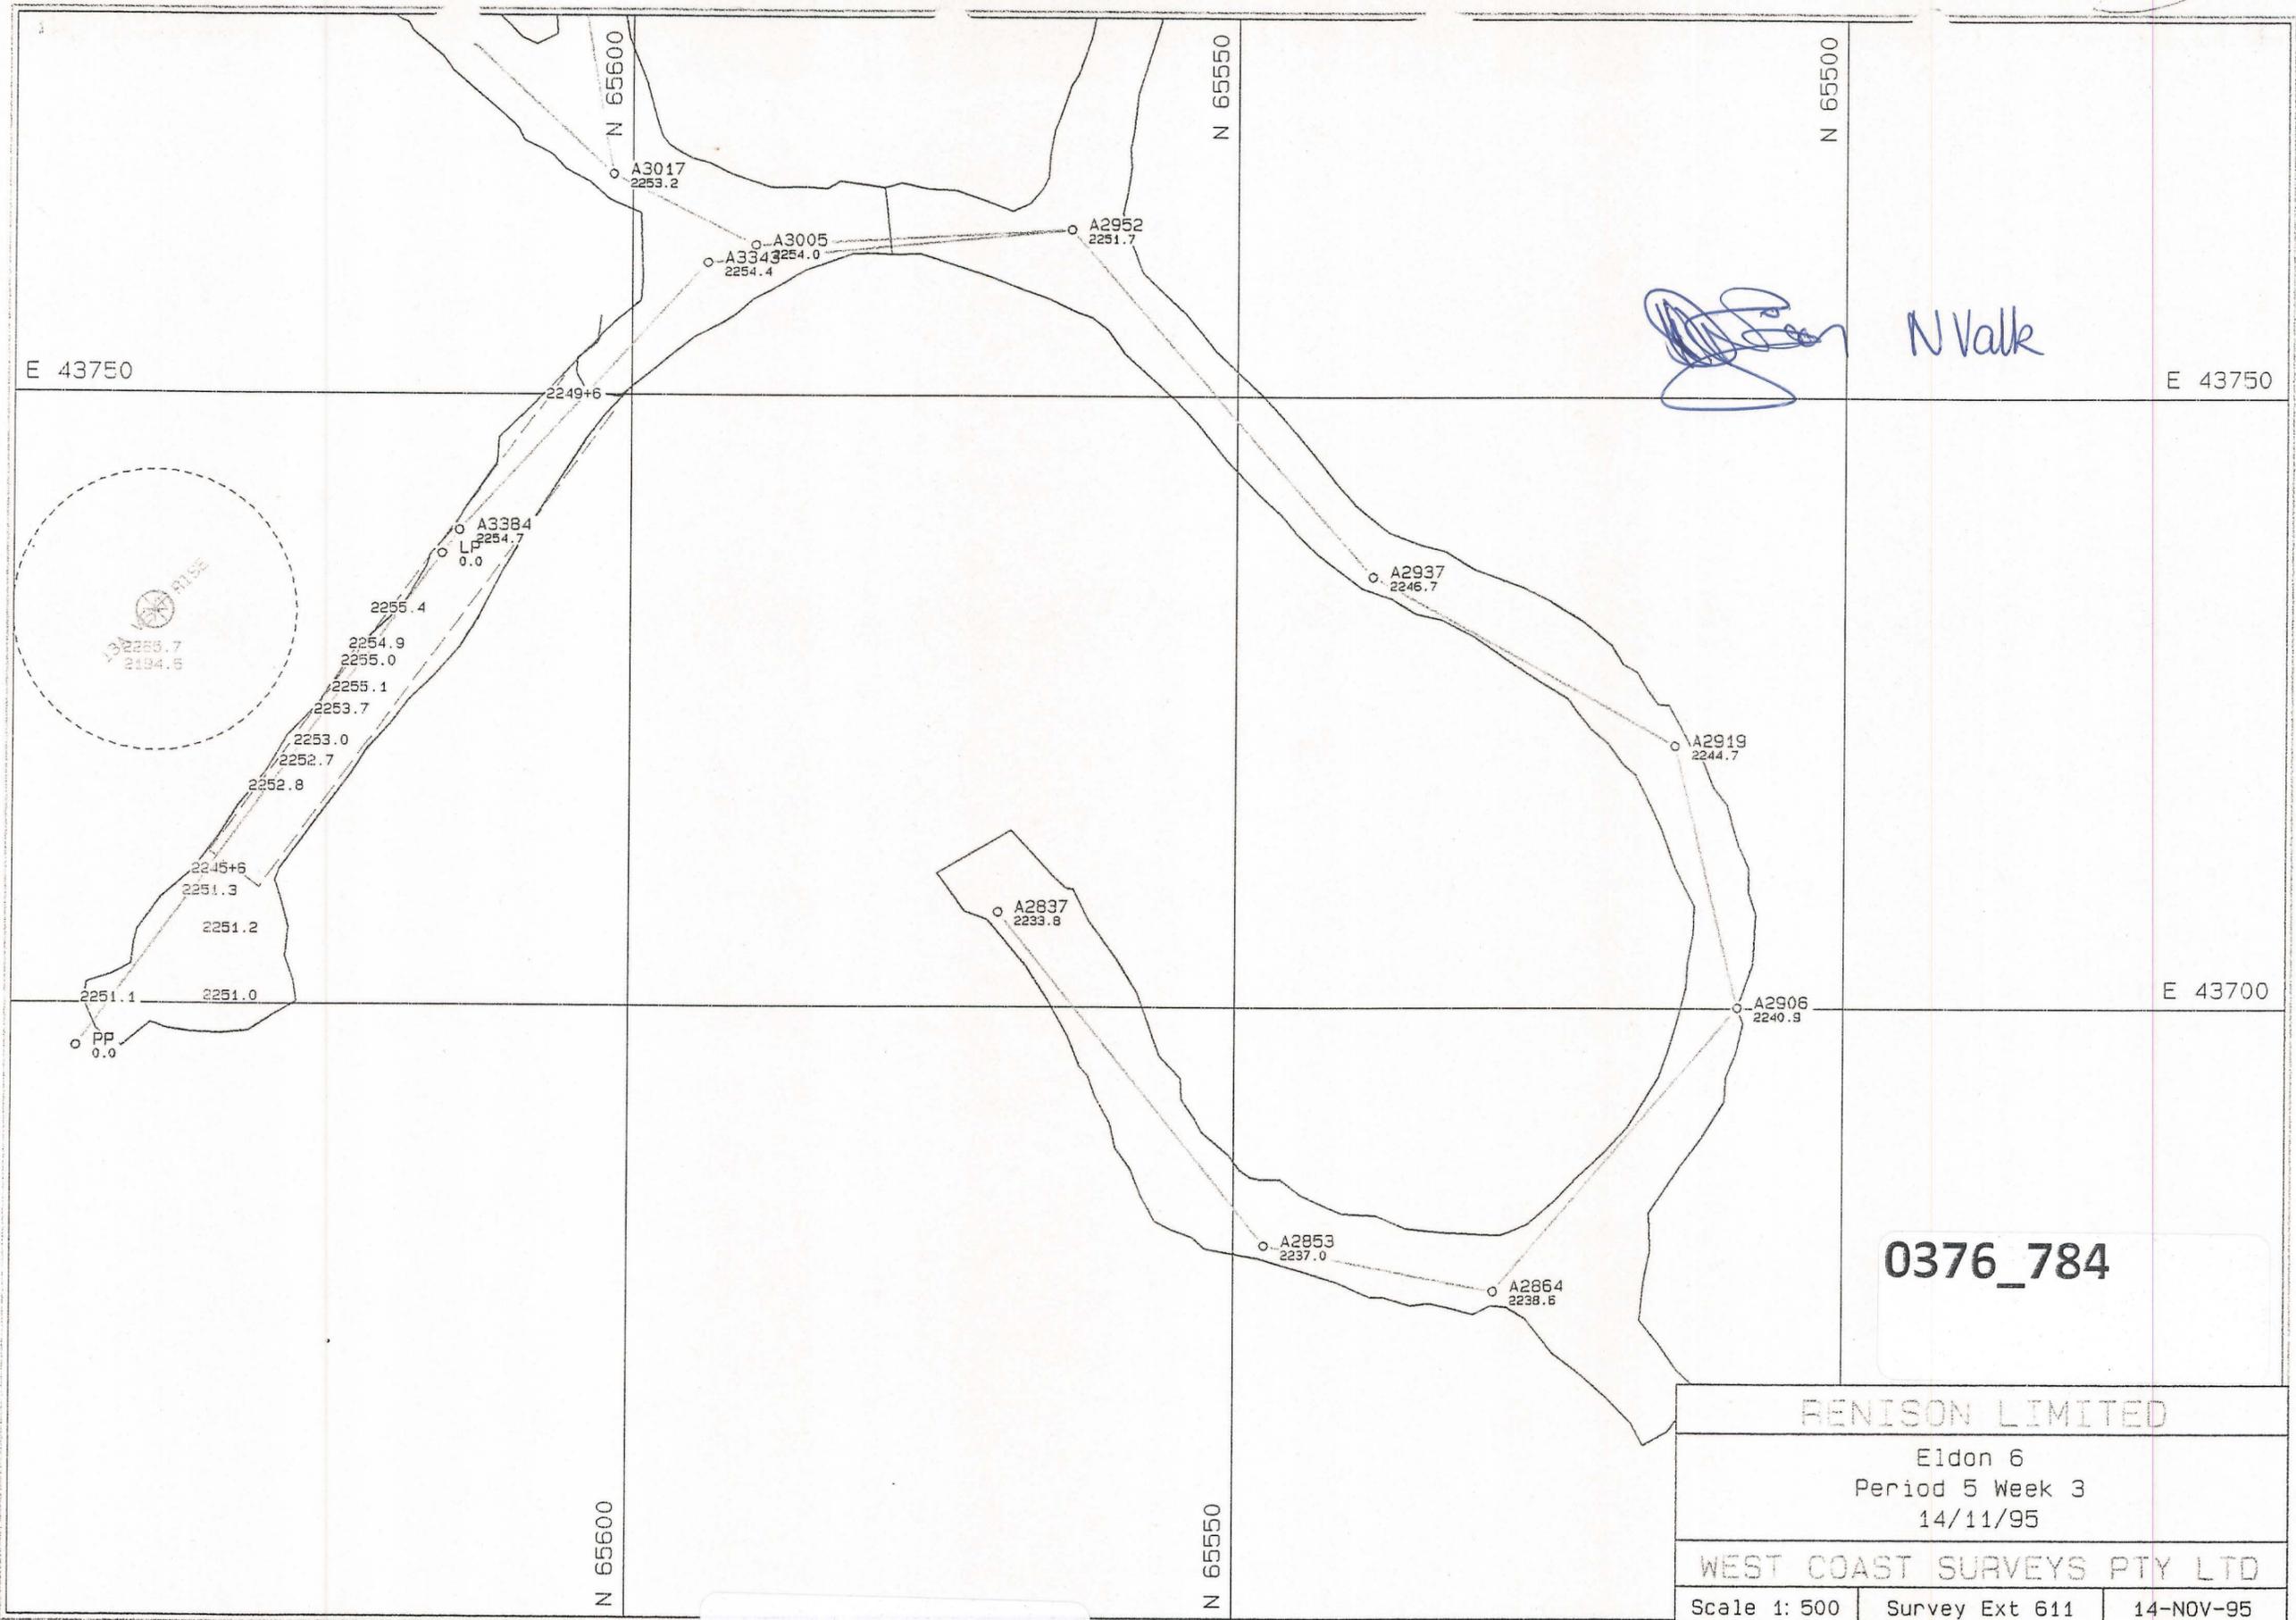