


0376_785

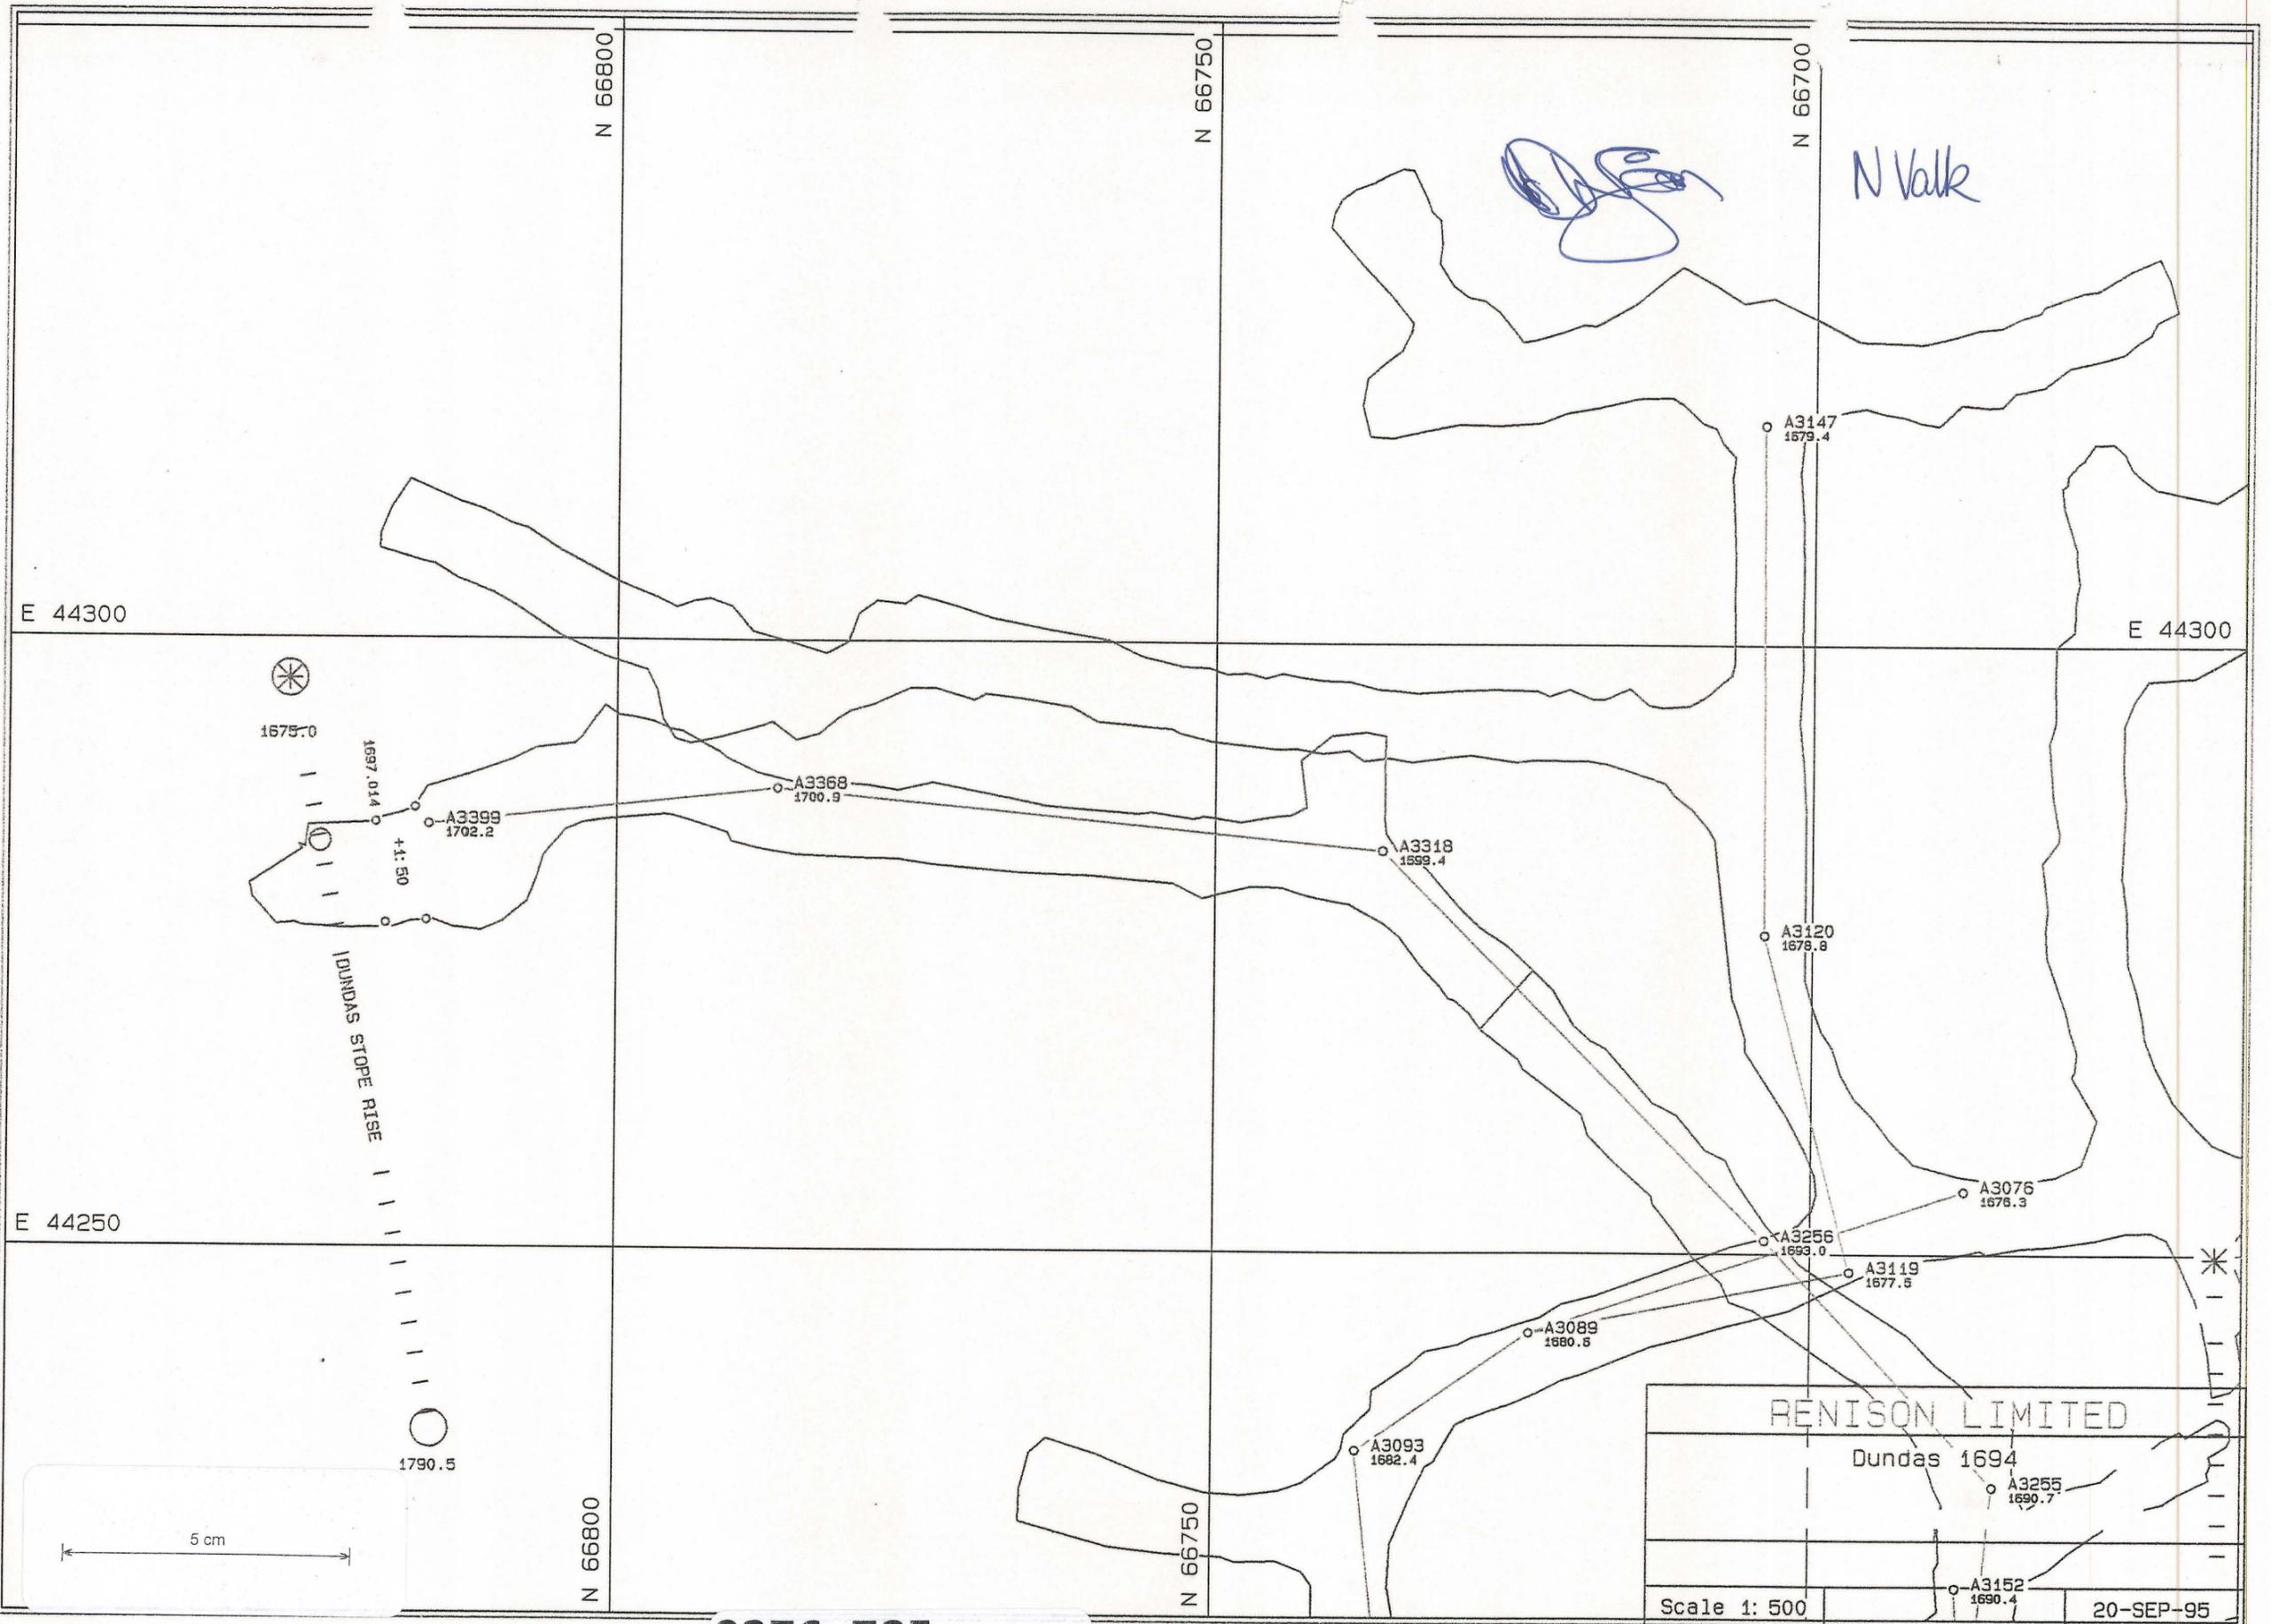

DUNDAE.PF

0376_785