


0376_786

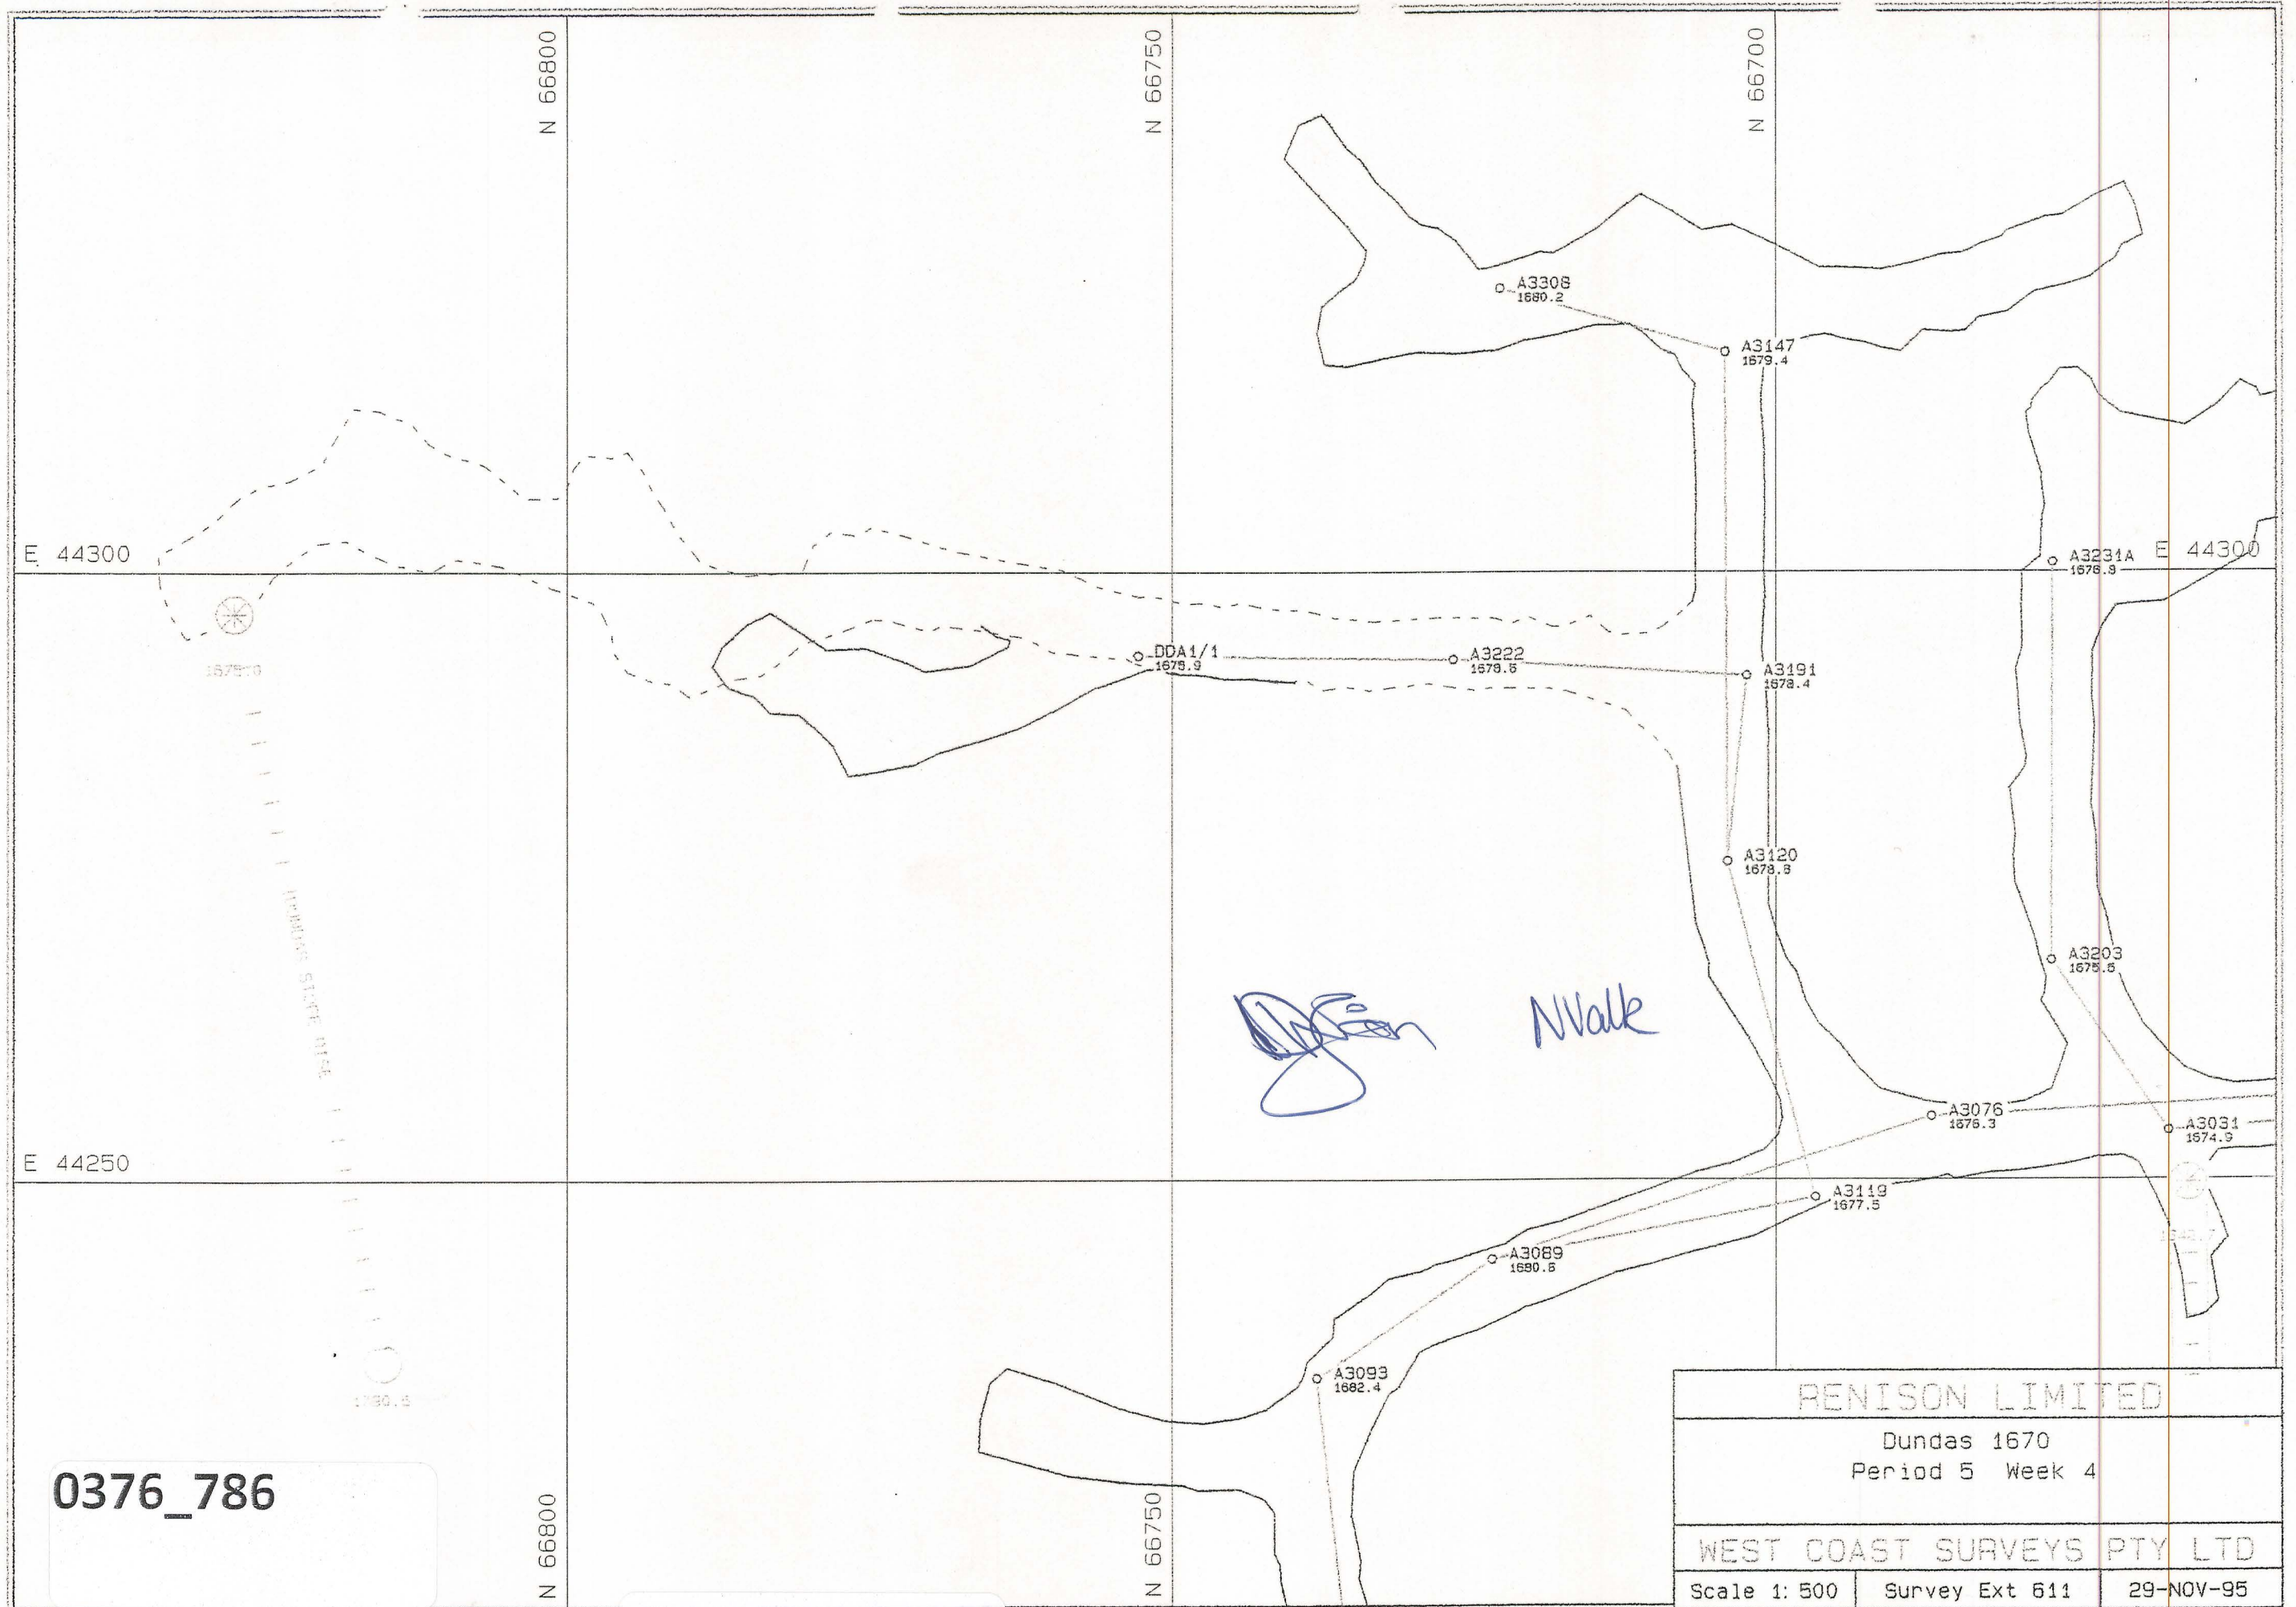

0376_786

RENISON LIMITED

Dundas 1670
Period 5 Week 4

WEST COAST SURVEYS PTY LTD

Scale 1: 500 | Survey Ext 611 | 29-NOV-95

5 cm