


0376_787

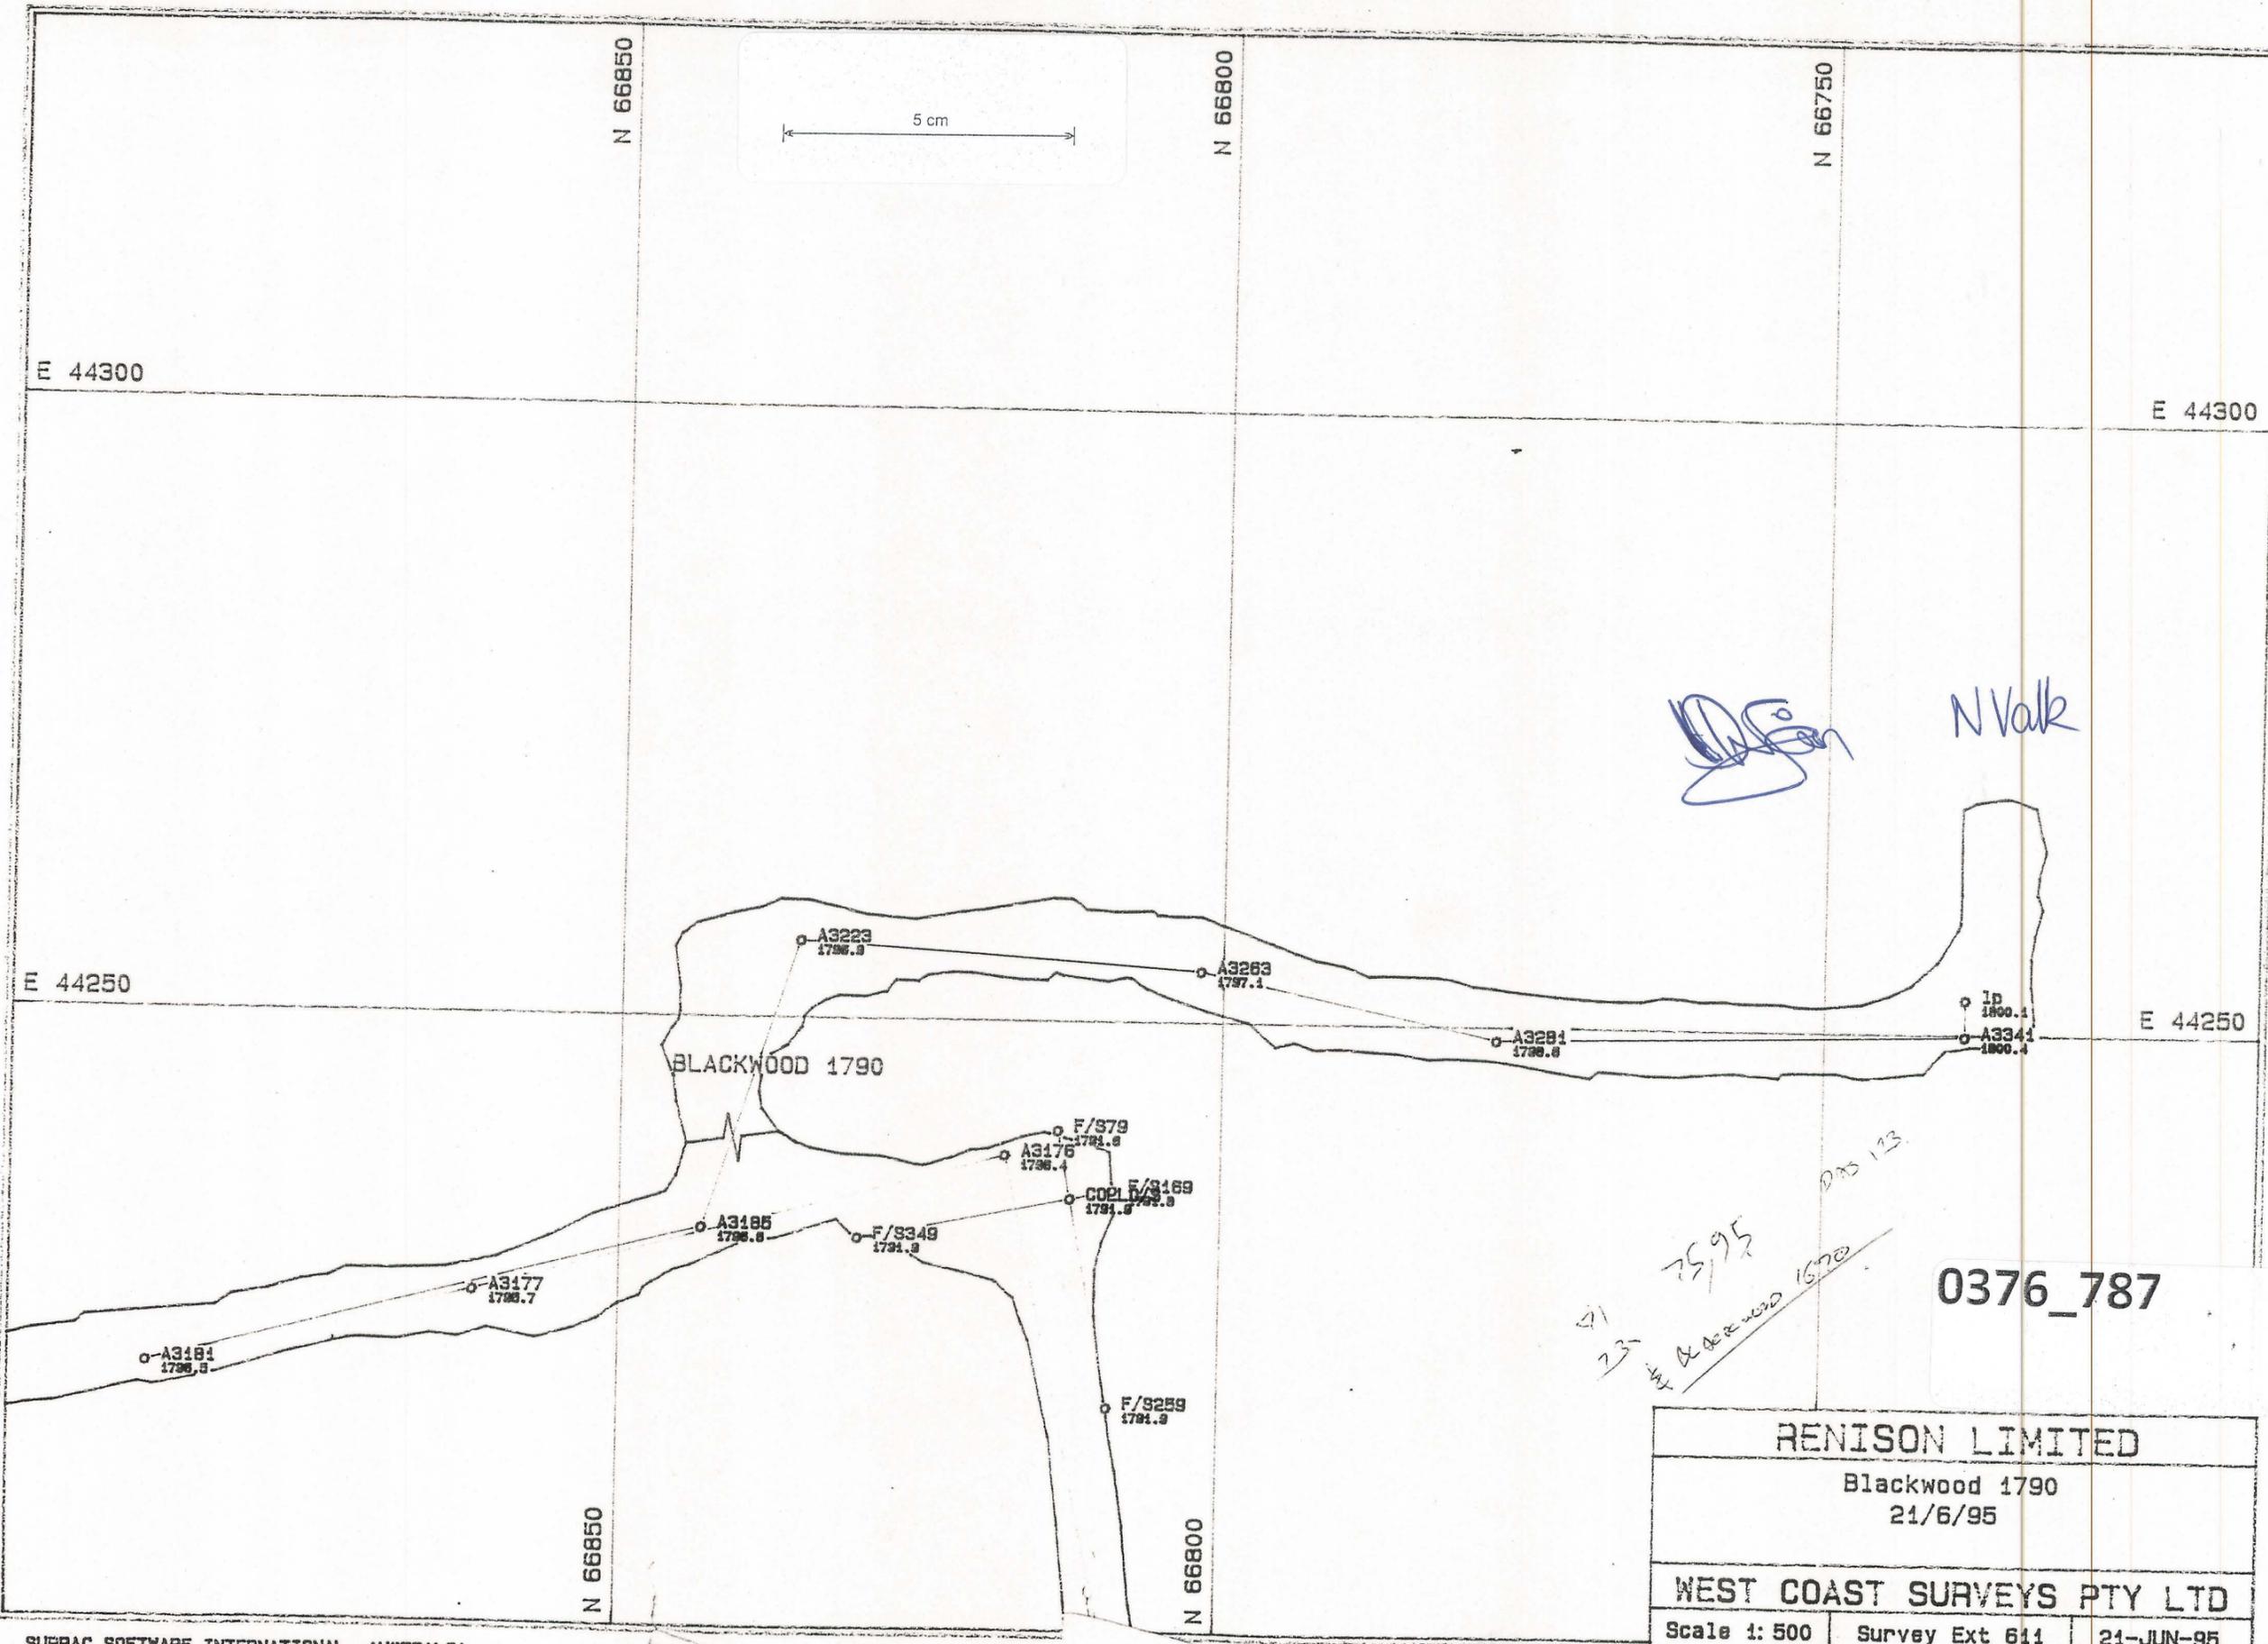

[Handwritten Signature]
N Valk

21 75/95
23 MAY
BLACKWOOD 1790
DMS 123

0376_787

RENISON LIMITED		
Blackwood 1790 21/6/95		
WEST COAST SURVEYS PTY LTD		
Scale 1: 500	Survey Ext 611	21-JUN-95