


0376\_790

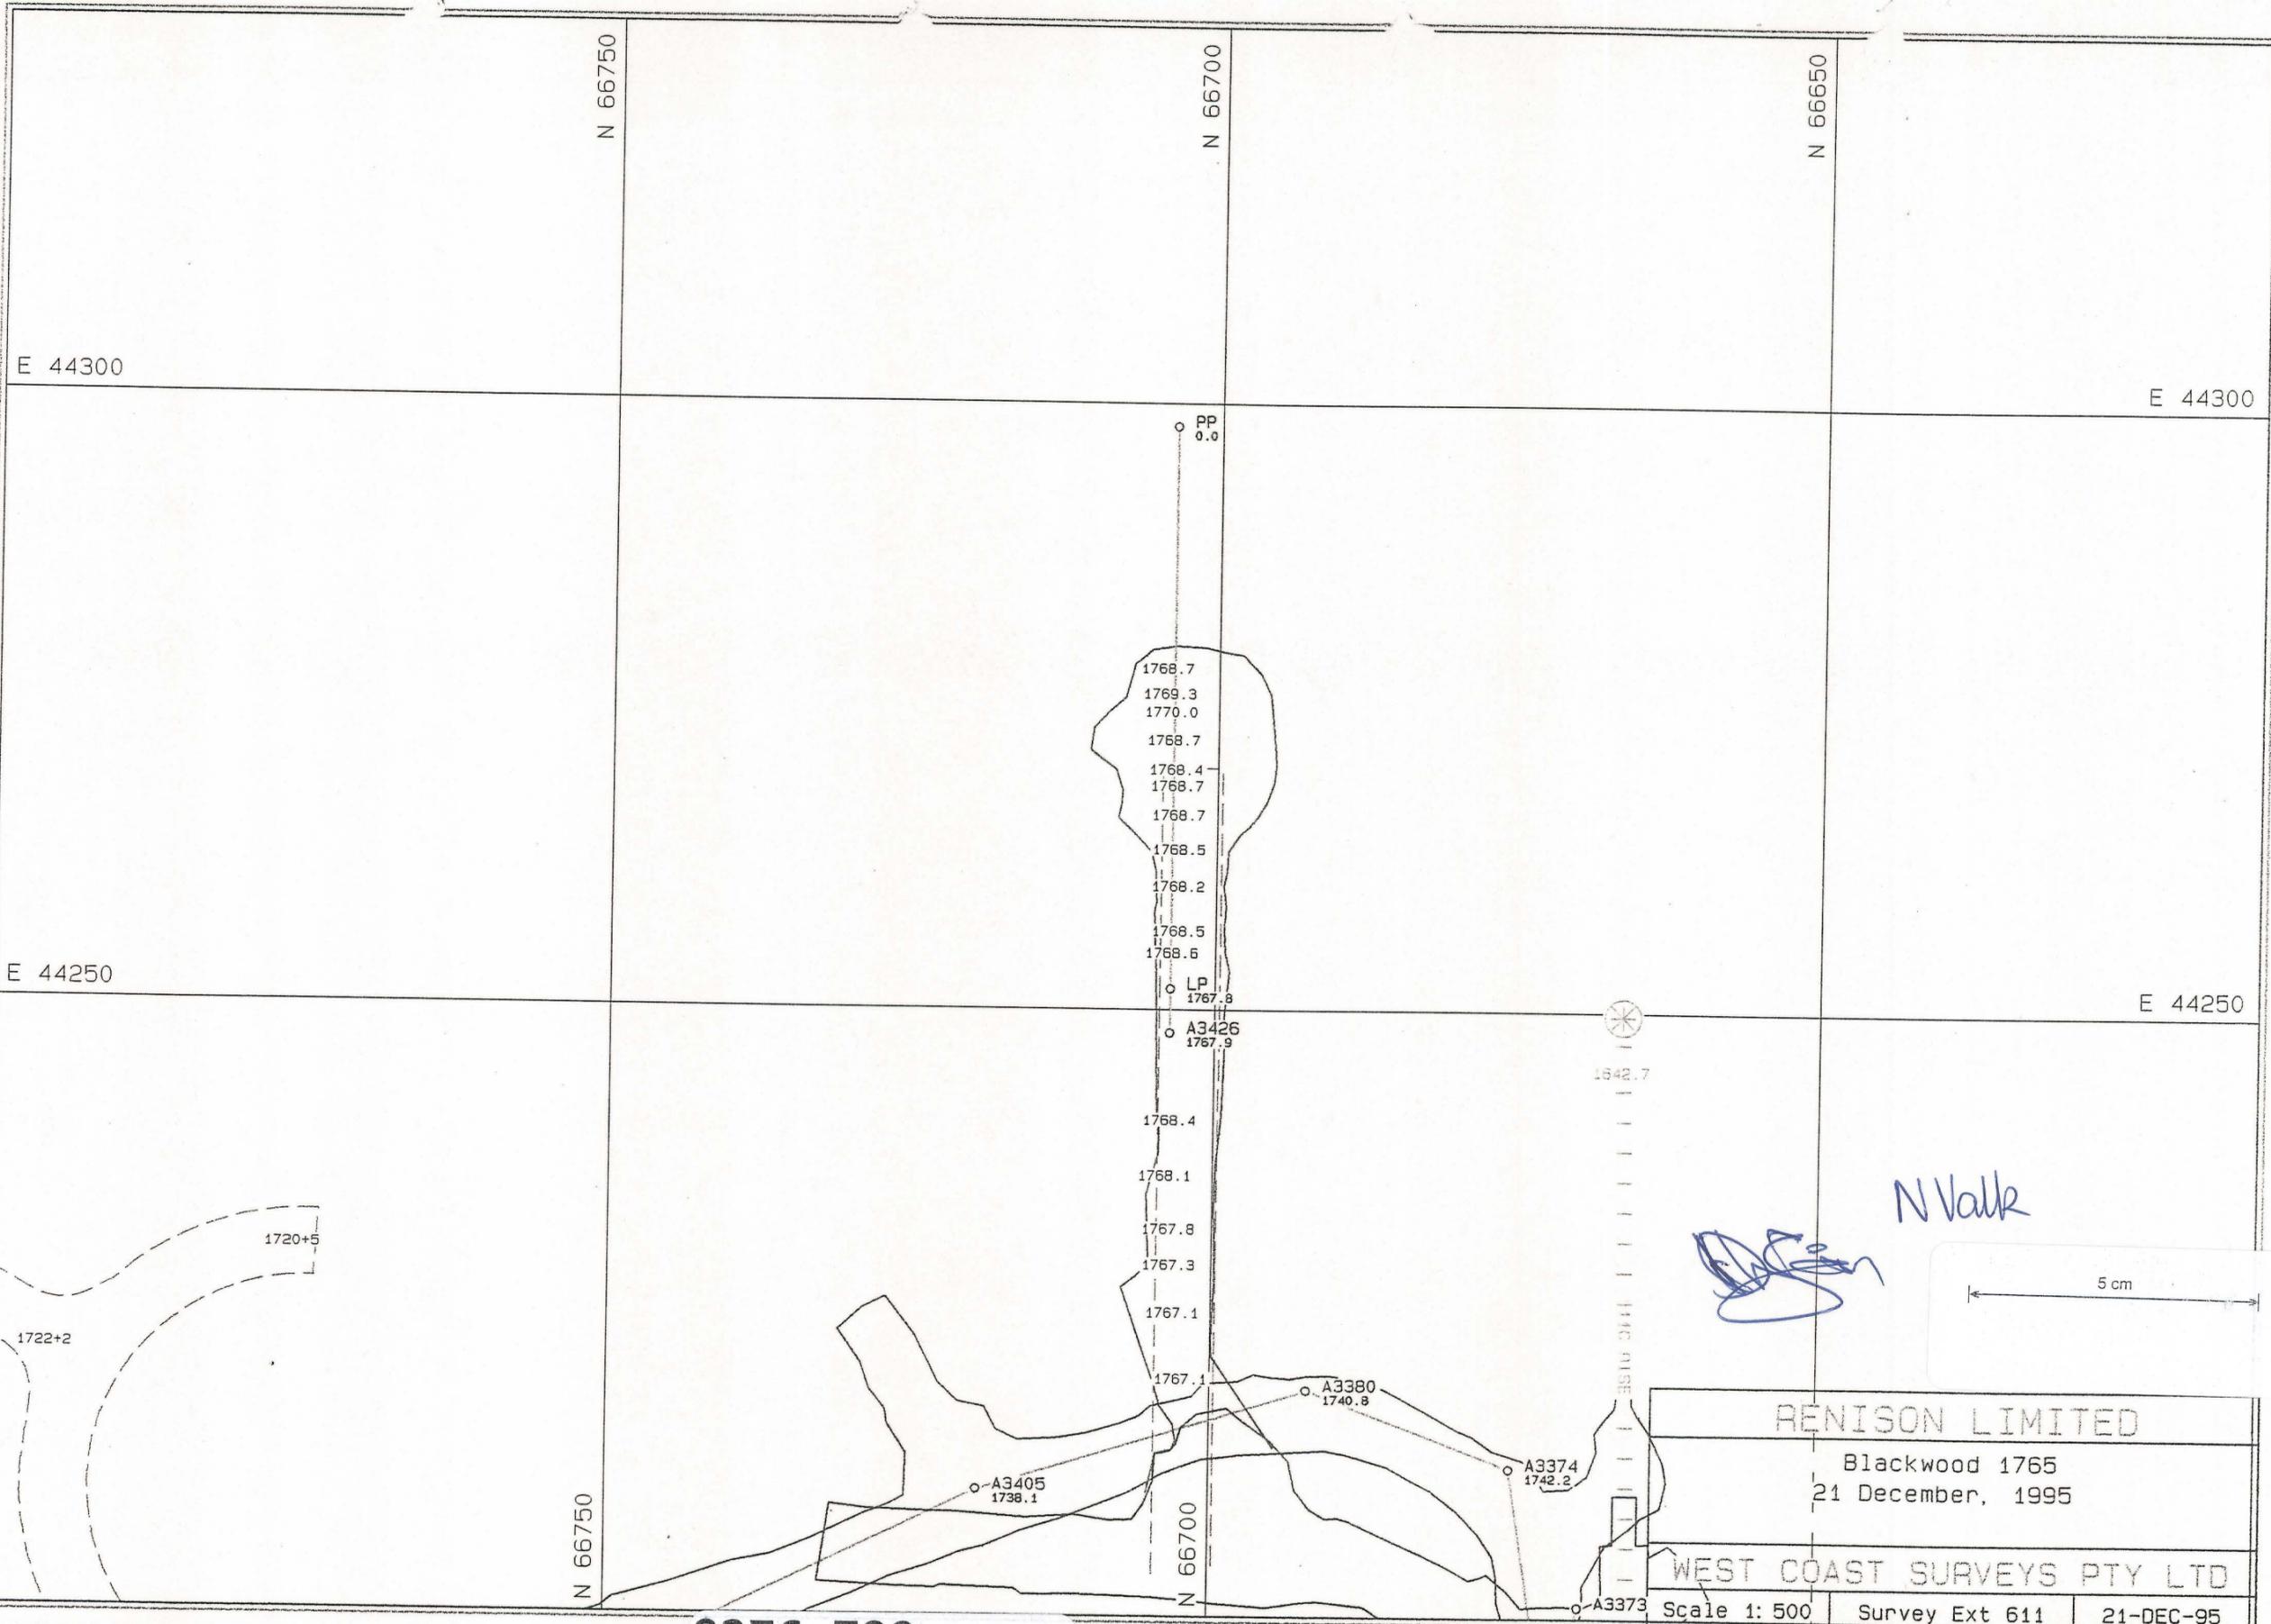

BLACKC.PF

0376\_790

RENISON LIMITED		
Blackwood 1765		
21 December, 1995		
WEST COAST SURVEYS PTY LTD		
Scale 1: 500	Survey Ext 611	21-DEC-95