



0376\_791

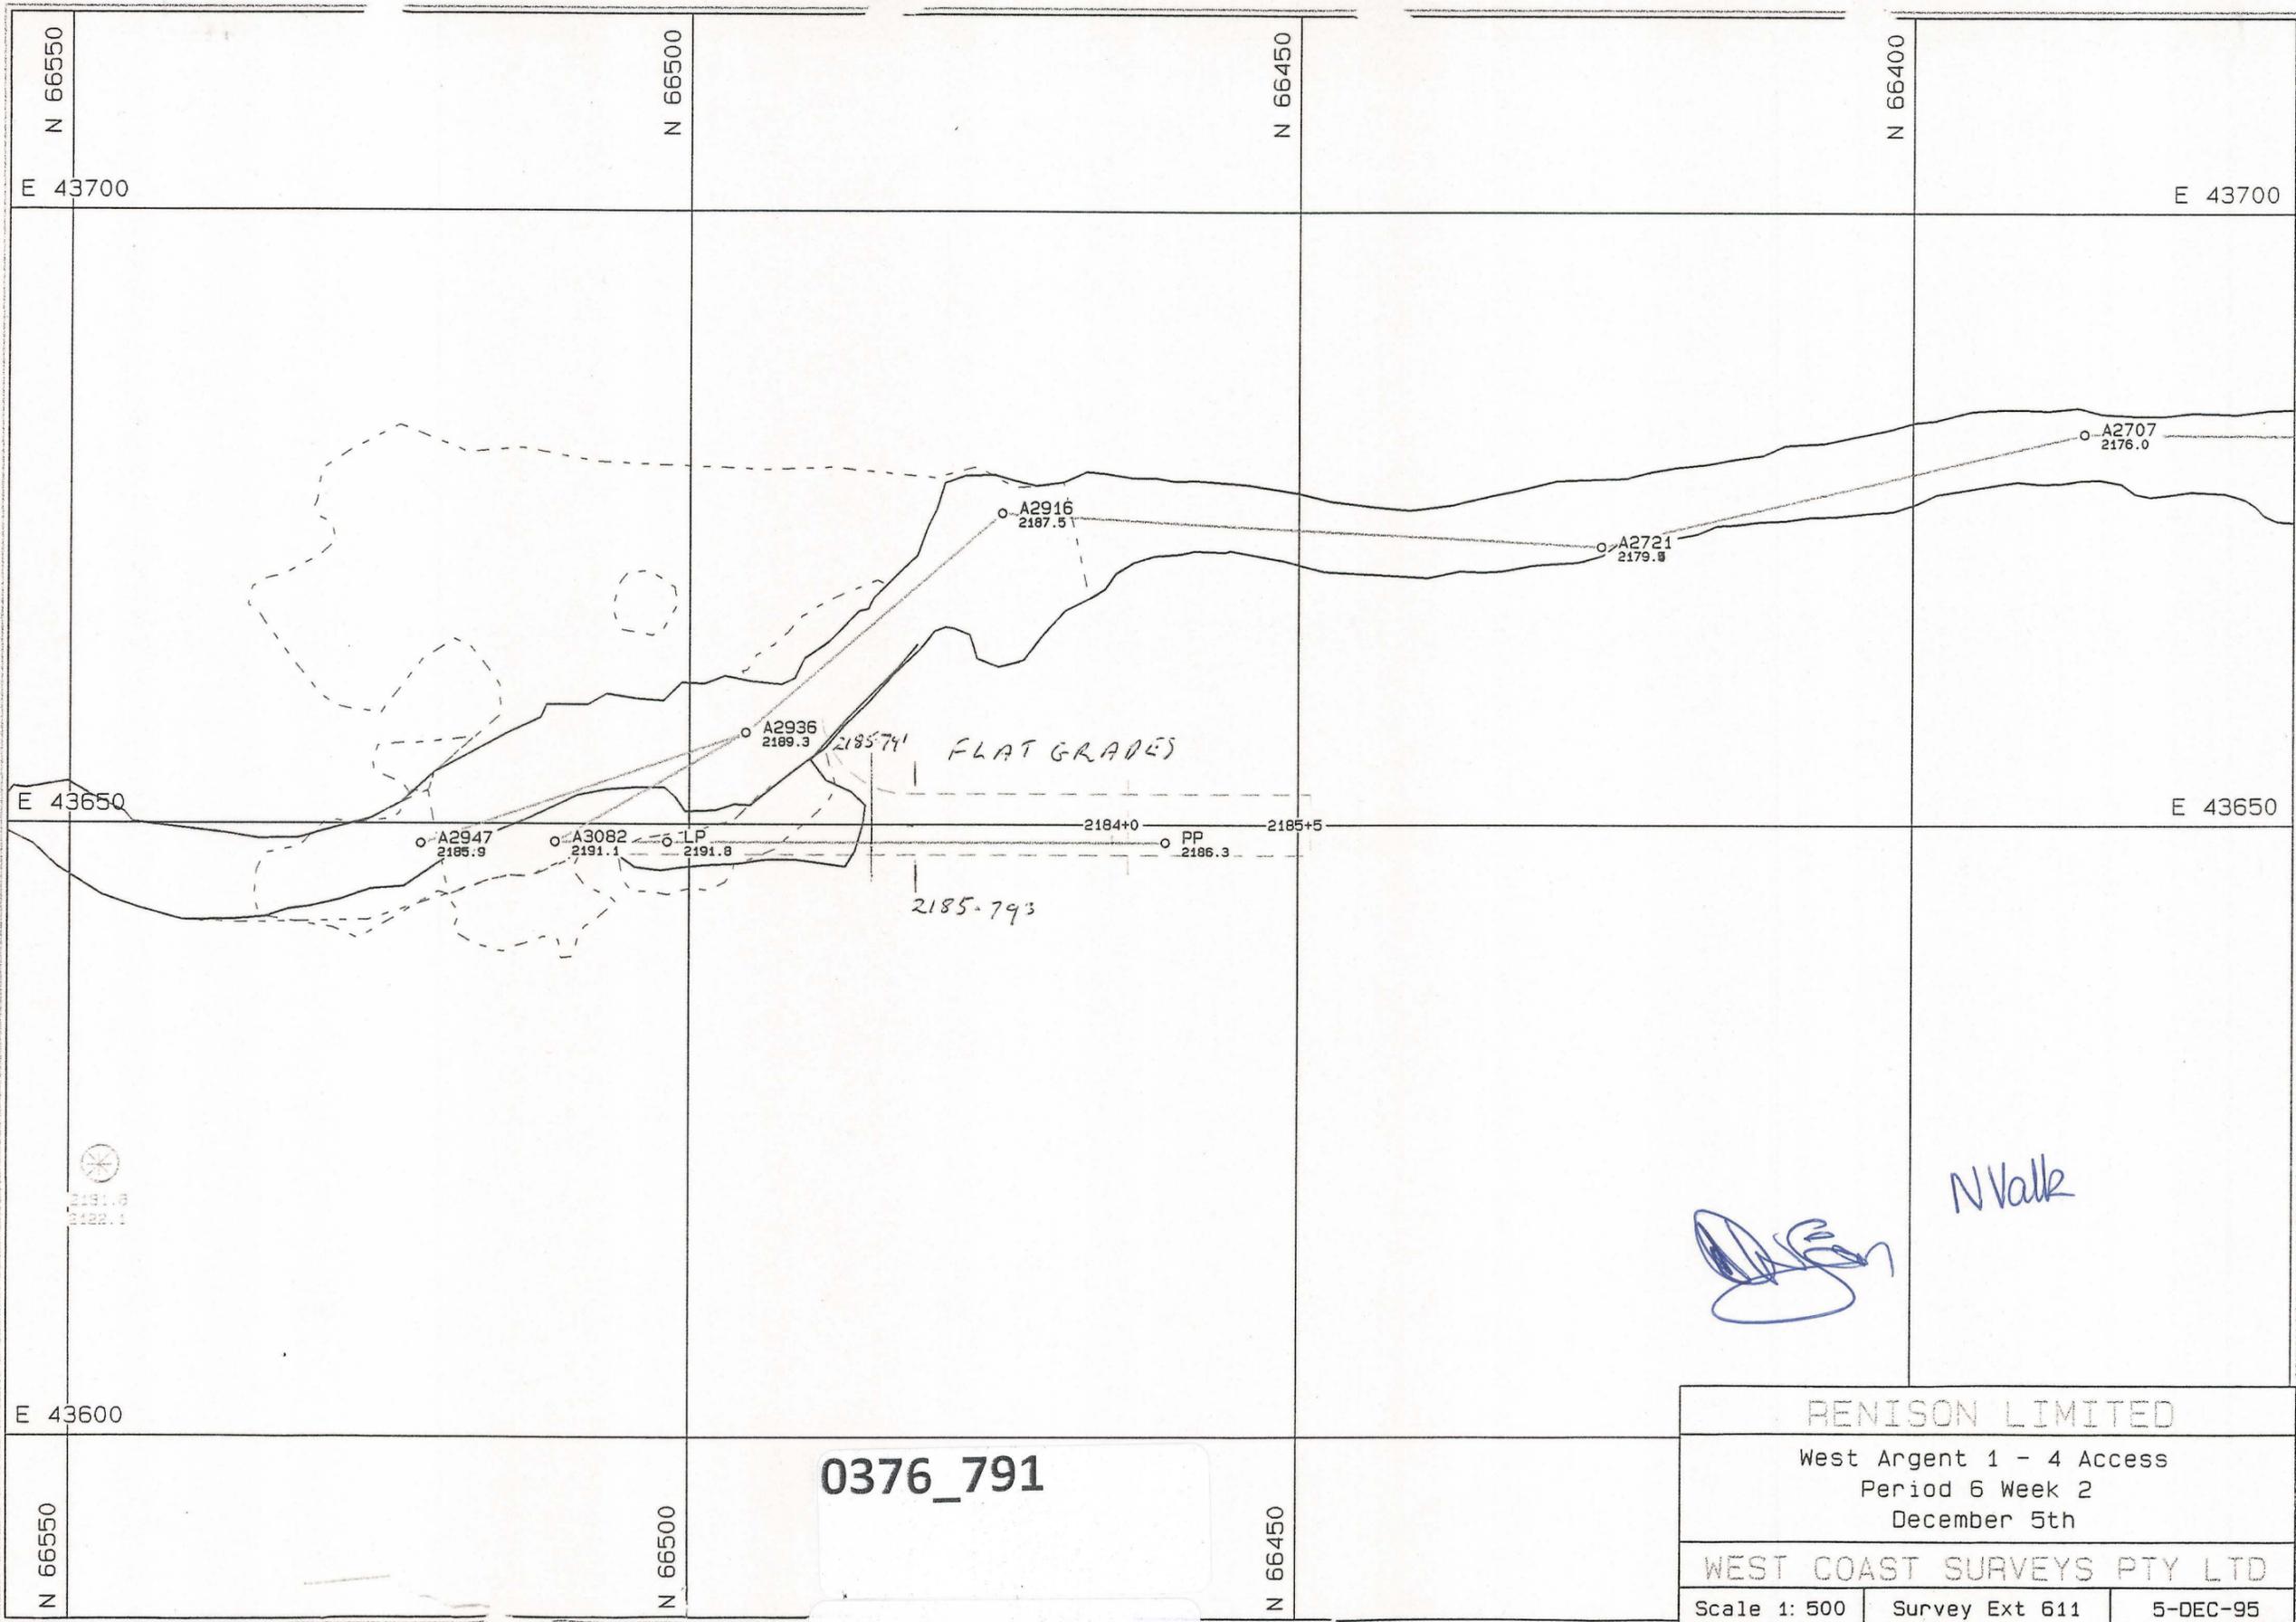

0376\_791

RENISON LIMITED		
West Argent 1 - 4 Access Period 6 Week 2 December 5th		
WEST COAST SURVEYS PTY LTD		
Scale 1: 500	Survey Ext 611	5-DEC-95

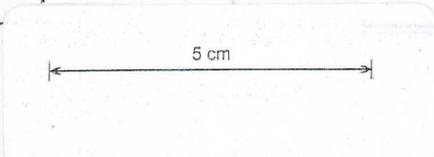

ARGENA .PF