



0376_792

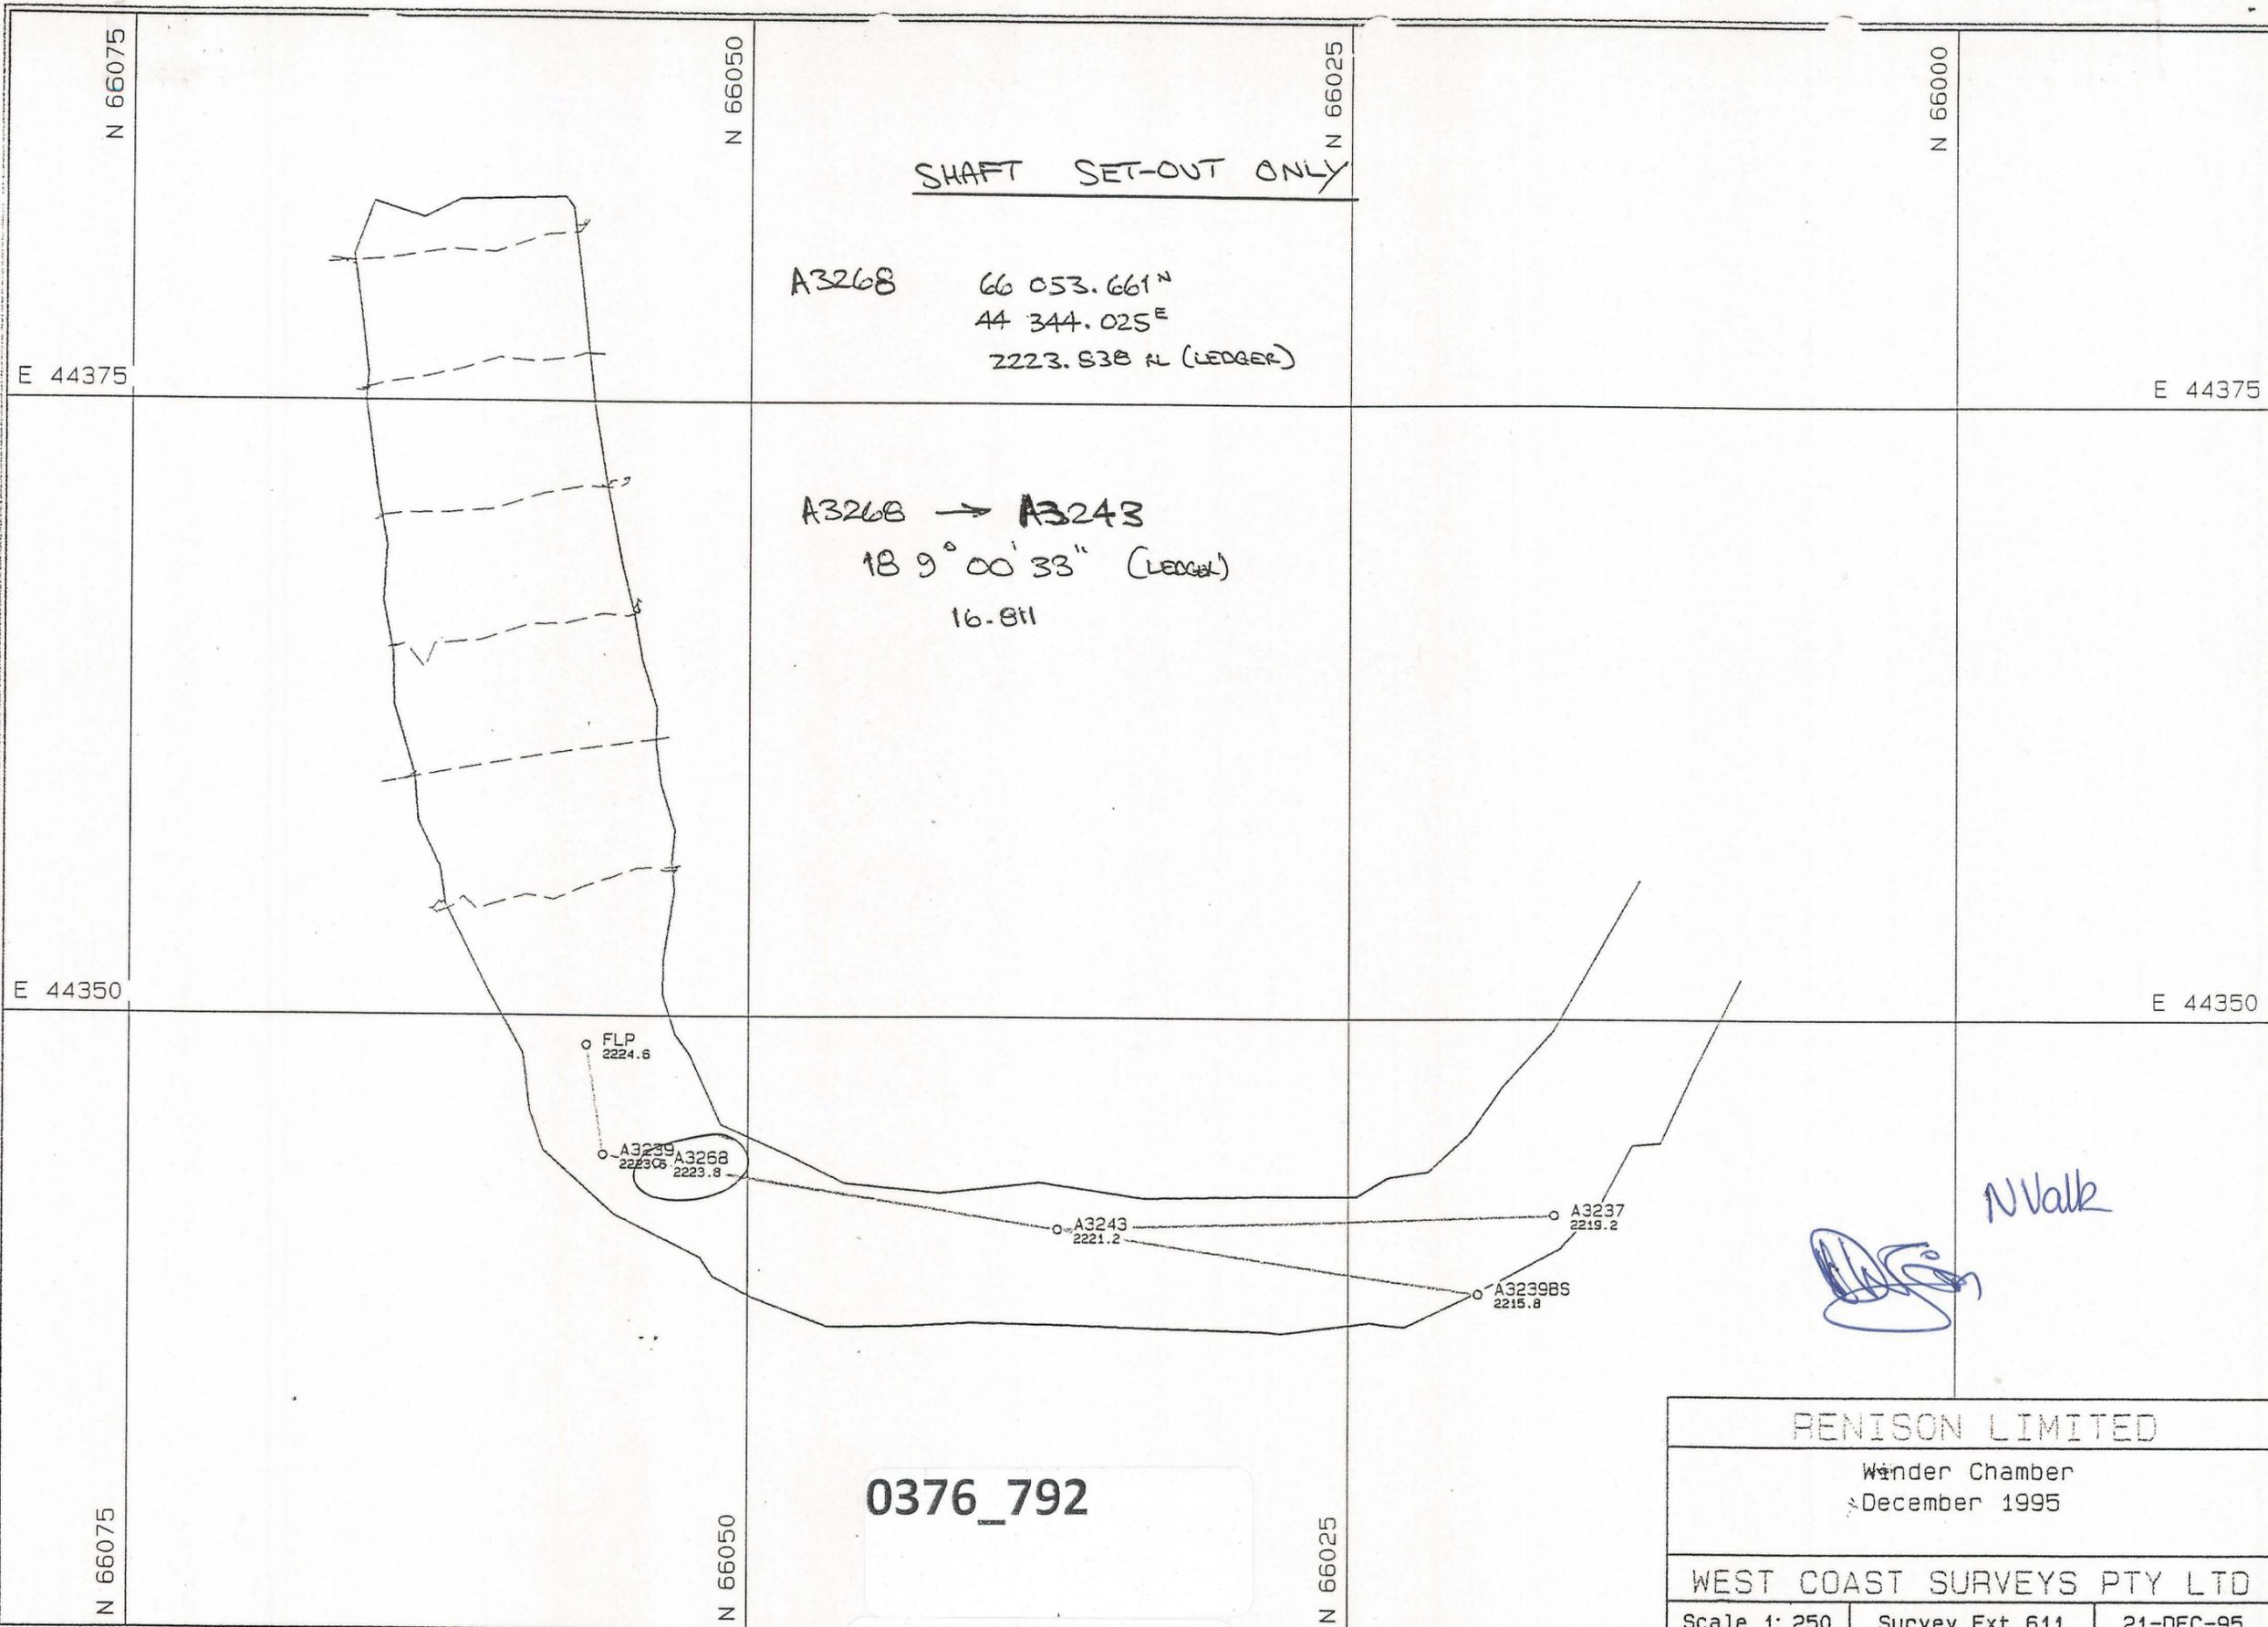

N Valk

0376_792

RENISON LIMITED		
Winder Chamber December 1995		
WEST COAST SURVEYS PTY LTD		
Scale 1: 250	Survey Ext 611	21-DEC-95

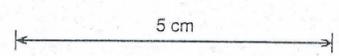

WINDEB.PF