



0376_793

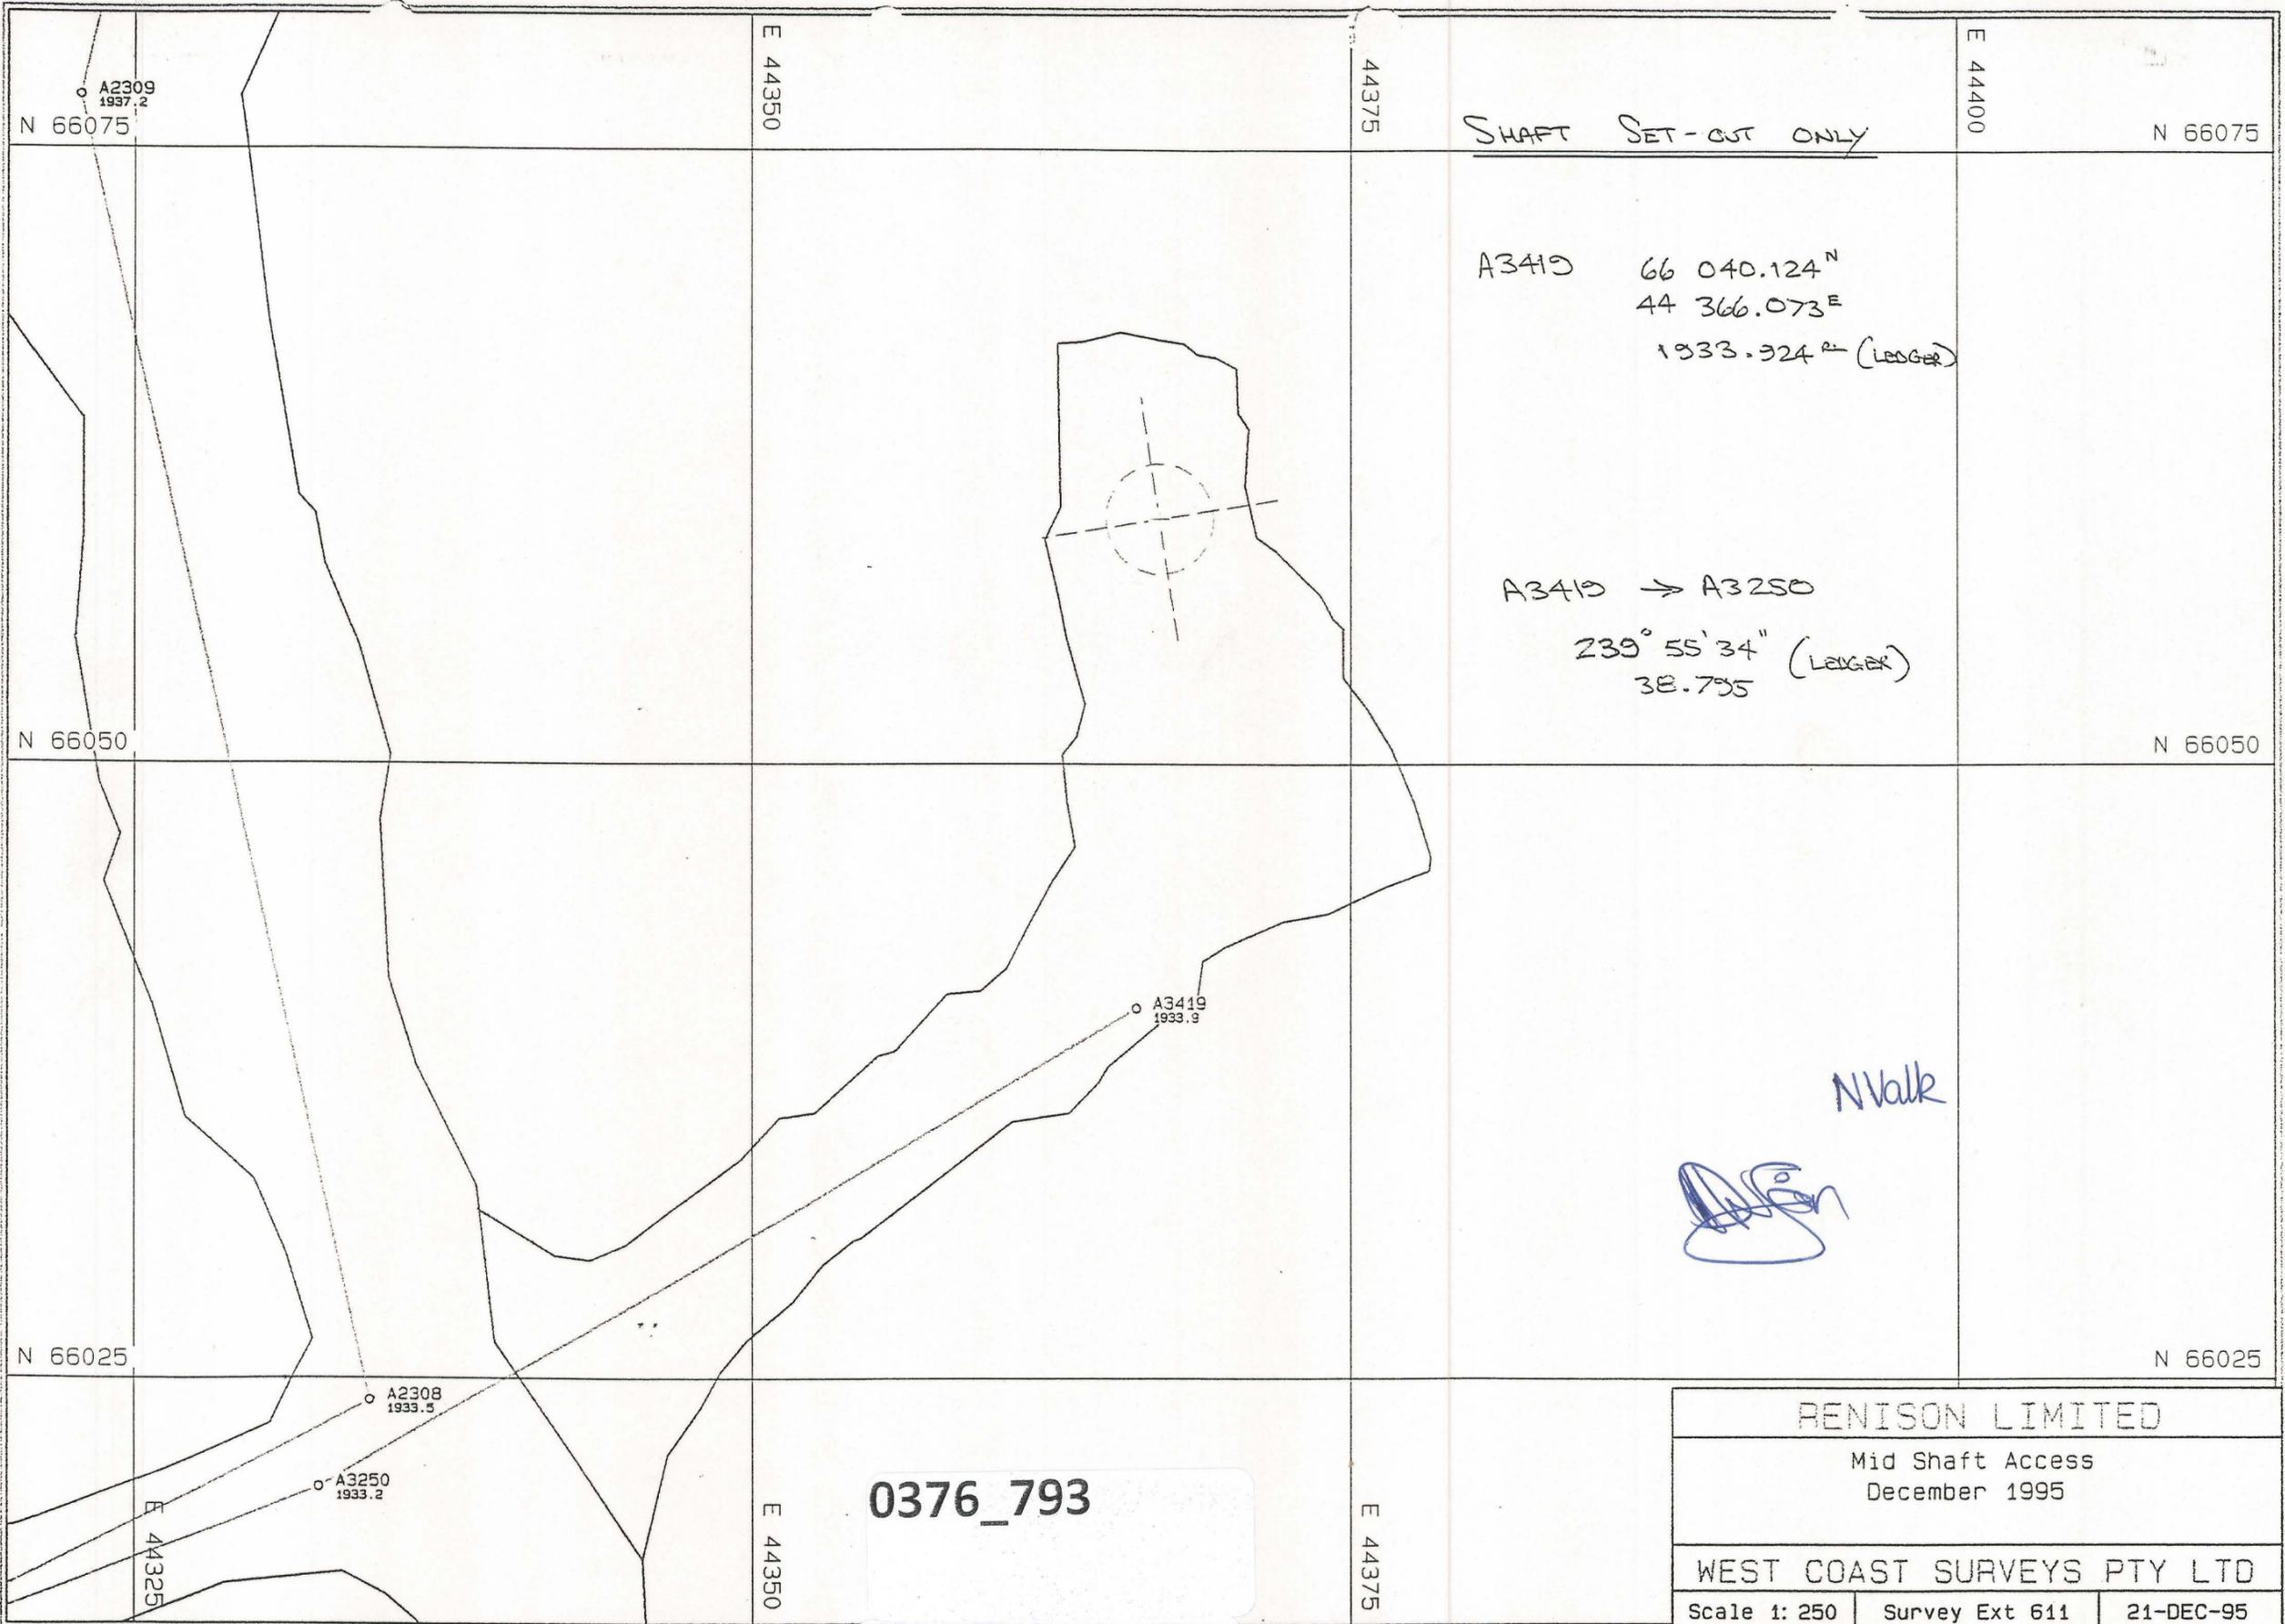

RENISON LIMITED		
Mid Shaft Access December 1995		
WEST COAST SURVEYS PTY LTD		
Scale 1: 250	Survey Ext 611	21-DEC-95

0376_793

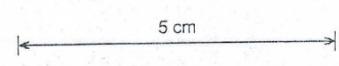

MDSHE.PF