


0376\_795

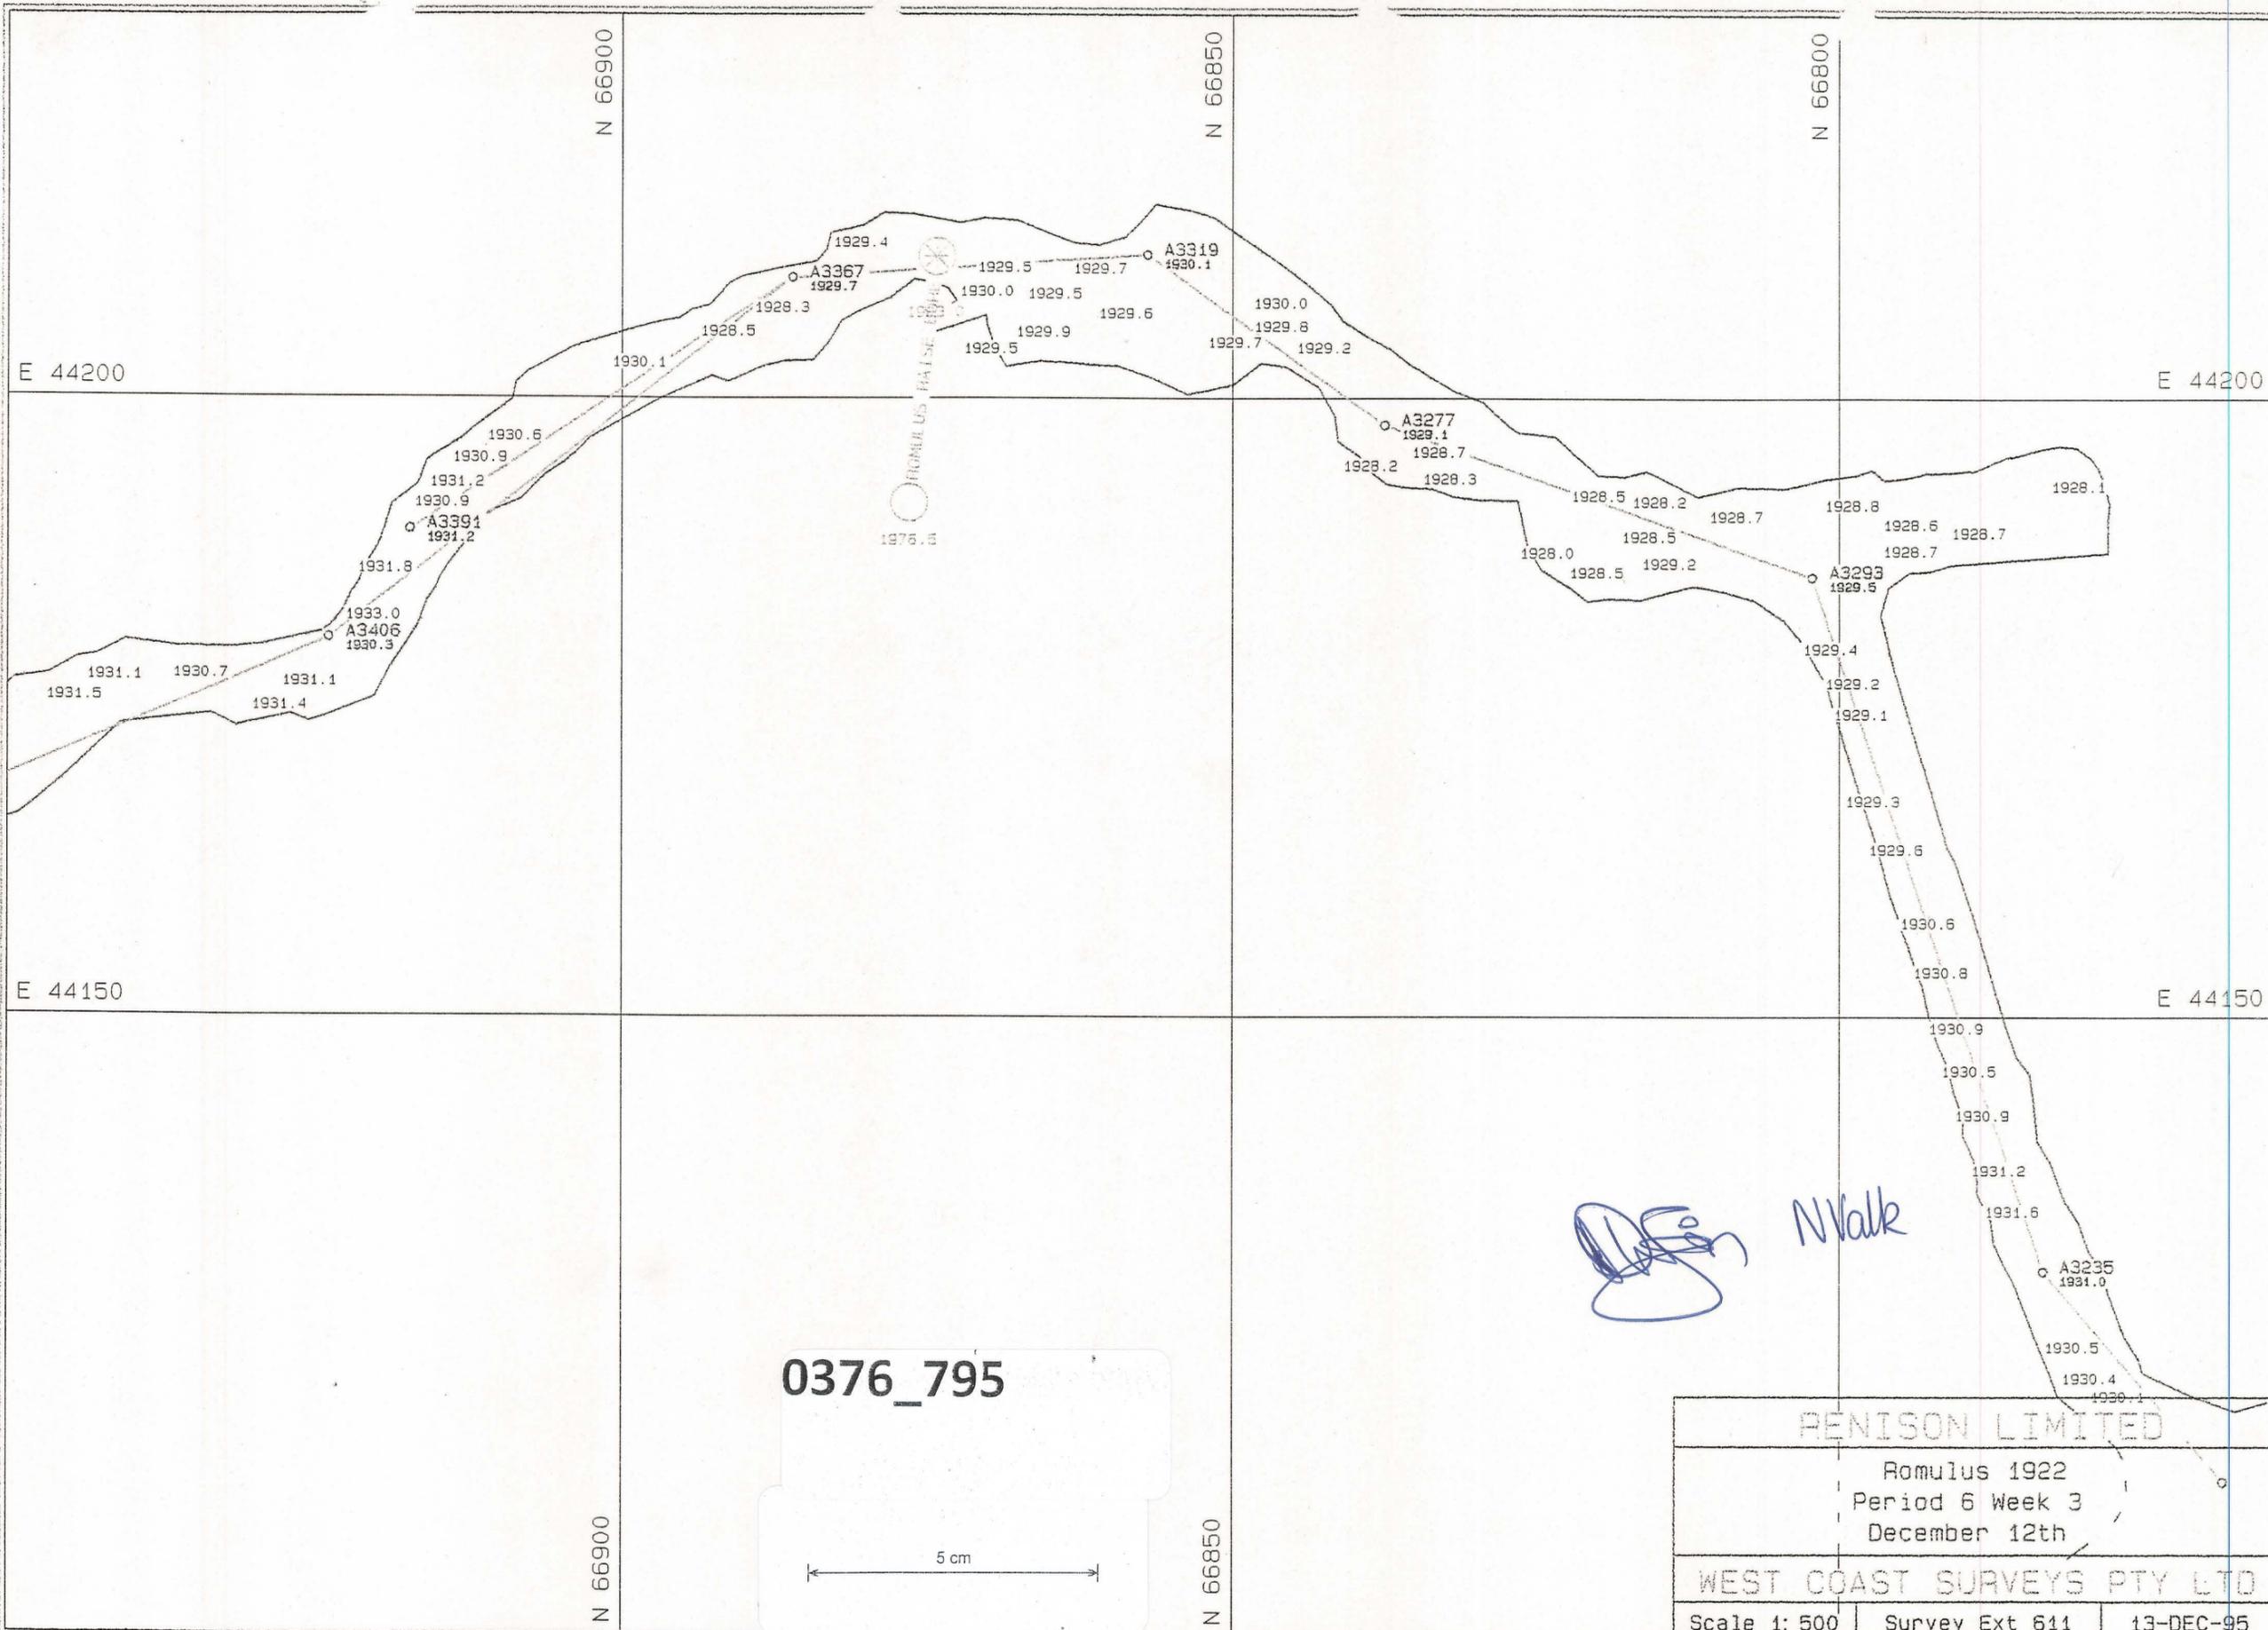

*N Walk*

0376\_795

5 cm

RENISON LIMITED		
Romulus 1922		
Period 6 Week 3		
December 12th		
WEST COAST SURVEYS PTY LTD		
Scale 1: 500	Survey Ext 611	13-DEC-95

ROMULA.PF