

0376_797

E 43800

RENISON LIMITED

Eldon 2 Lift 3
BACK & FILL CONTOURS

SCALE 1: 500

DATE 11-JUL-95

LEVEL

211: 003/02

WEST COAST SURVEYS PTY LTD

Standard flatbacking lift.

N. Valk

Neal Valk




DAVID WILSON

5 cm

0376_797

N 65700

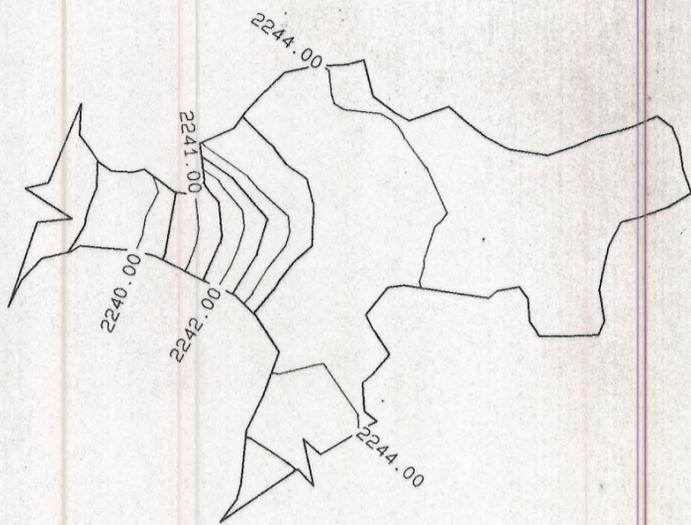

N 65600