



0376_799

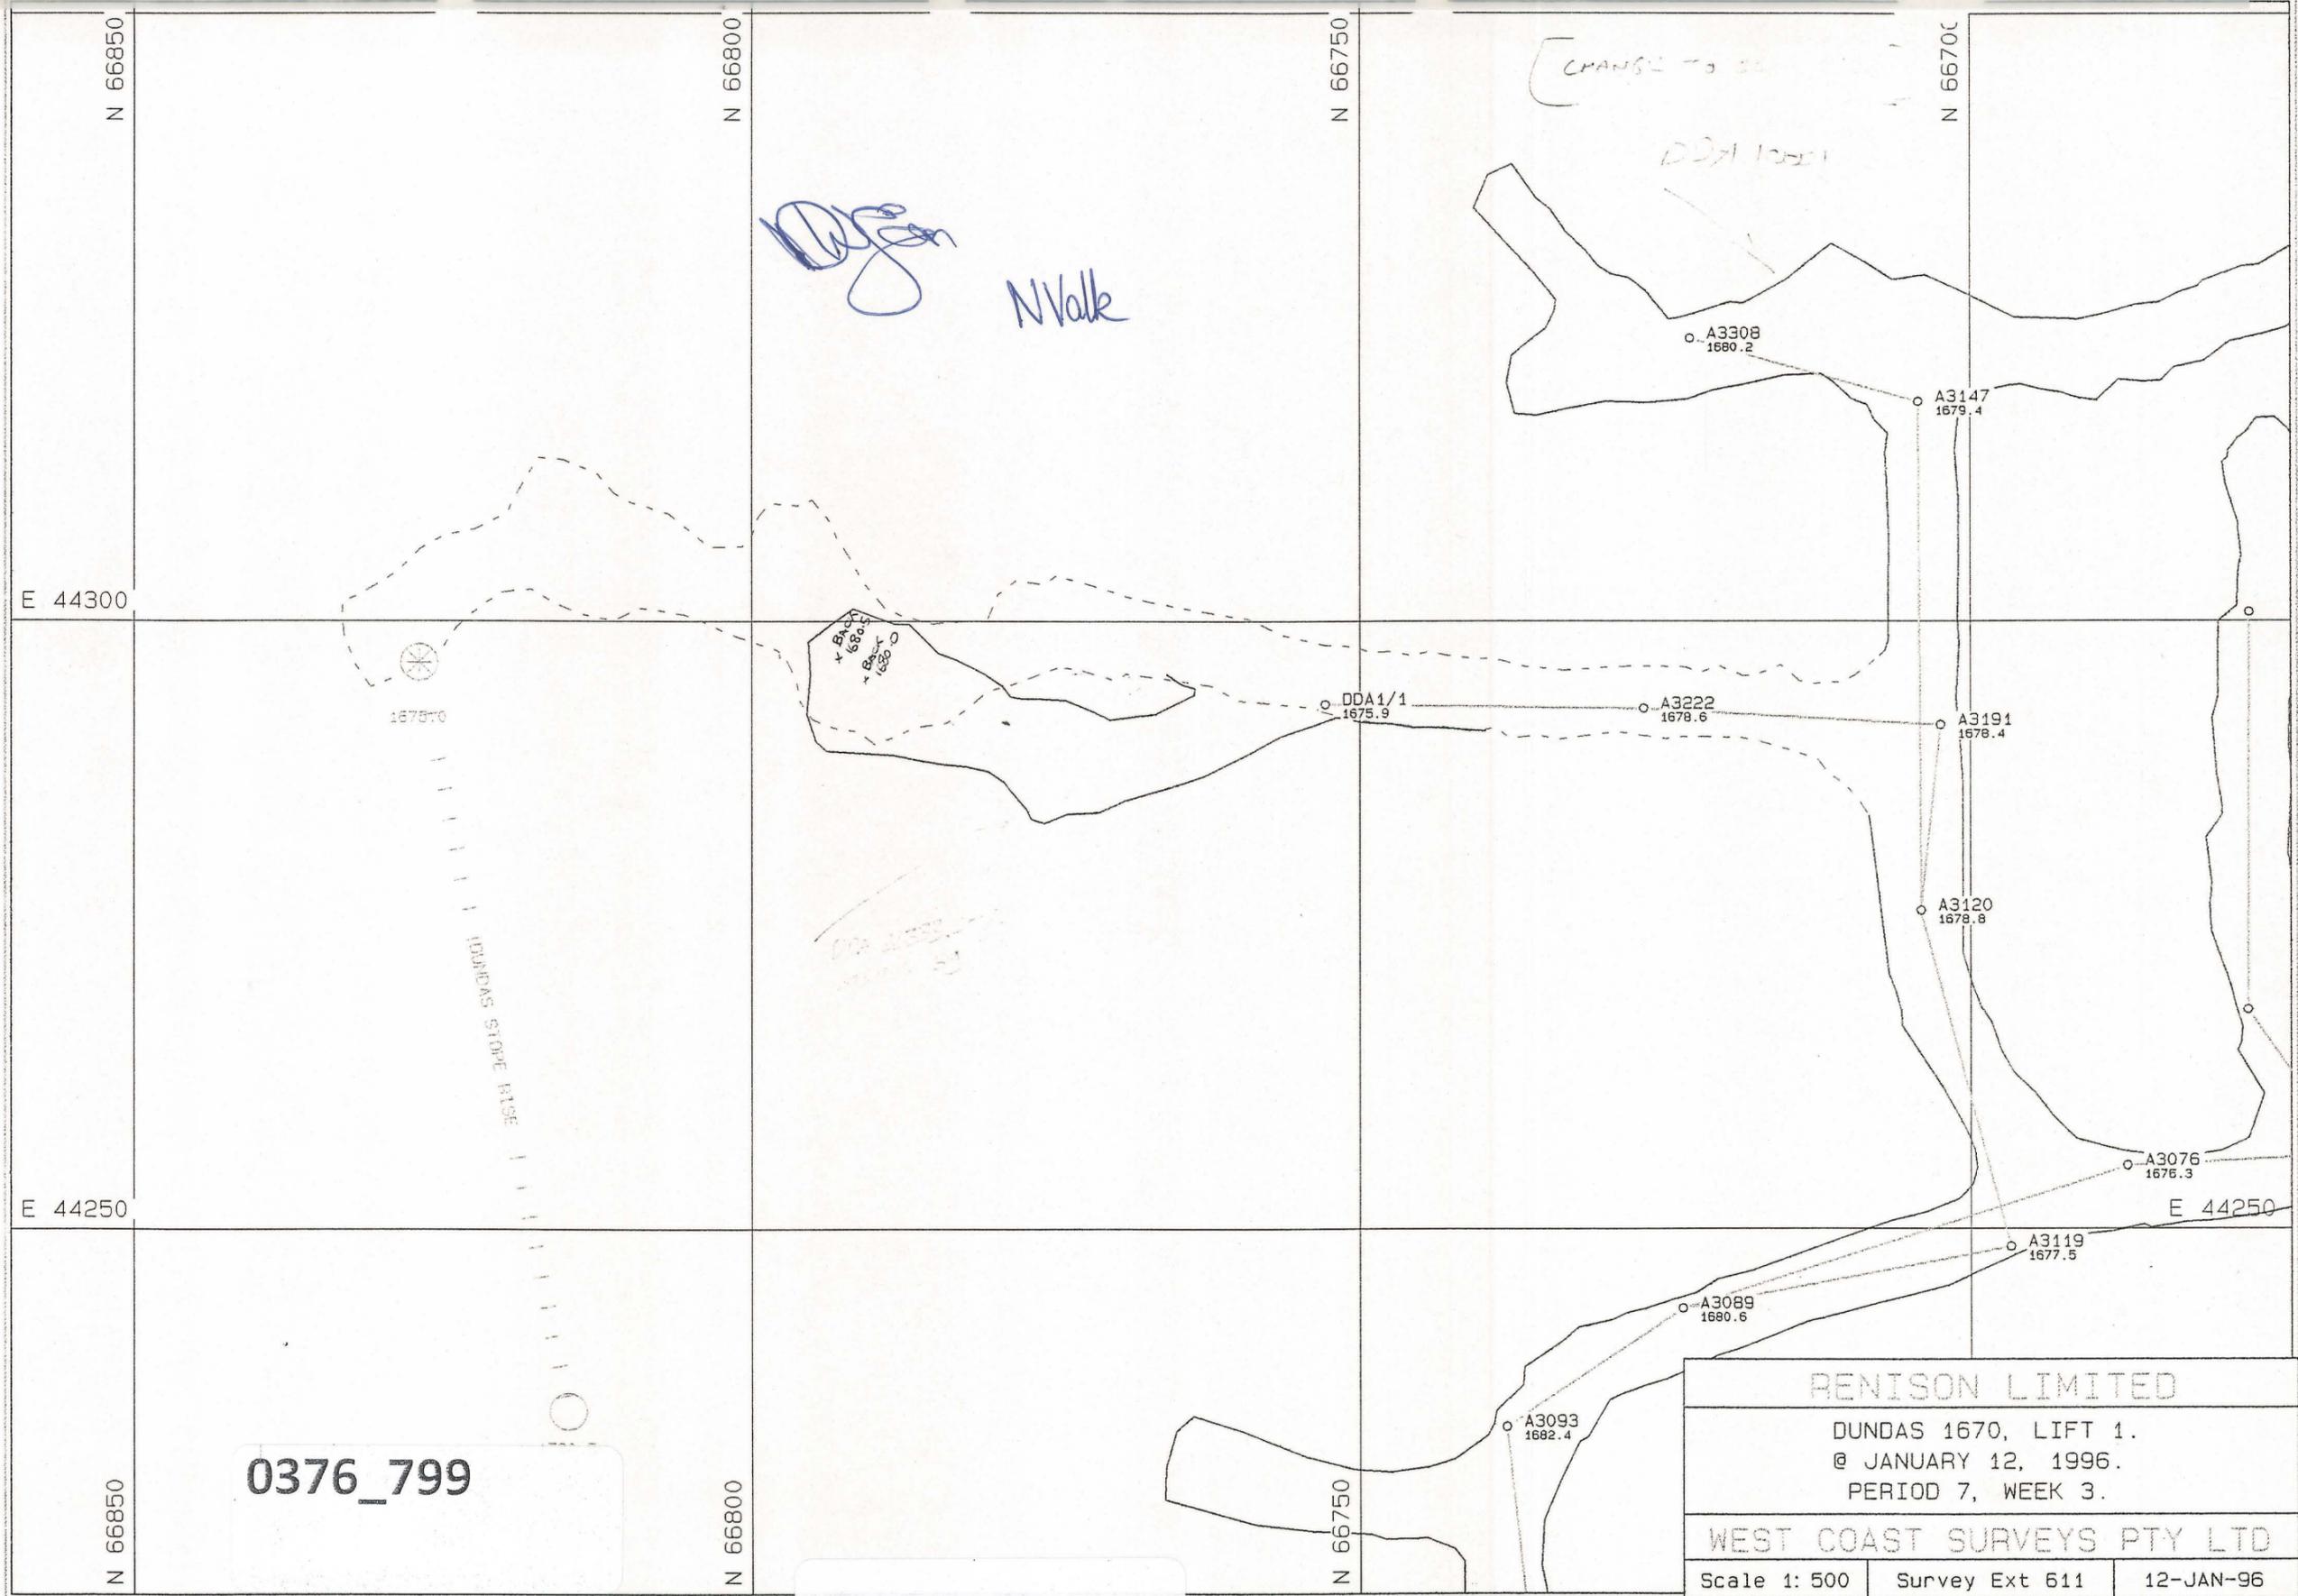

0376_799

RENISON LIMITED		
DUNDAS 1670, LIFT 1.		
@ JANUARY 12, 1996.		
PERIOD 7, WEEK 3.		
WEST COAST SURVEYS PTY LTD		
Scale 1: 500	Survey Ext 611	12-JAN-96

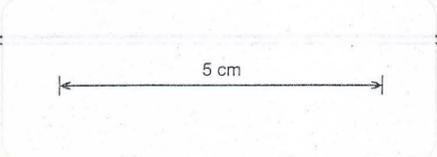

DUNDAA.PF