


0376_800

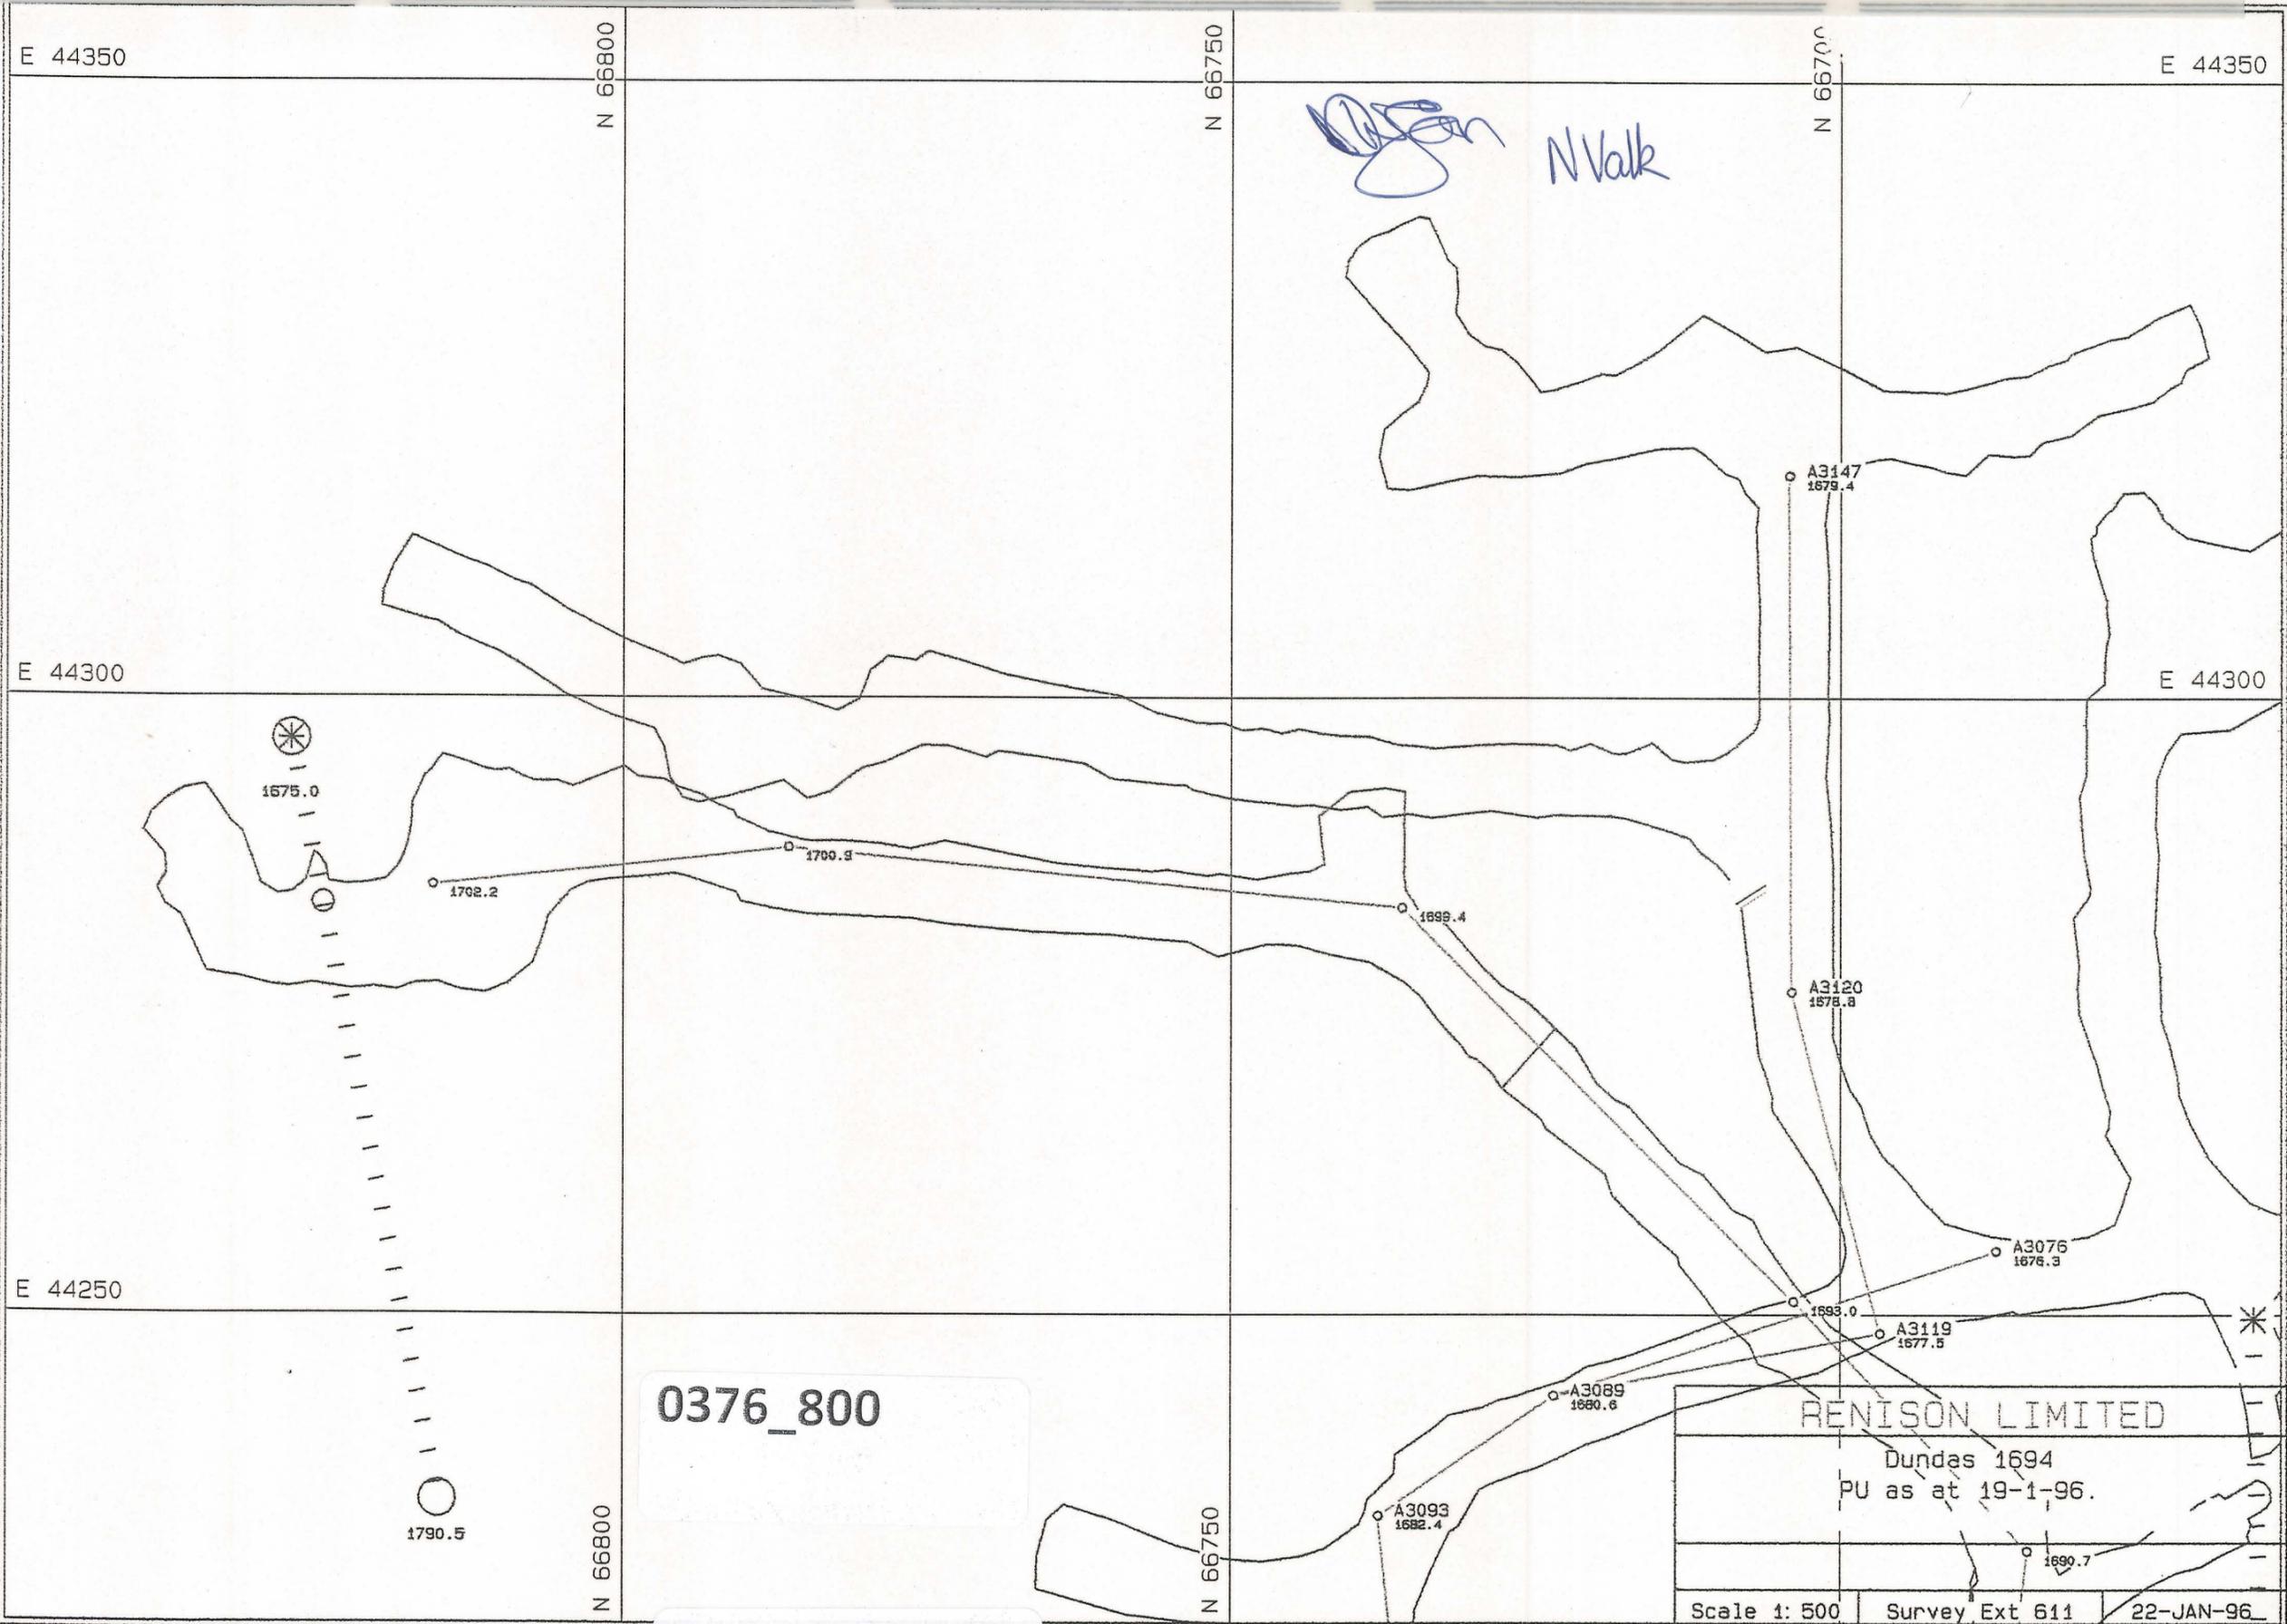

0376_800

RENISON LIMITED

Dundas 1694
PU as at 19-1-96.

Scale 1: 500 | Survey Ext 611 | 22-JAN-96

5 cm

DUNDAA.PF