



0376\_801

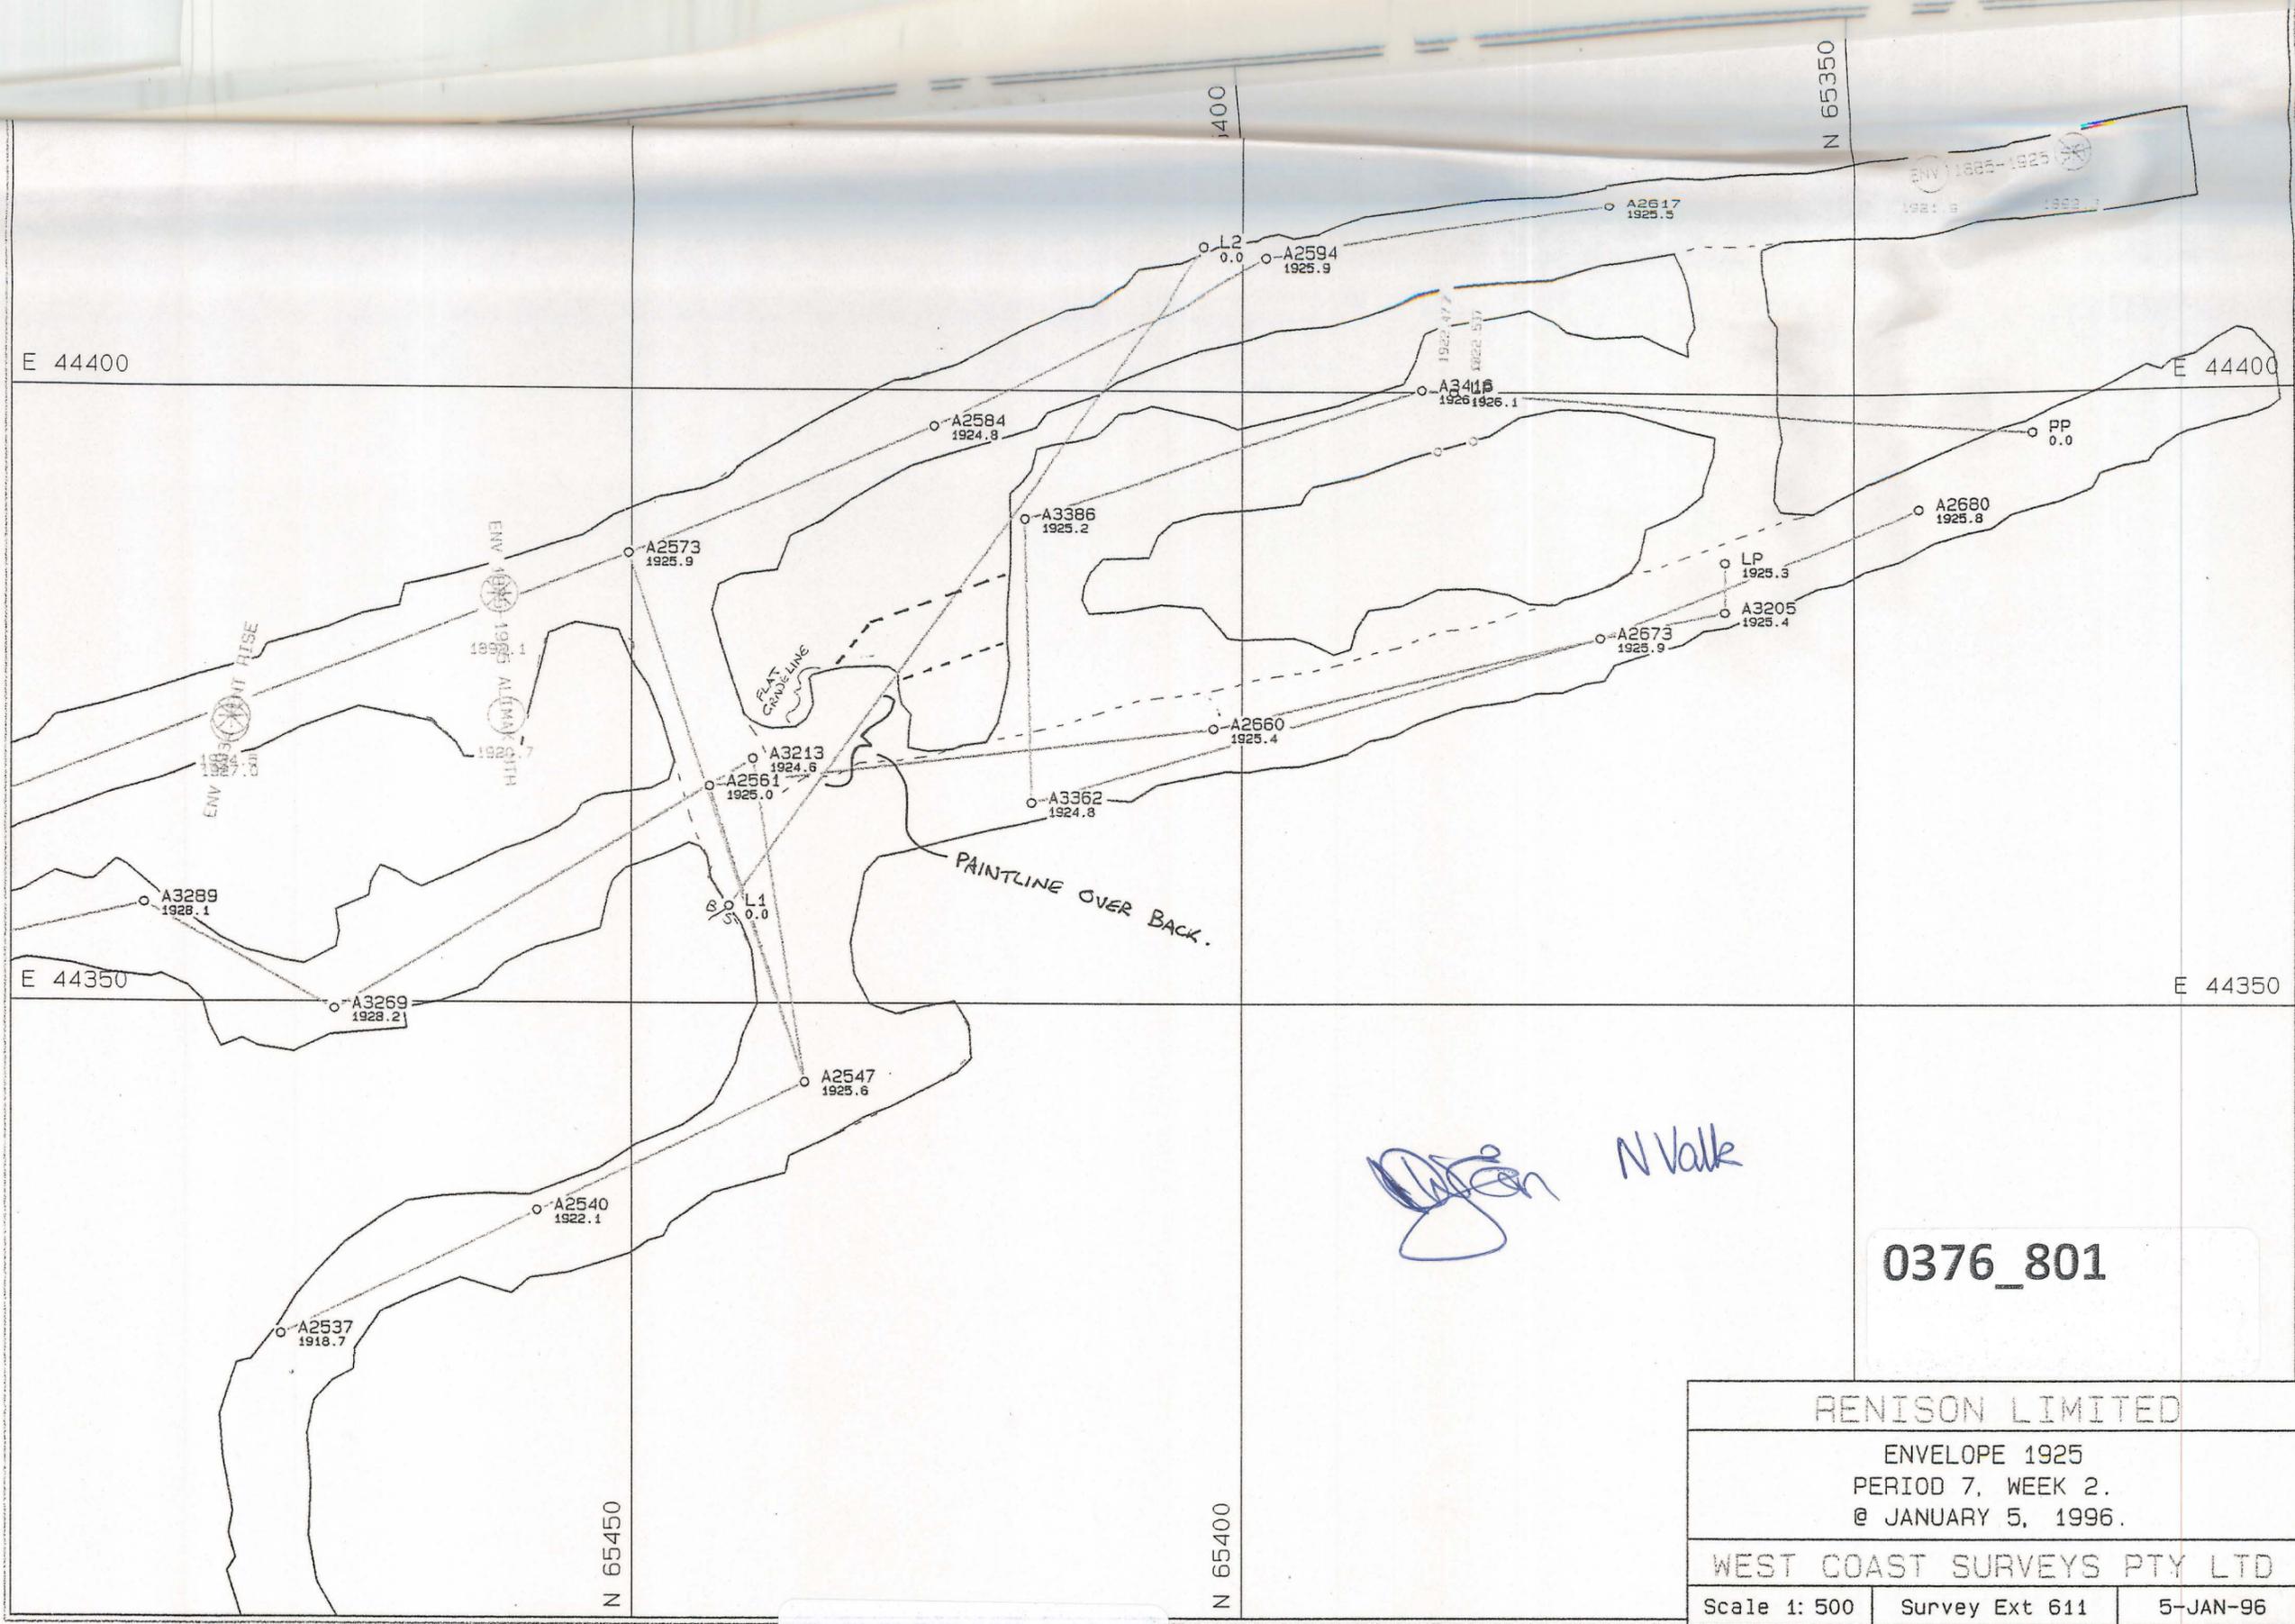

*[Handwritten signature]* N Valk

0376\_801

RENISON LIMITED		
ENVELOPE 1925		
PERIOD 7, WEEK 2.		
@ JANUARY 5, 1996.		
WEST COAST SURVEYS PTY LTD		
Scale 1: 500	Survey Ext 611	5-JAN-96

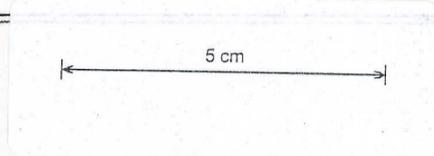

ENVELA.PF