

0376_802

RENISON LIMITED


Envelope 1885 Lift 1
MASTER PLAN

SCALE 1: 500
DATE 21-JAN-96
LEVEL

212: 001/01

WEST COAST SURVEYS PTY LTD

Standard Flatbacking Sill. Mined
from different access to Sill.

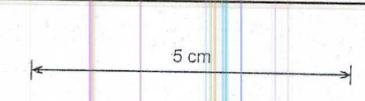

0376_802

N 65400

