

0376\_804

RENISON LIMITED


Sligo 3 Lift 3  
MASTER PLAN

SCALE 1: 500  
DATE 4-JUL-95  
LEVEL

209: 003/1

WEST COAST SURVEYS PTY LTD

RH wall of RHS was stripped. The remainder of RHS is the same as lift 2. LHS is standard flatbacking lift.

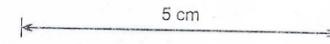

0376\_804

N 66300

43600

*N Walk*  
*[Signature]*

